



Howard County  
Health Department

# APPLICATION

FOR PERCOLATION TESTING AND SITE EVALUATION

EST DATE(S) 4/14/04 to 4/20 TEST TIME 9:00 AP 520082-A  
 AGENCY REVIEW: 7-lot subd; 3A req'd DATE 3/5/04

DO NOT WRITE ABOVE THIS LINE

HEREBY APPLY FOR THE NECESSARY TESTING/EVALUATION PRIOR TO ISSUANCE OF SEWAGE DISPOSAL SYSTEM PERMIT(S) TO:

CHECK AS NEEDED:

- CONSTRUCT NEW SEPTIC SYSTEM(S)
- REPAIR/ADD TO AN EXISTING SEPTIC SYSTEM
- REPLACE AN EXISTING SEPTIC SYSTEM

CHECK AS NEEDED:

- NEW STRUCTURE(S)
- ADDITION TO AN EXISTING STRUCTURE
- REPLACE AN EXISTING STRUCTURE

CHECK ONE:

- CREATE NEW LOT(S)
- BUILD ON AN EXISTING LOT IN A SUBDIVISION
- BUILD ON AN EXISTING PARCEL OF RECORD

IS THE PROPERTY WITHIN 2500' OF ANY RESERVOIR?

- YES
- NO

THE TYPE OF STRUCTURE IS:

- RESIDENTIAL WITH UNKNOWN PROPOSED BEDROOMS IN THE COMPLETED STRUCTURE (NOTE UNKNOWN IF APPROPRIATE)
- COMMERCIAL (PROVIDE DETAIL OF NUMBERS AND TYPES OF EMPLOYEES/ CUSTOMERS ON ACCOMPANYING PLAN)
- INSTITUTIONAL/GOVERNMENT (PROVIDE DETAIL OF NUMBERS AND TYPES OF EMPLOYEES/USERS ON ACCOMPANYING PLAN)

PROPERTY OWNER(S) PRINCE FLORENCE UNDINE

ANYTIME PHONE \_\_\_\_\_ CELL \_\_\_\_\_ FAX \_\_\_\_\_

MAILING ADDRESS \_\_\_\_\_  
 STREET CITY/TOWN STATE ZIP

APPLICANT Hailey Development c/o RICH THOMETZ

ANYTIME PHONE (301) 476-7715 CELL (301) 346-1037 FAX (301) 476-7717

MAILING ADDRESS 3905 NATIONAL DRIVE, SUITE 105, BURTONSVILLE MD. 20866  
 STREET CITY/TOWN STATE ZIP

APPLICANT'S ROLE: DEVELOPER BUILDER BUYER RELATIVE/FRIEND REALTOR CONSULTANT

PROPERTY LOCATION  
 SUBDIVISION/PROPERTY NAME PRINCE PROPERTY LOT NO. 1

PROPERTY ADDRESS END OF HUNTERBROOKE LANE / HUNTFIELD DRIVE  
 STREET TOWN/POST OFFICE

AX MAP PAGE(S) 46 GRID 137 PARCEL(S) 104 PROPOSED LOT SIZE 3 Ac. ±

AS APPLICANT, I UNDERSTAND THE FOLLOWING: THE SYSTEM INSTALLED SUBSEQUENT TO THIS APPLICATION IS ACCEPTABLE ONLY UNTIL PUBLIC SEWERAGE IS AVAILABLE. THIS APPLICATION IS COMPLETE WHEN ALL APPLICABLE FEES AND A SUITABLE SITE PLAN HAVE BEEN RECEIVED. I ACCEPT THE RESPONSIBILITY FOR COMPLIANCE WITH ALL M.O.S.H.A. AND "MINIMUM UTILITY" REQUIREMENTS. APPROVAL IS BASED UPON SATISFACTORY REVIEW OF A PERC CERTIFICATION PLAN.


TEST RESULTS WILL BE MAILED TO APPLICANT. Zacharia G-Fisch (agent for Developer)  
 SIGNATURE OF APPLICANT

HOWARD COUNTY HEALTH DEPARTMENT, BUREAU OF ENVIRONMENTAL HEALTH, WELL AND SEPTIC PROGRAM  
 3525-H ELLICOTT MILLS DRIVE, ELLICOTT CITY, MARYLAND 21043-4544 (410) 313-1771 FAX (410) 313-2648  
 TDD (410) 313-2323 TOLL FREE 1-877-4MD-DHMH

AP

602 601 600

orge brn  
hvy lm  
3  
4  
lt. brn  
tan orge  
sa lm  
10-15%  
12 frags  
13 1/2

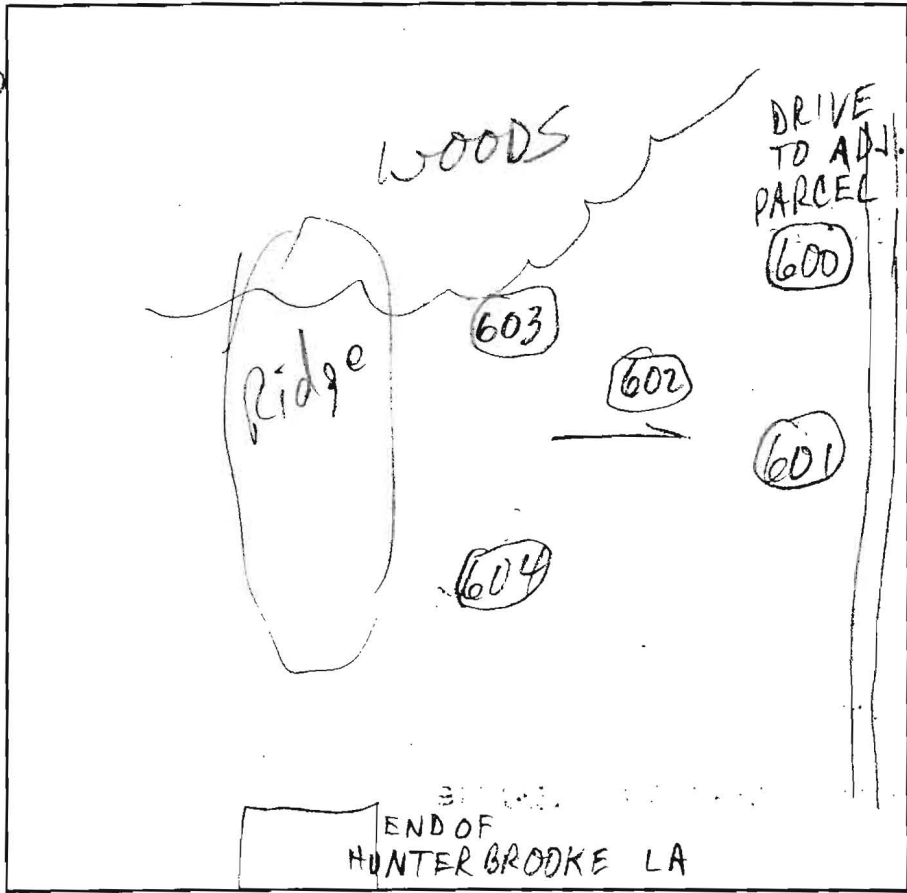

604

orge  
sac lm  
2  
orge brn  
hvy lm  
5

brn orge  
pink  
sa lm  
15-20%  
13 frags

603

orge  
brn  
hvy lm  
5 1/2

tan brn  
sa lm  
10-15%  
13 frags

DATE	TEST #	DEPTH	START	BREAK 1' DROP	STOP 2' DROP	TIME OF 2ND INCH	P/F/H
4/14/04	602 S	5 / 13	9:51	9:53	9:55	2	P
	601 S	4 / 13 1/2	9:56	10:02 FASTER 1'	10:17 BELOW	15	P
	600 V	12					P
	603 V	13					P
	604 V	7' 9" / 13	10:16:45	10:23	10:29	6	P

REMARKS ALL PER PLAN

SANITARIAN M. Riskin BACKHOE K&K OTHERS Hailey Dev  
 TEST HOLES USED IN SDA ALL AVG. PERC TIME 8 SQ. FT/BR 180  
 TRENCH WIDTH 2 INLET DEPTH 4 MAX. BOT DEPTH 8 EFFECTIVE SW 2-3

