
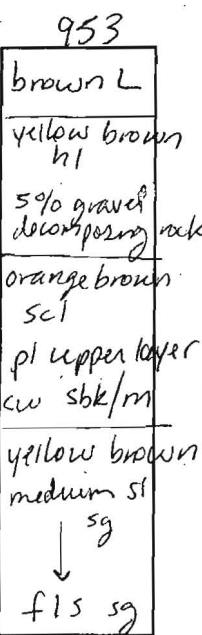
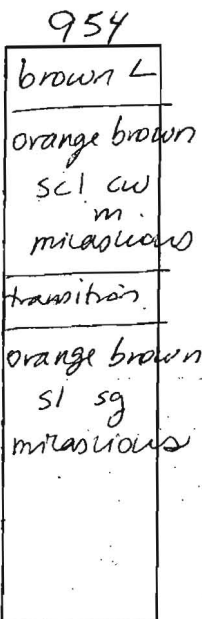
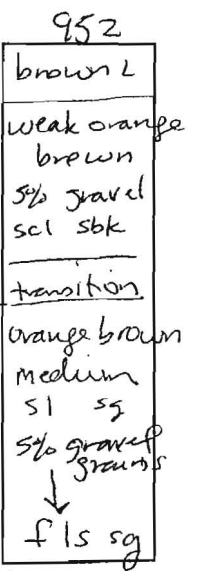
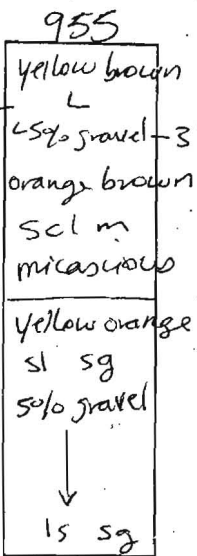
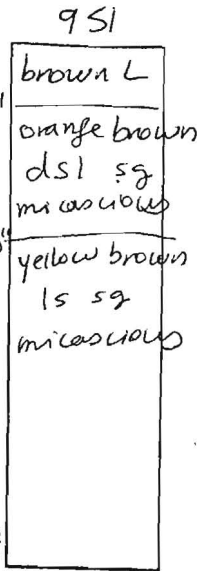
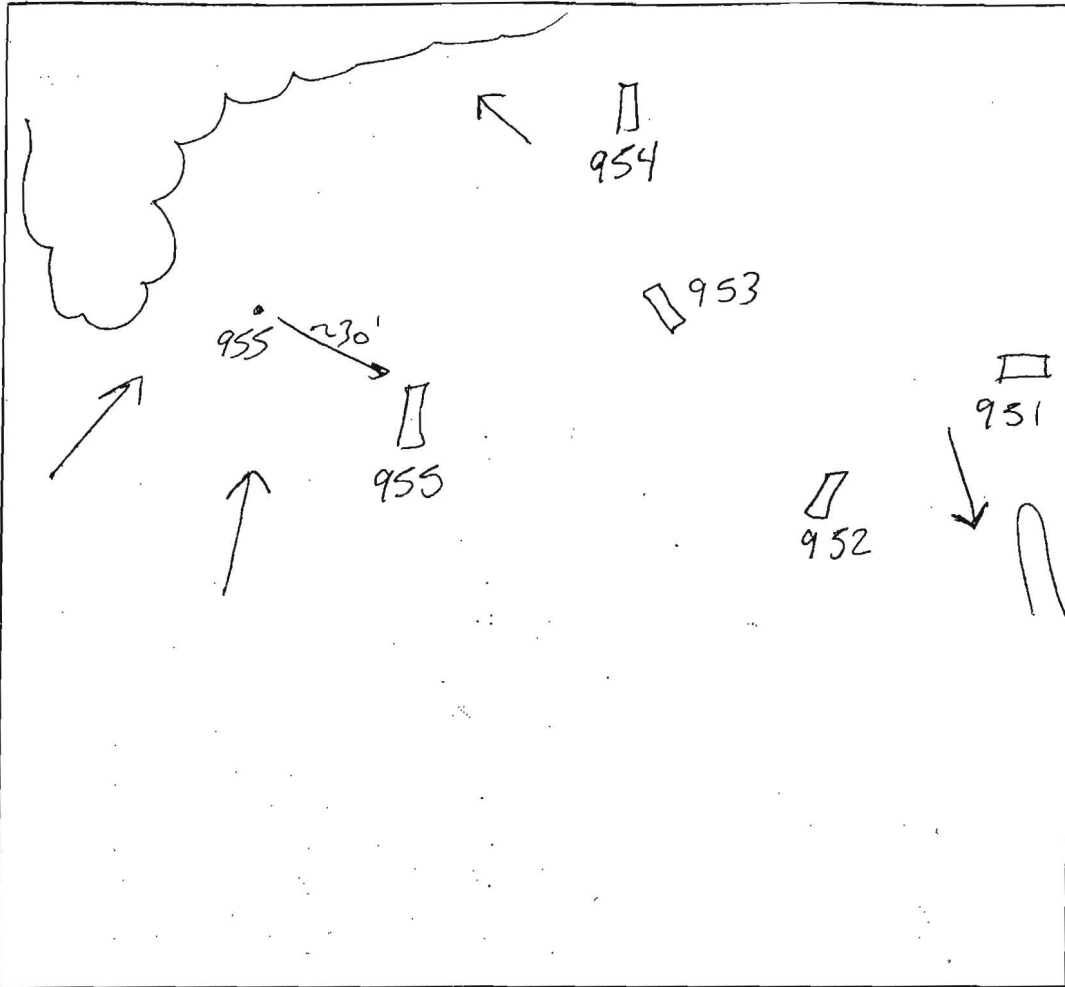


Lot 48/49

A/P

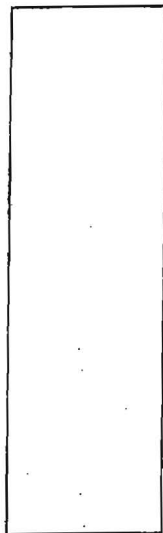

DATE	TEST #	DEPTH	START	BREAK 1" DROP	STOP 2" DROP	TIME OF 2nd INCH	P/F/H
9/20/05	953	8'5" / 15'	10:04	10:09	10:17	8	P
	954	9' / 15'	10:31 10:34 ⁵⁰	10:31 ⁵² 10:36 ⁴⁶	10:33 ⁰⁸ 10:38	-	-
			10:39 ⁰⁵	10:40 ⁴¹	10:42 ⁵⁰	2	P
	955	8' / 14'	11:08	11:09 ⁵⁰	11:12	3	P
	952	8' / 15'	11:33 ⁵⁷	11:34 ⁴²	11:36 ⁵⁰	2	P
	951	6' / 15'	12:07 ⁵ 12:10 ¹⁰	12:08 ¹⁰ 12:11 ³²	12:09 ³⁰ 12:13 ³³	2	P

REMARKS #955 adjusted depth before dug due to poor location

SANITARIAN SF/KJB BACKHOE Mike J (AEC) OTHERS Bob Sheeley

TEST HOLES USED IN SDA _____ AVG. PERC TIME 3.4 SQ. FT/BR _____

TRENCH WIDTH _____ INLET DEPTH _____ MAX. BOT DEPTH _____ EFFECTIVE S/W _____