

APPLICATION

FOR PERCOLATION TESTING AND SITE EVALUATION

TEST DATE(S) _____ TEST TIME _____

AP 520082-C

AGENCY REVIEW: _____

DATE 3/5/04

DO NOT WRITE ABOVE THIS LINE

HEREBY APPLY FOR THE NECESSARY TESTING/EVALUATION PRIOR TO ISSUANCE OF SEWAGE DISPOSAL SYSTEM PERMIT(S) TO:

CHECK AS NEEDED:

- CONSTRUCT NEW SEPTIC SYSTEM(S)
- REPAIR/ADD TO AN EXISTING SEPTIC SYSTEM
- REPLACE AN EXISTING SEPTIC SYSTEM

CHECK AS NEEDED:

- NEW STRUCTURE(S)
- ADDITION TO AN EXISTING STRUCTURE
- REPLACE AN EXISTING STRUCTURE

CHECK ONE:

- CREATE NEW LOT(S)
- BUILD ON AN EXISTING LOT IN A SUBDIVISION
- BUILD ON AN EXISTING PARCEL OF RECORD

IS THE PROPERTY WITHIN 2500' OF ANY RESERVOIR?

- YES
- NO

THE TYPE OF STRUCTURE IS:

- RESIDENTIAL WITH UNKNOWN PROPOSED BEDROOMS IN THE COMPLETED STRUCTURE (NOTE UNKNOWN IF APPROPRIATE)
- COMMERCIAL (PROVIDE DETAIL OF NUMBERS AND TYPES OF EMPLOYEES/ CUSTOMERS ON ACCOMPANYING PLAN)
- INSTITUTIONAL/GOVERNMENT (PROVIDE DETAIL OF NUMBERS AND TYPES OF EMPLOYEES/USERS ON ACCOMPANYING PLAN)

PROPERTY OWNER(S) PRINCE FLORENCE UNDINE

DAYTIME PHONE _____ CELL _____ FAX _____

MAILING ADDRESS _____ STREET _____ CITY/TOWN _____ STATE _____ ZIP _____

APPLICANT Hailey Development c/o RICH THOMETZ

DAYTIME PHONE (301) 476-7715 CELL (301) 346-1037 FAX (301) 476-7717

MAILING ADDRESS 3905 NATIONAL DRIVE, SUITE 105, BURTONSVILLE MD. 20866
STREET CITY/TOWN STATE ZIP

APPLICANT'S ROLE: DEVELOPER BUILDER BUYER RELATIVE/FRIEND REALTOR CONSULTANT

PROPERTY LOCATION
SUBDIVISION/PROPERTY NAME PRINCE PROPERTY LOT NO. 4

PROPERTY ADDRESS END OF HUNTERBROOKE LANE / HUNTFIELD DRIVE
STREET TOWN/POST OFFICE

AX MAP PAGE(S) 46 GRID 137 PARCEL(S) 104 PROPOSED LOT SIZE 3 AC. ±

AS APPLICANT, I UNDERSTAND THE FOLLOWING: THE SYSTEM INSTALLED SUBSEQUENT TO THIS APPLICATION IS ACCEPTABLE ONLY UNTIL PUBLIC SEWERAGE IS AVAILABLE. THIS APPLICATION IS COMPLETE WHEN ALL APPLICABLE FEES AND A SUITABLE SITE PLAN HAVE BEEN RECEIVED. I ACCEPT THE RESPONSIBILITY FOR COMPLIANCE WITH ALL M.O.S.H.A. AND "MISS UTILITY" REQUIREMENTS. APPROVAL IS BASED UPON SATISFACTORY REVIEW OF A PERC CERTIFICATION PLAN.

TEST RESULTS WILL BE MAILED TO APPLICANT.

Zacharia G. Frisch (agent for Developer)
SIGNATURE OF APPLICANT


HOWARD COUNTY HEALTH DEPARTMENT, BUREAU OF ENVIRONMENTAL HEALTH, WELL AND SEPTIC PROGRAM
3525-H ELLICOTT MILLS DRIVE, ELLICOTT CITY, MARYLAND 21043-4544 (410) 313-1771 FAX (410) 313-2648
TDD (410) 313-2323 TOLL FREE 1-877-4MD-DHMH

AP _____

618
 orge hvylm
 4-
 4 1/2
 tan
 lt. brn
 gray
 25- | 15-
 30% | 20%
 Rx | Rx
 N
 11 1/2

617
 orge
 saclm
 4
 brn
 gray
 saclm
 15%
 frags
 11 3/4

619
 orge brn
 hvylm
 &
 saclm
 6
 tan
 brn
 gray beige
 saclm
 10-20%
 Rx
 12 1/2
 Rx depth

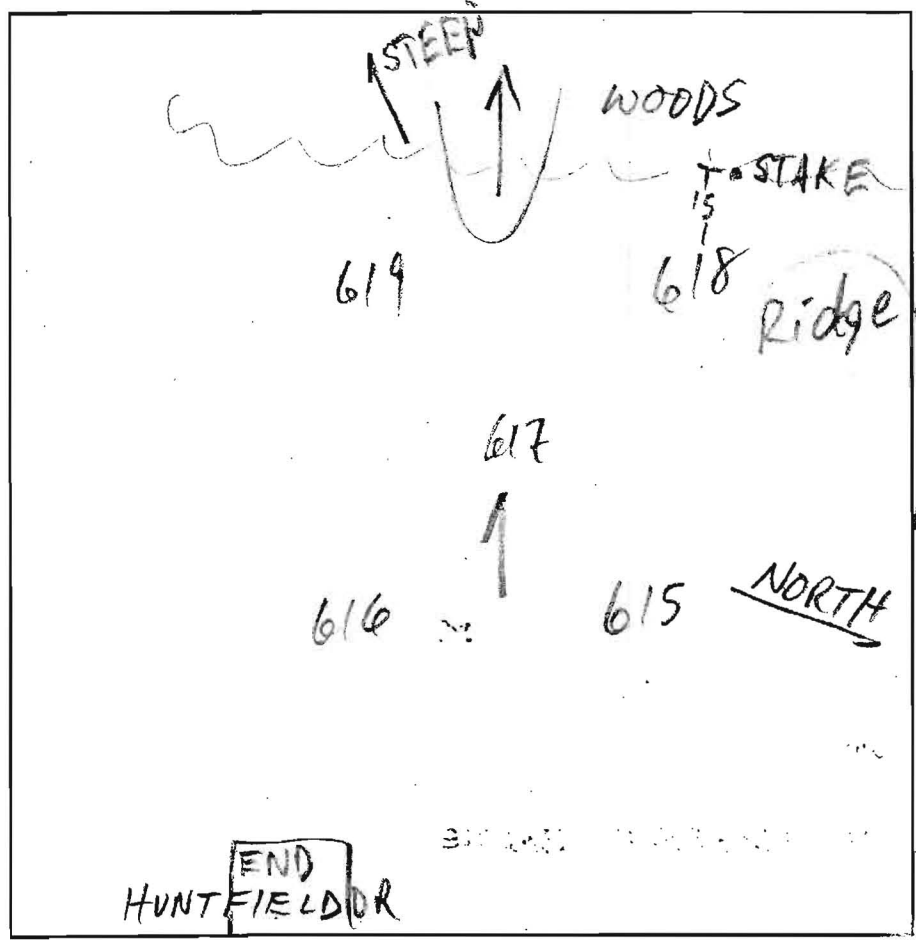

616
 orge
 brn
 hvylm
 5
 tan
 gray
 sand
 15%
 Rx
 11
 12 1/2
 25% Rx

615
 orge
 hvylm
 hvylm
 4
 gray
 brn
 sand
 5%
 frags
 13

DATE	TEST #	DEPTH	START	BREAK 1" DROP	STOP 2" DROP	TIME OF 2ND INCH	P/F/H
4/14/04	618v	7 1/2 11 1/2	2:58:25	2:59:15	3:02:30	3	P
	619v	12 1/2					P
	617v	11 3/4					P
	616v	5 1/2 12 1/2	3:38	3:40	3:44	4	P
	615v	13					P

REMARKS ALL HOLES PER PLAN
 SANITARIAN M. Rifkin BACKHOE K&K OTHERS Hailey Dev
 TEST HOLES USED IN SDA ALL AVG. PERC TIME 3 SQ. FT/BR 180
 TRENCH WIDTH 2 INLET DEPTH 3 MAX. BOT DEPTH 7 EFFECTIVE SW 2-3



Class I Rip-Rap Outfall,
dia = 9.5", dmax = 15"
Thickness = 19"
Place atop filter cloth
see detail sheet 7

60' Public
Drainage & Utility
Easement

Proposed Septic
Easement
10,008 SF

Proposed Septic
Easement
10,008 SF

LOT 4
3.000±Ac.

MIB2

Signed
PC D. H.
3/7/08
401.00
12.00

24' Private
Use-in-Common
Access, Drainage &
Utility Easement for
lots 4, 5, 6, 7

N08°44'21"W
45.45'

N07°12'28"W
101.69'

N41°10'30"W
40.12'

N04°17'08"E
88.97'

N25°38'21"W
53.15'

360

370

380

60' BRL

618

617

616

620

622

624

623

26.87'

25.85'

25.21'

475

472

100'R

100'R

12" HDPE

15" HDPE

18" HDPE

24" HDPE

30" HDPE

1572" HDPE