

LAYOUT 7/8/08 INSP 4 _____
INSP 2 7/9/08 INSP 5 _____
INSP 3 7/10/08 INSP 6 _____

ISSUE DATE: 07/07/08

APPROVAL DATE: 5/15/09

PERMIT

P 529473

A 520082-E

TAX ID # 05-447747

ON-SITE SEWAGE DISPOSAL SYSTEM HOWARD COUNTY HEALTH DEPARTMENT BUREAU OF ENVIRONMENTAL HEALTH

438

Modern Foundations IS PERMITTED TO INSTALL ALTER

ADDRESS: 7860 Kabik Court, Woodbine PHONE NUMBER: 410-795-8877

SUBDIVISION: PRINCE PROPERTY LOT NUMBER: 6

ADDRESS: 8149 HUNTFIELD DRIVE PROPERTY OWNER: Steve & Jean Battista

SEPTIC TANK CAPACITY (GALLONS): 2000 OUTLET BAFFLE FILTER REQUIRED

PUMP CHAMBER CAPACITY (GALLONS): 2000 COMPARTMENTED TANK REQUIRED

NUMBER OF BEDROOMS: 7 55', 60', 65'+70' Trenches

SQUARE FEET PER BEDROOM: _____ 4.5'-9'

LINEAR FEET OF TRENCH REQUIRED: ~~_____~~ 250'

TRENCHES:	Trench to be 3.0 feet wide. Inlet 4.0 feet below original grade. Bottom maximum depth 8.0 feet below original grade. Effective area begins at 6.0 feet below original grade. 4.0 feet of stone below distribution pipe.
LOCATION:	Install as directed by HCHD personnel at the pre-construction layout inspection. (4) 70' trenches are recommended.
NOTES:	

PLANS APPROVED: Gabriel Creighton DATE: 7/30/07

- NOTE: PERMIT VOID AFTER 2 YEARS
- NOTE: CONTRACTOR RESPONSIBLE FOR SCHEDULING A PRE-CONSTRUCTION INSPECTION FOR ALL INSTALLATIONS
- NOTE: WATERTIGHT SEPTIC TANKS REQUIRED
- NOTE: ALL PARTS OF SEPTIC SYSTEM SHALL BE 100 FEET FROM ANY WATER WELL
- NOTE: MANHOLE RISERS REQUIRED ON ALL SEPTIC TANKS AND PUMP CHAMBERS UNLESS SPECIFICALLY AUTHORIZED

NEITHER THE HOWARD COUNTY COUNCIL NOR THE HEALTH DEPARTMENT IS RESPONSIBLE FOR THE SUCCESSFUL OPERATION OF ANY SYSTEM PERMITTEE RESPONSIBLE FOR OBTAINING FINAL APPROVAL ON THIS PERMIT CALL 410-313-1771 FOR INSPECTION OF SEPTIC SYSTEM

NOT TO SCALE

See As-Built Drawing
On Separate Sheet

ROAD

TRENCH/DRAINFIELD DATA

WIDTH	INLET	BOTTOM
<u>3'</u>	<u>4.5'</u>	<u>9'</u>
NUMBER OF TRENCHES <u>4</u>		
TOTAL LENGTH <u>250</u>		
ABSORPTION AREA <u>750+ Sidewall</u>		
DISTRIBUTION BOX LEVEL <u>Yes</u>		
DISTRIBUTION BOX BAFFLE <u>Elbow</u>		
DISTRIBUTION BOX PORT <u>Yes</u>		

SEPTIC TANK DATA

SEPTIC TANK 1 LEVEL	<u>Yes</u>
CAPACITY	<u>2000</u> GAL
SEAM LOC	<u>Top</u>
TANK LID DEPTH	<u>2.5'-4'</u>
BAFFLES	<u>Yes</u>
BAFFLE FILTER	<u>No</u>
MANHOLE LOC	<u>Front</u>
6" PORT LOC	<u>Rear</u>
WATERTIGHT TEST	<u>No</u>
SEPTIC TANK 2 LEVEL	<u>Yes</u>
CAPACITY	<u>2000</u> GAL
SEAM LOC	<u>Top</u>
TANK LID DEPTH	<u>1.5'-3'</u>
BAFFLES	<u>Front</u>
BAFFLE FILTER	<u>No</u>
MANHOLE LOC	<u>Rear</u>
6" PORT LOC	<u>Front</u>
WATERTIGHT TEST	<u>No</u>


PRE-CONSTRUCTION 7/8/2008 Part of upper right corner of easement cut away. Trenches shortened and deepened to use up

INSTALLATION remaining part of upper easement area. Perc test hole dug to confirm suitability of soil. (BB) 7/9/2008

Tanks set. Top 55' trench finished (BB) 7/10/08 Top three trenches done. House connection made. (BB) 5/15/09

Pump and alarm working. (BB)

FINAL INSPECTOR B. Baber DATE OF APPROVAL 5/15/09

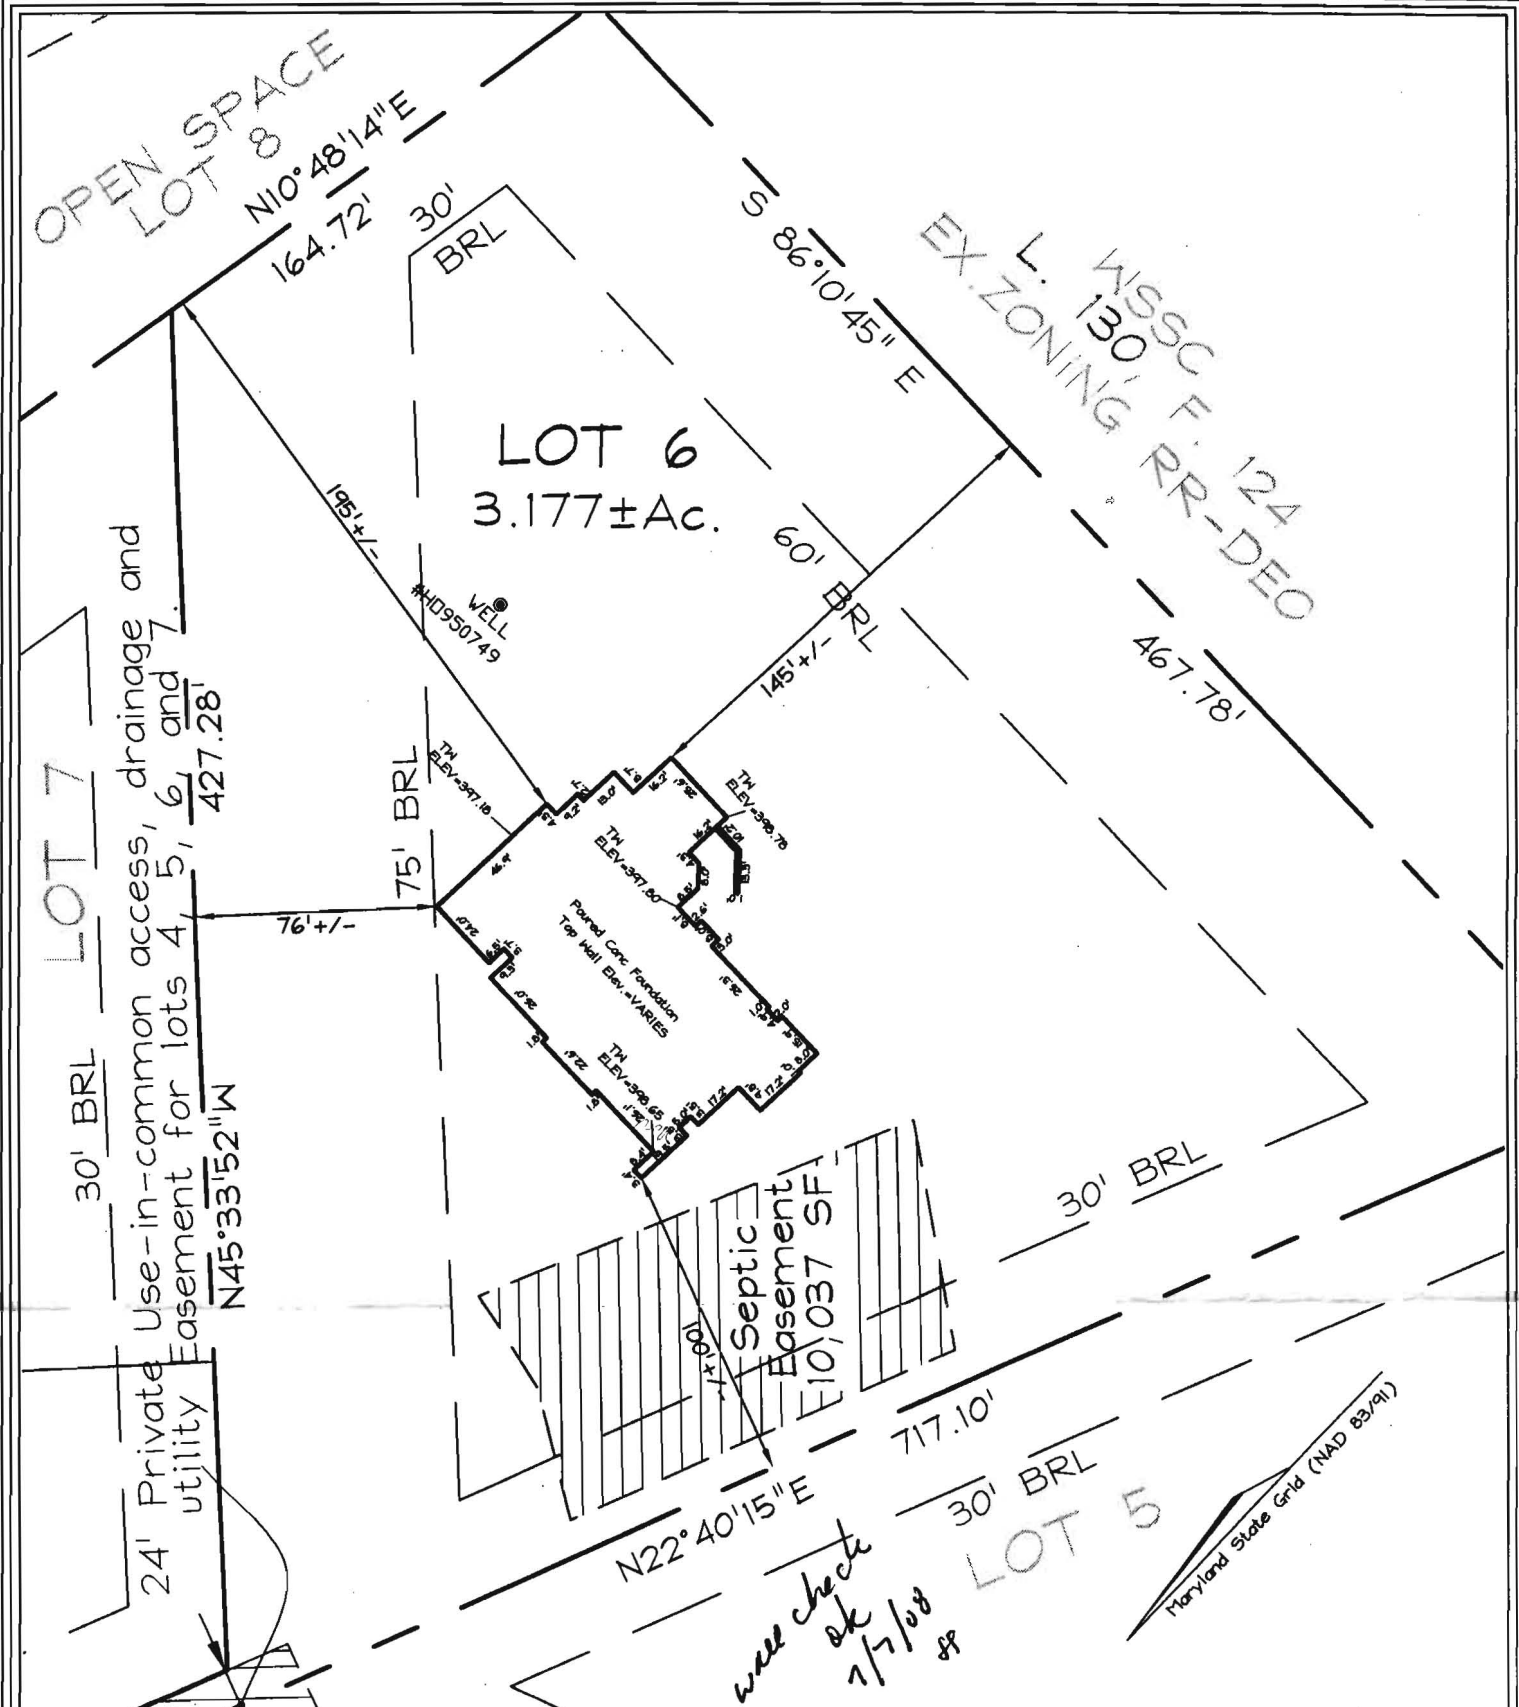


- F/P = FIREPLACE
- B/W = BAY WINDOW
- D/W = DRIVEWAY
- CONC = CONCRETE
- O/H = OVERHANG
- H/P = HEAT PUMP
- G/M = GAS METER
- E/M = ELEC METER

ADDRESS No.: 8149 HUNTFIELD DRIVE
 TOP OF WALL ELEV. VARIES AS SHOWN
 DIMENSIONS FROM FOUN. WALL TO PROPERTY LINE ARE +/-0.1'
 THIS LOCATION DRAWING IS OF BENEFIT TO THE CONSUMER ONLY
 INSOFAR AS IT IS REQUIRED BY A LENDER OR A TITLE INSURANCE
 COMPANY OR ITS AGENT IN CONNECTION WITH CONTEMPLATED
 TRANSFER, FINANCING OR REFINANCING.
 THIS LOCATION DRAWING IS NOT TO BE RELIED UPON FOR THE ES-
 TABLISHMENT OR LOCATION OF FENCES, GARAGES, BUILDINGS, OR
 OTHER EXISTING OR FUTURE IMPROVEMENTS.
 THIS LOCATION DRAWING DOES NOT PROVIDE FOR THE
 ACCURATE IDENTIFICATION OF PROPERTY BOUNDARY LINES, BUT
 SUCH IDENTIFICATION MAY NOT BE REQUIRED FOR THE TRANSFER
 OF TITLE OR SECURING FINANCING OR REFINANCING.
 FSH ASSOCIATES DOES NOT CERTIFY TO UNSHOWN OR
 UNRECORDED ENCROACHMENTS OR OVERLAPS.
 PROPERTY MARKERS NOT FOUND OR GUARANTEED BY THIS
 LOCATION, UNLESS SHOWN.


FSH Associates

Engineers Planners Surveyors
 6339 Howard Lane, Elkridge, MD 21075
 Tel: 410-567-5200 Fax: 410-796-1562
 E-mail: FSHERI.COM

*wall check
ok
1/7/08
88*

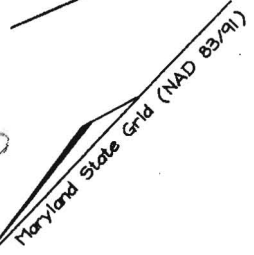

WALL CHECK	
FOUNDATION	Date: 12/06/07
FINAL	Date:
DRAWN BY:	RJS
SCALE:	1"=60'
W.O. No.:	3439

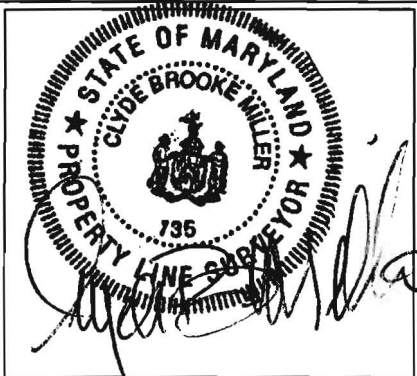

LOT 6
 PRINCE PROPERTY
 8149 HUNTFIELD DRIVE
 PLAT #19204
 TAX MAP 46 GRID 1 PARCEL 104
 5TH ELECTION DISTRICT
 HOWARD COUNTY, MARYLAND

