

4/16/84
9:30 AM
2nd

APPROVED
4/18/84
RA P 33790

PERMIT

SEWAGE DISPOSAL SYSTEM

A REPAIR

MARYLAND STATE DEPARTMENT OF HEALTH*

HOWARD COUNTY
BUREAU OF ENVIRONMENTAL HEALTH
992-2330

INDEX

ELLICOTT CITY
DISTRICT _____

DATE 4/16/84

Jenkins Brothers IS PERMITTED TO INSTALL _____ ALTER X

ADDRESS Route 144, Ellicott City, Maryland PHONE 465-6646

SUBDIVISION Holiday Hills ROAD 10806 Hunting Lane LOT 67

PROPERTY OWNER Steve Rozsas

ADDRESS 10806 Hunting Lane
Columbia, Maryland 21044

IF GARBAGE GRINDER IS USED INCREASE SEPTIC TANK CAPACITY BY 50% AND ABSORPTION AREA BY 22%.

GARBAGE GRINDER? YES _____ NO X

SEPTIC TANK CAPACITY 1000 GALLONS NUMBER OF BEDROOMS 3

REPAIR - CALL FOR INSPECTION WHEN GROUND IS OPENED UP SO SANITARIAN CAN RECOMMEND REPAIR.

DEEP DITCH 9-10 FT DEEP 60 FT
2 FT WIDE 6 FT STONE RUN
DITCH OFF TANK IN FRONT YARD
OLD DRY WELL TO BE HOOKED UP
TO DITCH LATER

PLANS APPROVED BY Frank Skinner DATE 4/16/84

COVER NO WORK UNTIL INSPECTED AND APPROVED.

NEITHER THE HOWARD COUNTY COUNCIL NOR THE HEALTH DEPARTMENT IS RESPONSIBLE FOR THE SUCCESSFUL OPERATION OF ANY SYSTEM.

NOTE: IF TRENCH IS USED CALL FOR INSPECTION BEFORE AND AFTER PLACING GRAVEL IN TRENCH.

NOTE: NO DRY WELL SHALL EXCEED 15 FOOT IN DIAMETER. NO ABSORPTION TRENCH TO EXCEED 100 FEET IN LENGTH.

NOTE: ALL PIPE FROM HOUSE TO SEPTIC TANK MUST BE CAST IRON OR SCHEDULE 40 PVC OR ABS.

PERMIT VOID AFTER THREE YEARS.


NOTE: INSTALL STAND PIPE ON SEPTIC TANK AND DRY WELL. STAND PIPES MUST BE 6 INCHES IN DIAMETER CAST IRON, CONCRETE OR TERRA COTTA, OR PVC OR ABS ACCEPTED. IF TOP OF SEPTIC TANK IS DEEPER THAN 3 FEET MANHOLE TO GRADE REQUIRED

***INSTALLER IS RESPONSIBLE FOR OBTAINING FINAL APPROVAL ON THIS PERMIT**

*CALL 992-2330 FOR INSPECTION OF SEPTIC SYSTEMS.

EH - 2-1082

* P 33790

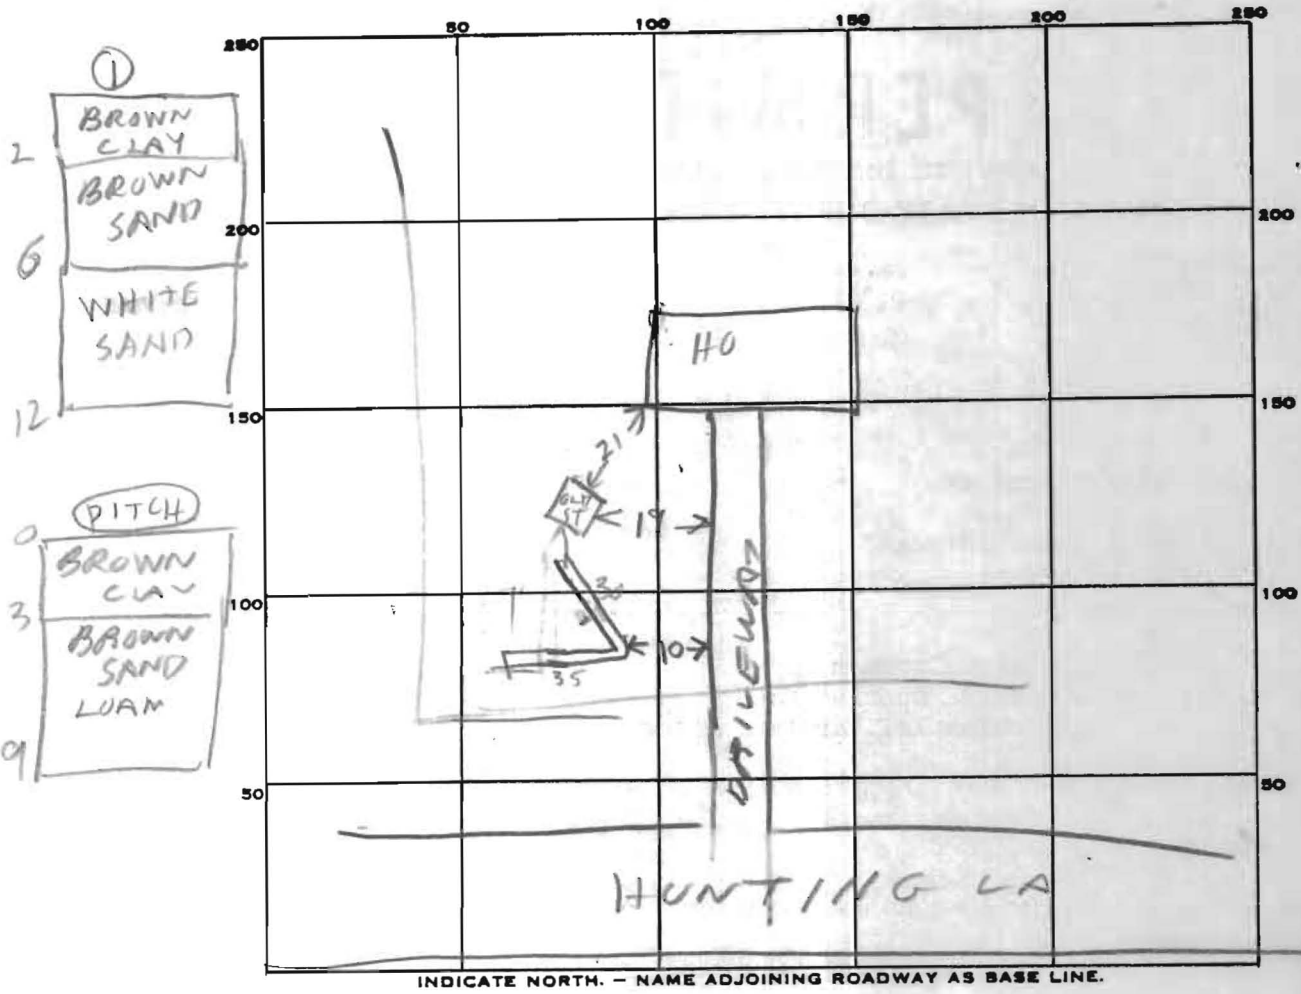

INDICATE NORTH. - NAME ADJOINING ROADWAY AS BASE LINE.

PERMIT CARD _____

SEPTIC TANK, LEVEL OLD TANK USED CLEANOUTS OK

DISTRIBUTION BOX, LEVEL _____

TRENCH TILE FIELD, DEPTH 9-10 FT. TRENCH WIDTH 2 FT.

GRAVEL DEPTH 6.5 IN. TOTAL LENGTH 40.65 FT.

NUMBER OF TRENCHES 1 TOTAL BOTTOM AREA 402

SEEPAGE PITS, INSIDE DIAMETER _____ FT. DEPTH BELOW INLET _____ FT.

ABSORBENT AREA _____ SQ. FT.

REMARKS 4/18/84 - EXTEND DITCH TO 60 FT

& ADD STONE PIT 4/18/84 DITCH

EXTENDED & STONE ADDED PIT

DATE SYSTEM APPROVED 4/18/84 INSPECTOR Raymond Hodges

65
65
125
390
4025