

7/28/00
NOON - Layout
8/18/00 - House connection
any time

PERMIT

SEWAGE DISPOSAL SYSTEM
HOWARD COUNTY HEALTH DEPARTMENT
BUREAU OF ENVIRONMENTAL HEALTH
410-313-2640

P 513681

A 58095-Z

ISSUE DATE 7/12/2000

APPROVAL DATE 8/18/00

362551

INDEXED

Fogle's Septic Clean, Inc. IS PERMITTED TO INSTALL X ALTER

ADDRESS 580 Obrecht Road, Sykesville, MD 21784 PHONE 410-795-5670

SUBDIVISION Wellington West II LOT NUMBER 28 ADDRESS 15324 Doe Hill Court

PROPERTY OWNER Pulte Homes PROPERTY OWNER'S ADDRESS 1501 S. Edgewood Street, #K
Baltimore, MD 21227

SEPTIC TANK CAPACITY 1250 GALLONS

PUMP CHAMBER CAPACITY _____ GALLONS

NUMBER OF BEDROOMS 4

*****LAYOUT INSPECTION REQUIRED PRIOR TO INSTALLATION**
TOP SEAMED, COMPARTMENTED SEPTIC TANK REQUIRED**

SQUARE FEET PER BEDROOM 210 180

LINEAR FEET OF TRENCH REQUIRED 280 240

TRENCHES: Trenches to be 3 feet wide. Inlet 2-2.5 feet below original grade. Bottom maximum depth
4 feet below original grade. 1.5 feet of stone below distribution box.

LOCATION: PLACE THE DISTRIBUTION BOX 120' DOWN THE RIGHT LOT LINE AND 60' OFF THIS SAME
LOT LINE. RUN TRENCHES ON CONTOUR TOWARD RIGHT LOT LINE.

BUILDING PERMIT SIGNED 50', 55', 55', 60', 60' OR/MC

AND RETURNED

5-21-03 800142006 - DECK
11-10-05 800156989 - FINISH BASEMENT

PLANS APPROVED MARK E. RIFKIN DATE 5-17-2000

PERMIT VOID AFTER 2 YEARS

NOTE: CONTRACTOR RESPONSIBLE FOR SCHEDULING A PRE-CONSTRUCTION INSPECTION FOR ALL INSTALLATIONS

NOTE: TOP OF SEPTIC TANKS ARE TO BE NO DEEPER THAN 3.0 FEET BELOW FINISH GRADE

NOTE: WATERTIGHT SEPTIC TANKS REQUIRED

NOTE: CLEANOUT REQUIRED EVERY 70 FEET OF SEWER LINE AND/OR AT 90° SWEEPS IN LINES FROM HOUSE TO DRAIN FIELDS, 90° ELBOWS ARE NOT ACCEPTABLE

NOTE: ALL PARTS OF SEPTIC SYSTEMS (I.E. TANK, DISTRIBUTION BOX, DRAINFIELDS) TO BE 100 FEET FROM ANY WATER WELL UNLESS OTHERWISE SPECIFICALLY AUTHORIZED

NOTE: NO ABSORPTION TRENCH TO EXCEED 100 FEET IN LENGTH UNLESS SPECIFICALLY AUTHORIZED

NOTE: ALL PIPE FROM HOUSE TO SEPTIC TANK MUST BE CAST IRON OR SCHEDULE 35/40 PVC OR ABS

NOTE: MANHOLE RISERS REQUIRED ON ALL SEPTIC TANKS AND PUMP CHAMBERS


NOTE: DISTRIBUTION BOXES MUST HAVE BAFFLES

NOTE: IF PUMPED SEPTIC SYSTEM REQUIRED, (1) SEPTIC PUMP DETAIL TO BE PROVIDED BY INSTALLER PRIOR TO ISSUANCE OF SEPTIC PERMIT (2) PUMP PERFORMANCE TEST IS NECESSARY PRIOR TO HEALTH DEPARTMENT APPROVAL OF SEPTIC PERMIT

NEITHER THE HOWARD COUNTY COUNCIL NOR THE HEALTH DEPARTMENT IS RESPONSIBLE FOR THE
SUCCESSFUL OPERATION OF ANY SYSTEM
PERMITTEE RESPONSIBLE FOR OBTAINING FINAL APPROVAL ON THIS PERMIT
CALL 410-313-2640 FOR INSPECTION OF SEPTIC SYSTEM

A 58095 Z

NOT TO SCALE

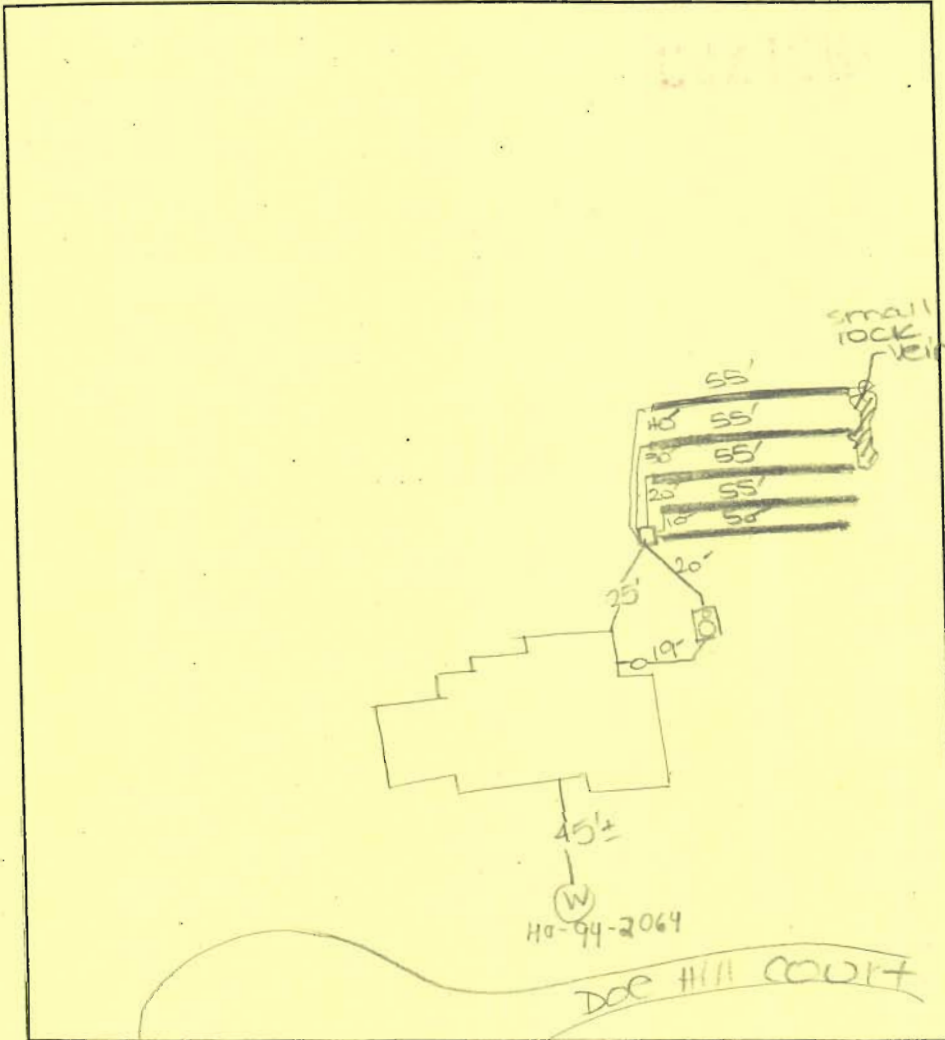

TRENCH DATA

TRENCH WIDTH 3
 TRENCH INLET DEPTH 2-2.5
 TRENCH BOTTOM DEPTH 4
 DEPTH OF STONE 2-1.5
 NUMBER OF TRENCHES 5
 TOTAL TRENCH LENGTH _____
 ABSORBENT AREA _____
 DISTRIBUTION BOX LEVEL _____
 BAFFLE IN DISTRIBUTION BOX _____

SEPTIC TANK DATA

SEPTIC TANK 1500 ^{comp} GALLONS
 MANHOLE RISER
 6 INCH INSPECTION PORT

PUMP CHAMBER DATA

PUMP CHAMBER GALLONS _____
 MANHOLE RISER _____
 ALARM _____
 PUMP PERFORMANCE TEST _____

PRE-CONSTRUCTION INSPECTION: _____

INSPECTION COMMENTS: 7/28/00 AM. Needs house connection.
OK to continue work. Rock encountered @ ends of 3 lower
trenches. Specs altered based on perc notes.
OK to continue work. DKS
7/28/00 P.M. Needs house connection. OK to cover
all septic work. DKS 8/18/00 House connection made. (B)

INSPECTOR B. Baker DATE SYSTEM APPROVED 8/18/00