

APPLICATION

PERCOLATION TESTING

A 56429W

P _____

HOWARD COUNTY HEALTH DEPARTMENT
BUREAU OF ENVIRONMENTAL HEALTH
3525-H ELLICOTT MILLS DRIVE/ELLICOTT CITY, MARYLAND 21043
TELEPHONE: 313-2640

DISTRICT _____

DATE 4-19-96

TO: THE COUNTY HEALTH OFFICER
ELLICOTT CITY, MARYLAND

I HEREBY APPLY FOR THE NECESSARY TEST PRIOR TO APPLICATION FOR PERMIT TO CONSTRUCT (OR RECONSTRUCT) A SEWAGE DISPOSAL SYSTEM.

PROPERTY OWNER J Thomas Scrivener & RYAN HAMES

ADDRESS c/o Land Design & Development PHONE 410 740 5176

AGENT OR PROSPECTIVE BUYER Donald R. Reuser Jr

ADDRESS 10805 Hickory Ridge Rd PHONE _____
21044

PROPERTY LOCATION:

SUBDIVISION _____ LOT NO. 23 ✓

ROAD AND DESCRIPTION (11049 Dorsch Farm Road)

TAX MAP 29 PARCEL # 21

SIZE OF LOT 1+ Acres TYPE BLDG. SFD - 4 Bed
(SINGLE FAMILY DWELLING OR COMMERCIAL)

PERMIT SIGNATURE
AND RETURNED 4-1-99
Serial # B0116741
SFD - 4 Bed

THE SYSTEM INSTALLED UNDER THIS APPLICATION IS ACCEPTABLE ONLY UNTIL PUBLIC FACILITIES BECOME AVAILABLE. I FULLY UNDERSTAND THE FEE CONNECTED WITH THE FILING OF THIS PERC TEST APPLICATION IS NON-REFUNDABLE UNDER ANY CIRCUMSTANCES. I ALSO AGREE TO COMPLY WITH ALL M.O.S.H.A. REQUIREMENTS IN TESTING THIS LOT.

Donald R. Reuser Jr
(SIGNATURE OF APPLICANT)

APPROVED BY _____ FOR _____ DATE _____

DISAPPROVED BY _____ FOR _____ DATE _____

HOLD PENDING FURTHER TESTS _____

REASONS FOR REJECTION OR HOLDING _____

PERCOLATION TEST PLAT/PRELIMINARY PLAT - TITLE OR I.D. # _____ DATE _____


SITE DEVELOPMENT PLAN/FINAL PLAT - TITLE OR I.D. # _____ DATE _____

THIS IS NOT A PERMIT

A 56429W
COUNTY #

SOIL PROFILE

116A
0'
1'
5'
10'
TOPSOIL
STRONG BROWN SANDY CLAY COAM
MIXED ORANGE/TAN/WHITE COARSE SANDY WITH ORANGE/BLACK BANDING NOTICES BELOW 4'

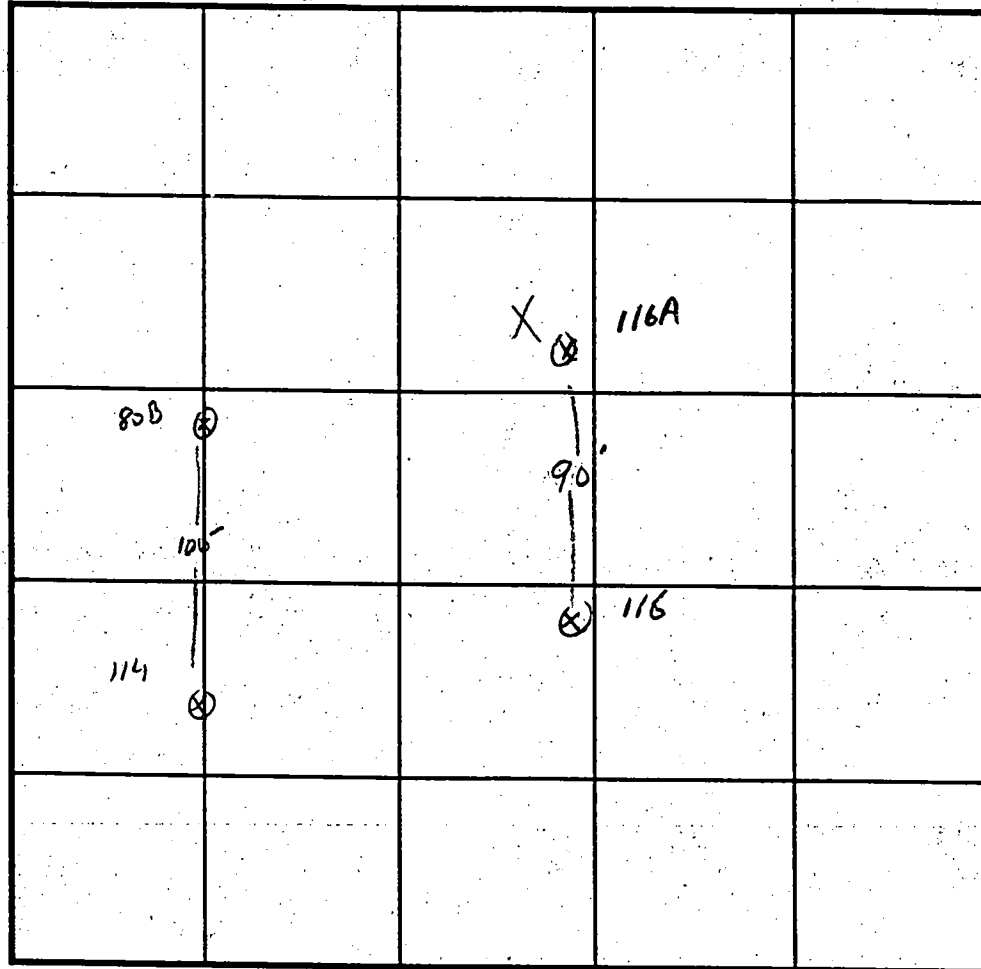

SOIL PROFILE

116
0'
8'
46'
11'
TOPSOIL
RED BROWN SANDY CLAY COAM
TAN SANDY SAND COAM

INDICATE NORTH - NAME ADJOINING ROADWAY AS BASE LINE.

DATE	TEST NO.	DEPTH	PRE-WET		TEST - 1" DROP		TIME
			START	STOP	START	STOP	
4-19-96	114	5' / 11'					16min
	80B	4' / 10'		FAIL			
	116	5' / 11'	11:50	11:56	11:56	12:06	10min
	X 116A	5' / 10'	11:57	11:58	11:58	12:01	3min
RE016	80B	5' / 10'	12:05				4min

REMARKS LOT 23 HOLES DUG 100' HIGHER THAN PLAN
 TYPE OF SOIL _____
 TESTED BY G. SAUSAGE ALSO PRESENT Don REUVER, MIKE WITE
 TRENCH DESIGN DATA: AVERAGE PERCOLATION TIME 10min TRENCH WIDTH 3
 INLET DEPTH 3 MAXIMUM BOTTOM DEPTH 5 SQ. FT./BEDROOM 180