

4/17/50 approved JTO

PERMIT

P 14892

SEWAGE DISPOSAL SYSTEM

A _____

MARYLAND STATE DEPARTMENT OF HEALTH

HOWARD COUNTY

INDEXED

ELLICOTT CITY

DISTRICT 1

DATE 10/21/69

*4/17/70
10/21/69
12/12/69*

Ernest Robinson Robert Clark IS PERMITTED TO INSTALL ALTER X
ADDRESS Rt. 2 - Clarksville, Md. PHONE 286-3432
2407 Baker St., Baltimore, Md. PHONE 523-5328

A SEWAGE DISPOSAL SYSTEM LOCATED AT _____

SUBDIVISION _____ ROAD Dorsey Road LOT _____

PROPERTY OWNER Carl Myer - Dorsey Speedway

ADDRESS _____

SPECIFICATIONS

DRAIN FIELD _____ DEPTH _____ FEET, BOTTOM AREA _____ SQ. FT.

SEEPAGE PITS _____ ABSORBENT SIDE-WALL AREA _____ SQ. FT.

SEPTIC TANK CAPACITY _____ GALLONS

FOR GARBAGE GRINDER, INCREASE DISPOSAL AREA 22% & TANK CAPACITY 50%.

OTHER REPAIR - Dig - 12" x 12" x 12" hole with 1.50 FT long and 10

FT deep and 12" wide filled with 5 FT of gravel and at least 10 FT of soil
Place the filter 1.5 FT to 2.0 FT from the top of gravel and extend
5 FT and 30 FT from the south side exterior set and running
parallel to the south side exterior set line

PLANS APPROVED BY Raymond H. Lewis DATE 10/24/69


FILL SEPTIC TANK AND DISTRIBUTION BOX WITH WATER BEFORE CALLING FOR AN INSPECTION. COVER NO WORK UNTIL INSPECTED AND APPROVED.

NEITHER THE HOWARD COUNTY COMMISSIONERS NOR THE HEALTH DEPARTMENT IS RESPONSIBLE FOR THE SUCCESSFUL OPERATION OF ANY SYSTEM.

NOTIFY THE HEALTH DEPARTMENT 48 HOURS BEFORE EXCAVATIONS ARE TO BE BACK FILLED.

14892

80
16
500
420
5
1200

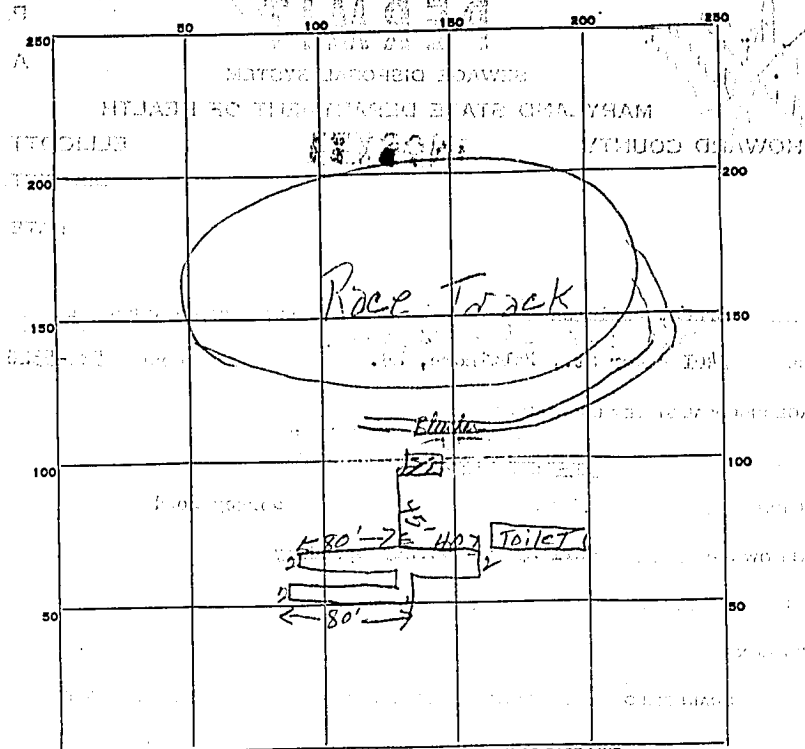

INDICATE NORTH. - NAME ADJOINING ROADWAY AS BASE LINE.

RE 176

PERMIT CARD _____

SEPTIC TANK, LEVEL _____ CLEANOUTS _____

DISTRIBUTION BOX, LEVEL _____

DEPT TRENCH 10 FT. TRENCH WIDTH 2 FT.

GRAVEL DEPTH 60 IN. TOTAL LENGTH 200 FT.

NUMBER OF TRENCHES 2 TOTAL BOTTOM AREA 2000 sq ft

SEEPAGE PITS, INSIDE DIAMETER _____ FT. DEPTH BELOW INLET _____ FT.

ABSORBENT AREA _____ SQ. FT.


10/24/69

REMARKS	1	7	1009	1013	1011	
	2	4	1014	1015	1021	
	3	1	TOP 2 FT CLAY			
			BET 5 FT SAND UNGROWN WITH A 1/2" - 1" GRAVEL			

DATE SYSTEM APPROVED 2/17/78 INSPECTOR *[Signature]*

DORSET SPEEDWAY
MAIN REST ROOM

10/23/69
B. Hodges

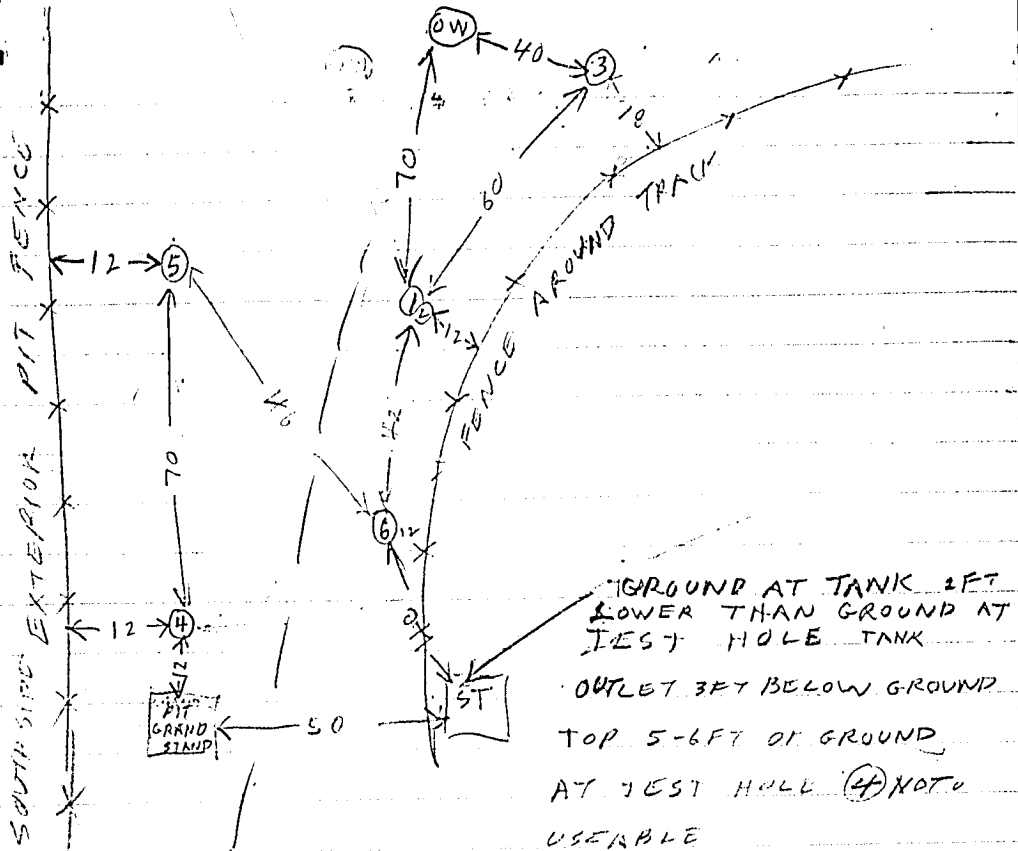

1	7		
2	4 1/2	TOP 2 FT CLAY	UNDERGROUND WATER
3	7 1/2	BOT 5 FT SAND	7 1/2 FT FROM GRADE
4	8	1053 1156 103.7	9 1/2 FT
4A	10	TOP 5 FT SAND	NO WATER BUT ROI
5	11	TOP 4 FT CLAY	
		BOT 7 FT SAND	UNDERGROUND WATER 11 FT FROM
6	8	ALL CLAY	

Track open 1 day a week April - Sept
 Attendance 600 - 1000 people but 2 restrooms
 used Load for 300 - 500 people per meeting