

LAYOUT 12/29/09 INSP 4 _____
 INSP 2 2/13/09 INSP 5 _____
 INSP 3 2/17/09 INSP 6 _____

ISSUE DATE: 12/18/2008

PERMIT

*Enter into
 part of*

P 530261

APPROVAL DATE: 2/17/09

A 522008-G

TAX ID # 04373472

**ON-SITE SEWAGE DISPOSAL SYSTEM
 HOWARD COUNTY HEALTH DEPARTMENT
 BUREAU OF ENVIRONMENTAL HEALTH**

South Carroll Backhoe, Inc IS PERMITTED TO INSTALL ALTER

ADDRESS: 4410 Salem Bottom Rd, Westminster PHONE NUMBER: 410-875-4197

SUBDIVISION: McKendree View LOT NUMBER: 8

ADDRESS: 2210 Meadow Trail Lane PROPERTY OWNER: Edgar Pugh Jr.

SEPTIC TANK CAPACITY (GALLONS): 2000 OUTLET BAFFLE FILTER REQUIRED

PUMP CHAMBER CAPACITY (GALLONS): _____ COMPARTMENTED TANK REQUIRED

NUMBER OF BEDROOMS: 4 *Inlet 5', 35', 53' and 68'*

SQUARE FEET PER BEDROOM: _____ *Bottom 7.5'*

LINEAR FEET OF TRENCH REQUIRED: 24155+ *Trenches 3' Wide*

TRENCHES:	Trench to be 2.0 feet wide. Inlet 4.0 feet below original grade. Bottom maximum depth 7.5 feet below original grade. Effective area begins at 5.5 feet below original grade. 3.5 feet of stone below distribution pipe.
LOCATION:	All septic components to be installed per sanitarian at time of pre-construction meeting.
NOTES:	Maintain a 3' earth cover over septic tank. Inlet on trenches may need to be deepened.

*38'
 57'
 68'*


PLANS APPROVED: Kevin Wolf DATE: 6/10/08

- NOTE: PERMIT VOID AFTER 2 YEARS
- NOTE: CONTRACTOR RESPONSIBLE FOR SCHEDULING A PRE-CONSTRUCTION INSPECTION FOR ALL INSTALLATIONS
- NOTE: WATERTIGHT SEPTIC TANKS REQUIRED
- NOTE: ALL PARTS OF SEPTIC SYSTEM SHALL BE 100 FEET FROM ANY WATER WELL
- NOTE: MANHOLE RISERS REQUIRED ON ALL SEPTIC TANKS AND PUMP CHAMBERS UNLESS SPECIFICALLY AUTHORIZED

NEITHER THE HOWARD COUNTY COUNCIL NOR THE HEALTH DEPARTMENT IS RESPONSIBLE FOR THE SUCCESSFUL OPERATION OF ANY SYSTEM PERMITTEE RESPONSIBLE FOR OBTAINING FINAL APPROVAL ON THIS PERMIT CALL 410-313-1771 FOR INSPECTION OF SEPTIC SYSTEM

McKendree Road.

NOT TO SCALE

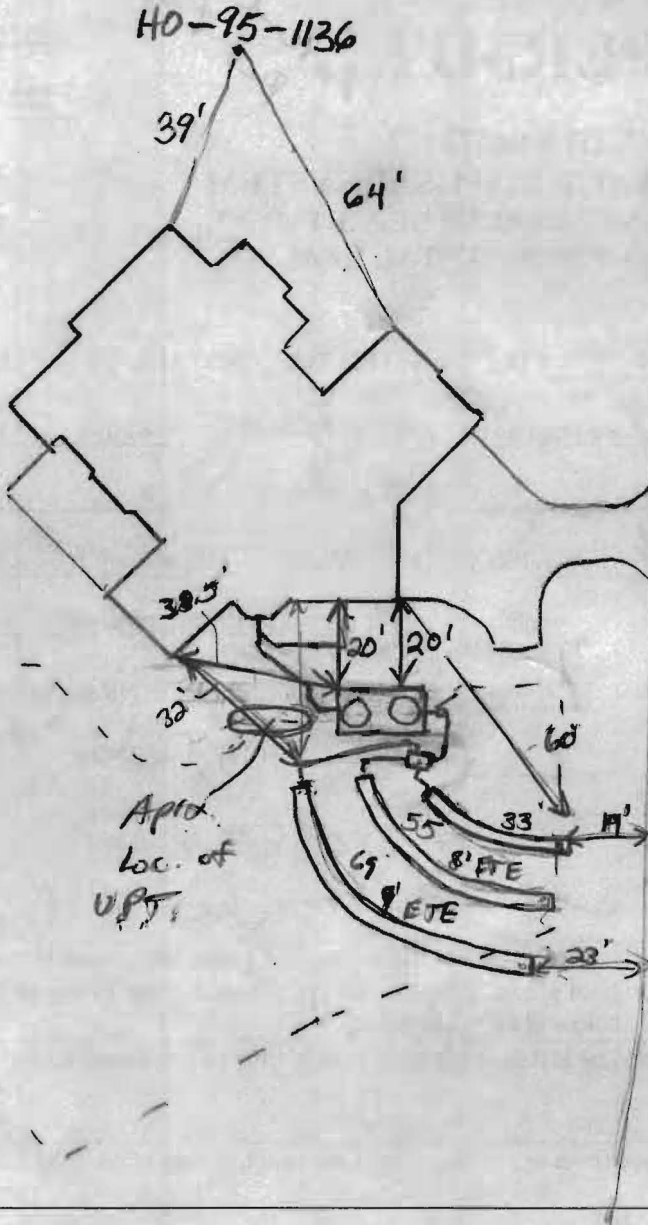

TRENCH/DRAINFIELD DATA		
WIDTH	INLET	BOTTOM
3'	5'	7.5'
NUMBER OF TRENCHES		3
TOTAL LENGTH		157'
ABSORPTION AREA		471'
DISTRIBUTION BOX LEVEL		Levelled
DISTRIBUTION BOX BAFFLE		Yes
DISTRIBUTION BOX PORT		Yes

SEPTIC TANK DATA	
SEPTIC TANK 1 LEVEL	Yes
MANUFACTURER	Babylon
CAPACITY	2000 GAL
SEAM LOC	Top
TANK LID DEPTH	0.5'-2'
BAFFLES	Yes
BAFFLE FILTER	No
MANHOLE LOC	Front+Rear
6" PORT LOC	None
WATERTIGHT TEST	No
SLOTTED	Yes
PUMP/SEPTIC TANK LEVEL N/A	
MANUFACTURER	
CAPACITY	
SEAM LOC	
TANK LID DEPTH	
BAFFLES	
BAFFLE FILTER	
MANHOLE LOC	
6" PORT LOC	
WATERTIGHT TEST	
SLOTTED	

PRE-CONSTRUCTION
 12/29/08 Told contractor to cut tank a little further down the road as shown on Approval

BP plan. SDA point to be staked. Porpoise Tank may need to be moved on BP for this was removed. one to failure. Call for trench layout w/ septic area is staked (150) 2/13/09. Install 3 short trenches across the highest usable part of the easement. Knoll gets worse as you go downhill. Trench lengths 35', 33' and 68'. Tank already set. Could have kept it closer to garage. Keep box and trench lines close to tank but on solid ground. See location on B.P. plan (150) 2/17/09 System installed as installed. OK to back fill. (150)

FINAL INSPECTOR H. Way DATE OF APPROVAL 2-17-09

