

APPLICATION

PERCOLATION TESTING

A _____

P _____

HOWARD COUNTY HEALTH DEPARTMENT
BUREAU OF ENVIRONMENTAL HEALTH
3525-H ELLICOTT MILLS DRIVE/ELLICOTT CITY, MARYLAND 21043
TELEPHONE: 313-2640

DISTRICT _____

DATE _____

TO: THE COUNTY HEALTH OFFICER
ELLICOTT CITY, MARYLAND

I HEREBY APPLY FOR THE NECESSARY TEST PRIOR TO APPLICATION FOR PERMIT TO CONSTRUCT (OR RECONSTRUCT) A SEWAGE DISPOSAL SYSTEM.

PROPERTY OWNER KENNARD WARFIELD JR

ADDRESS 14663 TRIADELPHIA ROAD PHONE 410-442-2337

AGENT OR PROSPECTIVE BUYER LAND DESIGN & DEVELOPMENT

ADDRESS 8000 MAIN STREET ELLICOTT CITY PHONE 410-480-9105

PROPERTY LOCATION:

SUBDIVISION THE WARFIELDS II LOT NO. 16 17

ROAD AND DESCRIPTION SOUTH SIDE OF TRIADELPHIA ROAD AT THE INTERSECTION OF TRIADELPHIA ROAD AND HOWARD ROAD

TAX MAP 21 PARCEL # _____

SIZE OF LOT ONE ACRE TYPE BLDG. SINGLE FAMILY DWELLING
(SINGLE FAMILY DWELLING OR COMMERCIAL)

THE SYSTEM INSTALLED UNDER THIS APPLICATION IS ACCEPTABLE ONLY UNTIL PUBLIC FACILITIES BECOME AVAILABLE. I FULLY UNDERSTAND THE FEE CONNECTED WITH THE FILING OF THIS PERC TEST APPLICATION IS NON-REFUNDABLE UNDER ANY CIRCUMSTANCES. I ALSO AGREE TO COMPLY WITH ALL M.O.S.H.A. REQUIREMENTS IN TESTING THIS LOT. DONALD R. LEWIS
(SIGNATURE OF APPLICANT)

APPROVED BY _____ FOR _____ DATE _____

DISAPPROVED BY _____ FOR _____ DATE _____

HOLD PENDING FURTHER TESTS _____

REASONS FOR REJECTION OR HOLDING _____

PERCOLATION TEST PLAT/PRELIMINARY PLAT - TITLE OR I.D. # _____ DATE _____

SITE DEVELOPMENT PLAN/FINAL PLAT - TITLE OR I.D. # _____ DATE _____

THIS IS NOT A PERMIT

COUNTY #

SOIL PROFILE

0' 6281
 orge red brn
 hvy lm

5 orge tan
 red gray
 si sa lm

* 35- 10-
 50% 25%
 Rx Rx

10 HARD BOT

DOWN UP

6282

orge brn
 hvy lm


4-
 5 tan
 lt. brn
 sa lm
 10-15%
 frags

13 1/2

6278
 orge brn
 hvy lm

5 tan sa lm
 25-40%
 frags

9 1/2 HARD BOT
 WORSE
 DOWNHILL

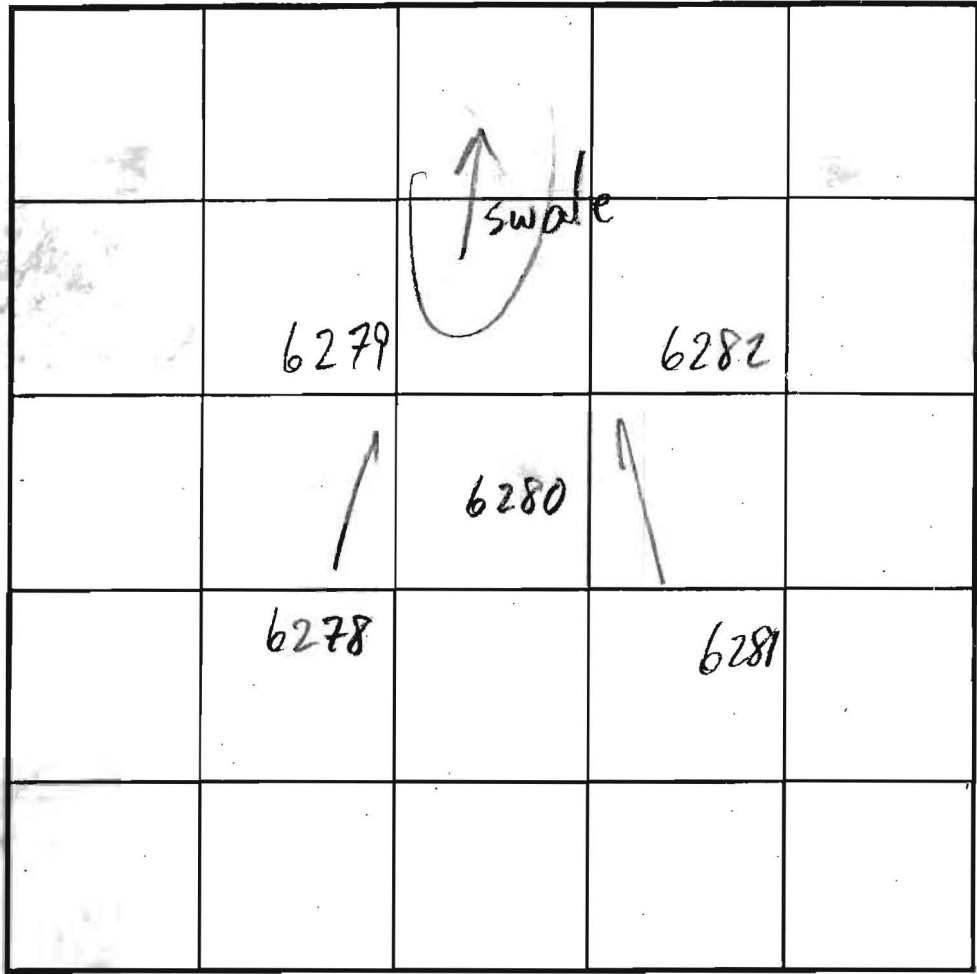

INDICATE NORTH - NAME ADJOINING ROADWAY AS BASE LINE.

SOIL PROFILE

0' 6280
 orge brn
 hvy lm
 25% frags

4-4 1/2 gray pink
 lt. brn
 red sand
 20-25%
 frags

11 1/2 HARD BOT

6279
 orge brn red
 cl lm 5-6

tan beige
 lt. brn
 sa lm
 10% frags 13 1/2

DATE	TEST NO.	DEPTH	PRE-WET		TEST - 1" DROP		TIME	
			START	STOP	START	STOP		
2/10/03	6281 ^S	6 / 10	9:55	10:03	10:03	10:25	22	
	6282 ^M	7 1/2 / 13 1/2	9:59	10:05	10:05	10:14	9	OK
2/5/03	6280 ^M	8 1/2" / 11 1/2	4:32	4:38:30	4:38:30	4:40:50	2+	OK
2/10/03	6278 ^M	7 / 9 1/2	10:08	10:11	10:11	10:15	4	
2/5/03	6279	7 / 13 1/2	4:09	4:12	4:12	4:17	5	OK

REMARKS ALL HOLES PER PLAN, BEST COMBINED w/ LOT 15 AND ADJUSTED DOWN

TYPE OF SOIL _____

TESTED BY M. Rifkin, F. Alfonso ALSO PRESENT Mike J. crew, Tori M.

TRENCH DESIGN DATA: AVERAGE PERCOLATION TIME _____ TRENCH WIDTH _____

INLET DEPTH _____ MAXIMUM BOTTOM DEPTH _____ SQ. FT./BEDROOM _____

TRIADELPHIA

MINOR COLLECTOR
(60' R/W)

Signed perc
cert. 1-16-08

