

ATT: CAS-7

MARYLAND DEPARTMENT OF THE ENVIRONMENT, WATER MANAGEMENT ADMINISTRATION

1800 Washington Blvd., Baltimore, Maryland 21200 (410) 537-3784

WATER WELL ABANDONMENT-SEALING REPORT FORM

SUBMIT COPIES OF COMPLETED FORM TO:

- * COUNTY ENVIRONMENT AGENCY (contact MDE, WMA if address needed)
- * WELL OWNER
- * MDE, WATER MANAGEMENT ADMINISTRATION, WELL PROGRAM

DATE WELL ABANDONED: 5-18-06 (month/day/year)

* PERMIT NUMBER OF ABANDONED WELL (if any)

H0-94-3493

* PERMIT NUMBER OF REPLACEMENT WELL

* PERSON ABANDONING WELL: DANA K. ROBERTS

WELL DRILLERS LICENSE NUMBER: 256

CIRCLE: MWD/MSD/MGD

* OWNER'S NAME: HAILS Development

SITE LOCATION MAP

* WELL LOCATION:
 COUNTY: HOWARD
 NEAREST TOWN: WEST FRIENDSHIP
 TAX MAP _____ BLOCK _____ PARCEL _____
 SUBDIVISION: _____
 SECTION: _____ LOT: _____
 NEAREST ROAD: RT 32
 ADDRESS 3075



* TYPE OF WELL BEING ABANDONED:

- DRILLED
- BORED/AUGERED
- OTHER (specify) _____
- JETTED
- HAND DUG

USE CODE:

- DOMESTIC
- IRRIGATION
- TEST/OBSERVATION
- MUNICIPAL/PUBLIC
- INDUSTRIAL
- GEOTHERMAL

* TYPE OF CASING:

- STEEL
- CONCRETE
- PLASTIC
- OTHER (specify) _____

* SIZE OF CASING: 6 INCHES IN DIAMETER

* DEPTH OF WELL: 450 FEET DEEP

* WAS ANY CASING REMOVED? YES NO
if yes, length removed, in feet: _____

* WAS CASING RIPPED OR PERFORATED? YES NO

LOG OF SEALING MATERIAL

MATERIAL	FEET	
	FROM	TO
<u>Cement 4-d</u>	<u>0</u>	<u>400'</u>
VOLUME OF MATERIAL USED		

SIGNATURE-MASTER WELL DRILLER OR SUPERVISING SANITARIAN

Dana Roberts

LICENSE # 256

CIRCLE ONE MWD/MSD/MGD

DATE 5-18

ATI 1757

MARYLAND DEPARTMENT OF THE ENVIRONMENT, WATER MANAGEMENT ADMINISTRATION
1800 Washington Blvd., Baltimore, Maryland 21230 (410) 537-3784

WATER WELL ABANDONMENT-SEALING REPORT FORM

SUBMIT COPIES OF COMPLETED FORM TO:

- * COUNTY ENVIRONMENT AGENCY (contact MDE, WMA if address needed)
- * WELL OWNER
- * MDE, WATER MANAGEMENT ADMINISTRATION, WELL PROGRAM

DATE WELL ABANDONED: 5-17-2006 (month/day/year)

* PERMIT NUMBER OF ABANDONED WELL (if any) _____

* PERMIT NUMBER OF REPLACEMENT WELL _____

* PERSON ABANDONING WELL: Dave / Charles


WELL DRILLERS LICENSE NUMBER: 256

CIRCLE: MWD/MSD/MGD

* OWNER'S NAME: Charles Stanger

SITE LOCATION MAP

* WELL LOCATION:
 COUNTY: Howard
 NEAREST TOWN: ELICOT CITY
 TAX MAP: _____ BLOCK C PARCEL _____
 SUBDIVISION: Hampton Hills
 SECTION: _____ LOT: 2140
 NEAREST ROAD: Douglas Mill Rd

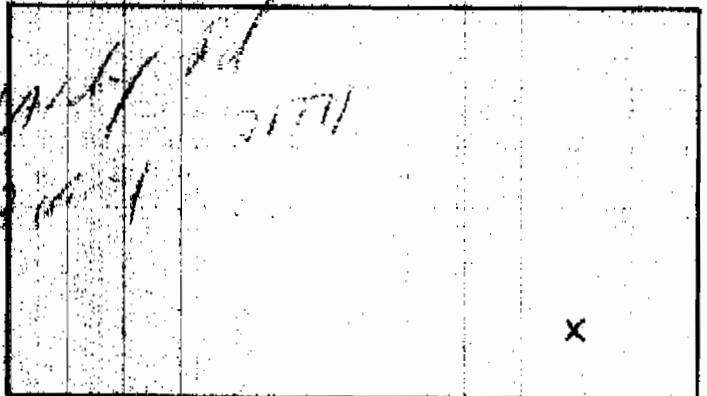

* TYPE OF WELL BEING ABANDONED:

DRILLED JETTED
 BORED/AUGERED HAND DUG
 OTHER (specify) _____

* USE CODE:

DOMESTIC MUNICIPAL/PUBLIC
 IRRIGATION INDUSTRIAL
 TEST/OBSERVATION GEOTHERMAL

* TYPE OF CASING:

STEEL PLASTIC
 CONCRETE OTHER (specify) _____

* SIZE OF CASING: 6 INCHES IN DIAMETER

* DEPTH OF WELL: 150 FEET DEEP

* WAS ANY CASING REMOVED? YES NO
if yes, length removed, in feet: _____

* WAS CASING RIPPED OR PERFORATED? YES NO

LOG OF SEALING MATERIAL


MATERIAL	FEET	
	FROM	TO
Cement Grout 2 yds	0	150'
VOLUME OF MATERIAL USED		

SIGNATURE: Dave Stanger MASTER WELL DRILLER OR SUPERVISING SANITARIAN

LICENSE # _____

CIRCLE ONE MWD/MSD/MGD

DATE: 5-17-2006

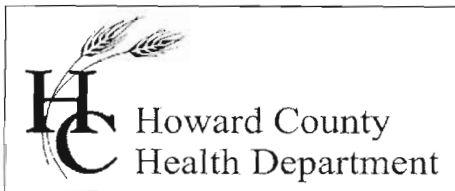

Bureau of Environmental Health
7178 Gateway Drive Columbia, MD 21046
(410) 313-2640 Fax (410) 313-2648
TDD (410) 313-2323 Toll Free 1-866-313-6300
website: www.hchealth.org

Peter L. Beilenson, M.D., M.P.H., Health Officer

November 13, 2007

Cobalt Homes LLC
3230 Bethany Lane, Suite 1
Ellicott City, MD 21042

SENT BY FACSIMILE 443-276-1907

RE: Hampton Hills, Lot2
11166 Douglas Avenue
Marriottsville, MD 21104
BP# B07002071
PUBLIC WATER

Dear Sir/Madam:

This is to advise you that the septic system for the above referenced property has been installed and inspected. **Final approval of the septic system was granted on 09/27/2007.**

The property is served by public water and is therefore exempt from the Health Department water sampling requirements.

By issuance of this letter, this office recommends release of the Use and Occupancy permit for the referenced property.

Approving Authority,

Stuart Oster, R. S.
Well & Septic Program

mlb
cc: Building Inspector's Office
File

2/13/06

WSME
02/13/06

WATER - SEWER BILLING SYSTEM
METER INFORMATION

PAGE 1 OF 2
12:19 PM

ACCOUNT# 15101420 CYCLE# 1 BILL STATUS B BILL
PROPERTY LOC 011170 - DOUGLAS AVE BLDG# PARCEL 267
MARRIOTTSTVILLE 211040000 SUBDIVISION
BOTTOM CHANGE DATE ADC MAP NUMBER 11-A5
ORIGINAL INSTALL DATE 09/11/1997 TYPE SERVICE 2 = WATER
READING CHANGE DATE 00/00/0000 NUMBER OF DIALS 1
ACTUAL METER NUMBER 95585634 TYPE METER M=MASTER S=SUBMETER
ERT ID (RADIO ONLY) 24225714 PERMANENT CODE I * RADIO *
METER SIZE B = 3/4" TAP SIZE =
METER MANUFACTURER B = BADGER METER SIZE APPLIED FOR =

WATER APPLICATION # 1-98-407 SEWER APPLICATION #
WATER APPLICATION DATE 09/05/1997 SEWER APPLICATION DATE 00/00/0000
APPLICATION FEE PAID \$ 01550 APPLICATION FEE PAID \$ NONE
WATER CONNECT DATE 10/01/1997 SEWER CONNECT DATE 00/00/0000
ADO # WALKING PATTERN # 1420
WHC SHC

F3=MENU F4=CONSUMPTION HISTORY F5=FINANCIAL INQ F6=BILL INQ
F7=MOVE BETWEEN FIRST AND SECOND PAGE F9=METER INFO F10=EXIT F11=NOTES

* Hooked up to public water- 1997, NO
RECORD of Well abandonment.

Does Well need to be abandoned?