

COUNTY #

SOIL PROFILE


180

6" topsoil
 3' red org
 brn
 cl Lm
 3' tan
 mica
 Lm
 5-10%
 rock

SOIL PROFILE

200

6" topsoil
 1'3" org brn
 cl Lm
 1'4" org
 brn
 mica
 Lm
 20%
 rock

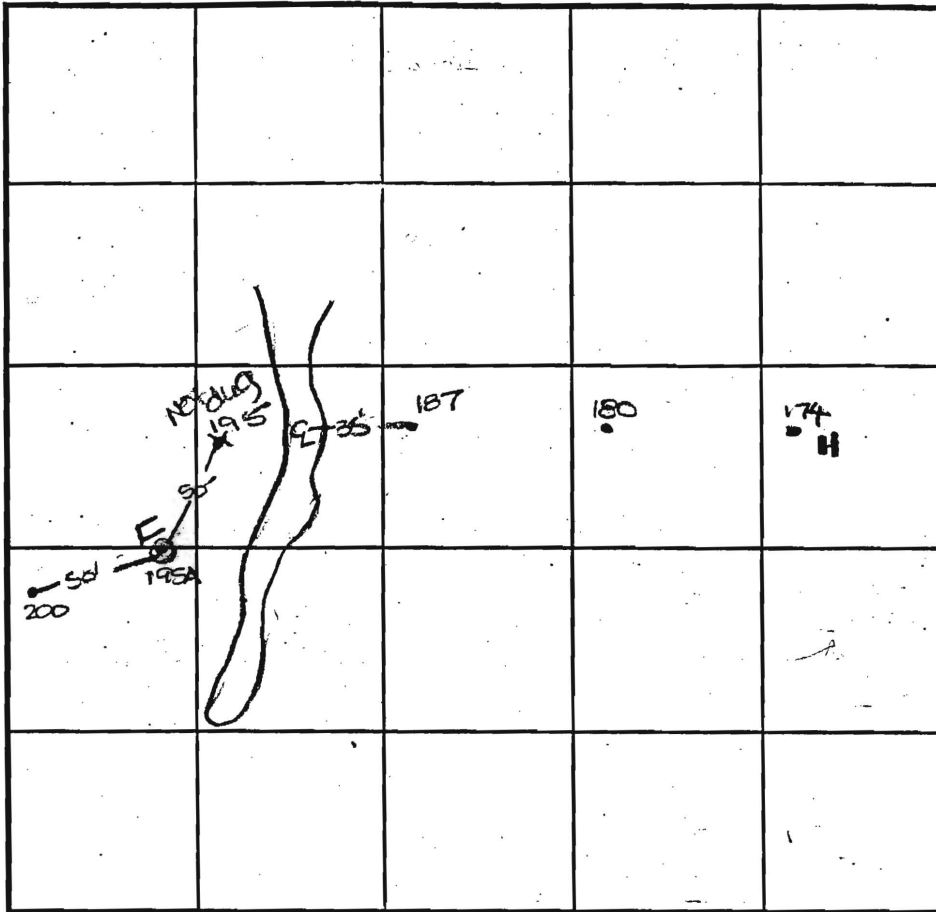

INDICATE NORTH - NAME ADJOINING ROADWAY AS BASE LINE.

11.5' Refusal

187

like
 180
 w/1
 15-20%
 rock
 11' Refusal

DATE	TEST NO.	DEPTH	PRE-WET		TEST - 1" DROP		TIME
			START	STOP	START	STOP	
1-10-01	180	3.0'S	2:03	2:04	2:04	2:06	2
		13.0'D	visual	1-See	profile		OK
	174	3.5'S	2:00	2:12	2:12	2:39	21
		12'4" D	water	-see	profile		HOLD FOR WATER TEST
	171	12.5'D	refusal	1-See	profile		OK
	187	2.5'S	2:26	2:30	2:30	2:34	4
		11.0' D	refusal	-See	profile		OK
	195A	6.5'D	Refusal				FAIL
	200	11.5' D	Refusal	-see	profile		OK

REMARKS except 195A, all holes tested as standard

TYPE OF SOIL

TESTED BY DCC ALSO PRESENT T. Feaga, C. Zapp

TRENCH DESIGN DATA: AVERAGE PERCOLATION TIME TRENCH WIDTH

INLET DEPTH MAXIMUM BOTTOM DEPTH SQ. FT./BEDROOM

174

6" topsoil
 dk red
 brn
 cl Lm
 4' med to
 dk
 org brn
 mica
 Lm

124" water

171

6" topsoil
 org brn
 cl Lm

3'4" med
 to lt
 brn
 mica
 Lm

10.5' 60% paths
 12.5' Refused

COUNTY #


SOIL PROFILE

517

topsoil
 org bn
 clm
 2.5'
 tan
 sa mica
 lm
 15%+
 rock
 11' Refusal

SOIL PROFILE

0'
 [Empty Soil Profile Box]

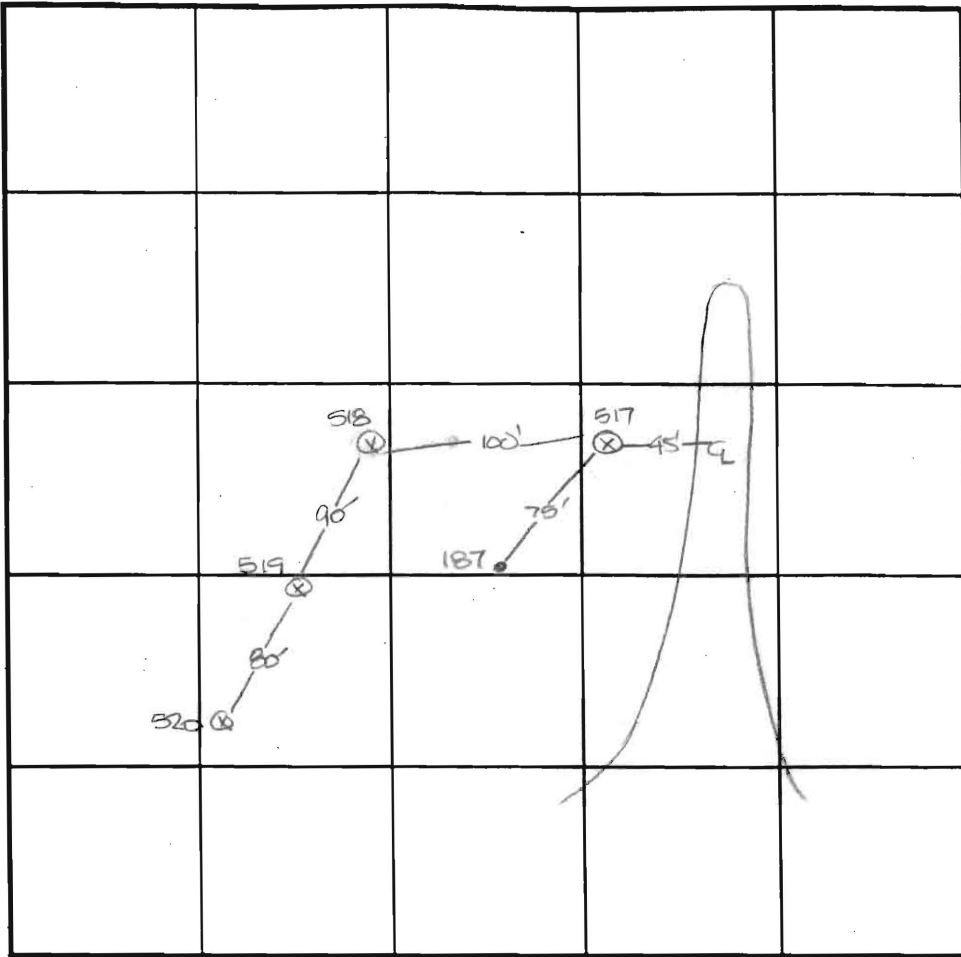

INDICATE NORTH - NAME ADJOINING ROADWAY AS BASE LINE.

518/519

topsoil
 org bn
 clm
 2.5'
 org bn
 sa mica
 lm
 10-15%+
 rock

520

topsoil
 org bn
 clm
 3.5'
 med
 bn
 sa mica
 lm
 11.5' Water

DATE	TEST NO.	DEPTH	PRE-WET		TEST - 1" DROP		TIME
			START	STOP	START	STOP	
5-16-01	517	2' 8" S	1:37 ₃	1:41 ₃	1:41 ₃	1:47	6
		11.0' D	Refusal	- See profile			OK
	518	3.0' S	1:49	1:50 ₃	1:50 ₃	1:53 ₃	3
		13.0' D	Visual	- See profile			OK
	519	3.0' S	2:05 ₃	2:08 ₃	2:08 ₃	2:12 ₃	4
		13.0' D	Visual	- See profile			OK
	520	11.5' D	Water	- See profile			FAIL

REMARKS holes not started

TYPE OF SOIL

TESTED BY DKE ALSO PRESENT C. Zopp, T. Peaga

TRENCH DESIGN DATA: AVERAGE PERCOLATION TIME TRENCH WIDTH

INLET DEPTH MAXIMUM BOTTOM DEPTH SQ. FT./BEDROOM

53 SF
PROP. 24
IN-COMMON ACC
EASEMENT FOR
LOTS 7-9 AND
PARCEL 'A'


**BUILDABLE
PRESERVATION
PARCEL 'A'**
539,251 SF
(12.39 AC)

WAGE BASHVEY
OWN. ON HOWARD
COUNTY HEALTH
DEPARTMENT RECORDS

PROP. SEPTIC
10,103 SF

M56 54.17°E
640.80

STREAM BUFFER

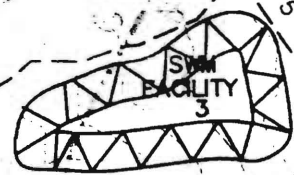

75' STREAM BUFFER

LOT 21
49655 SF

LOT 22
49344 SF

PROP. SEPTIC
10,000 SF

LOT 23
5014 SF

LOT 9
49210 SF

LOT 20
57508 SF

PROP. SEPTIC
11,348 SF

PROP. 24
IN-COMMON ACC
EASEMENT FOR
LOTS 20-23

**NON-BUILDABLE
PRESERVATION
PARCEL 'C'**
197,998 SF

LOT 18
236 SF

LOT 10
49210 SF

LOT 11
49210 SF

LOT 12
49210 SF

LOT 13
49210 SF

LOT 14
49210 SF

LOT 15
49210 SF

LOT 16
49210 SF

LOT 17
49210 SF

LOT 18
236 SF

LOT 19
49210 SF

LOT 20
57508 SF

LOT 21
49655 SF

LOT 22
49344 SF

LOT 23
5014 SF

LOT 24
49210 SF

LOT 25
49210 SF

LOT 26
49210 SF

LOT 27
49210 SF

LOT 28
49210 SF

LOT 29
49210 SF

LOT 30
49210 SF

LOT 31
49210 SF

LOT 32
49210 SF

LOT 33
49210 SF

LOT 34
49210 SF

LOT 35
49210 SF

LOT 36
49210 SF

LOT 37
49210 SF

LOT 38
49210 SF

LOT 39
49210 SF

LOT 40
49210 SF

LOT 41
49210 SF

LOT 42
49210 SF

LOT 43
49210 SF

LOT 44
49210 SF

LOT 45
49210 SF

LOT 46
49210 SF

LOT 47
49210 SF

LOT 48
49210 SF

LOT 49
49210 SF

LOT 50
49210 SF

LOT 51
49210 SF

LOT 52
49210 SF

LOT 53
49210 SF

LOT 54
49210 SF

LOT 55
49210 SF

LOT 56
49210 SF

LOT 57
49210 SF

LOT 58
49210 SF

LOT 59
49210 SF

LOT 60
49210 SF

LOT 61
49210 SF

LOT 62
49210 SF

LOT 63
49210 SF

LOT 64
49210 SF

LOT 65
49210 SF

LOT 66
49210 SF

LOT 67
49210 SF

LOT 68
49210 SF

LOT 69
49210 SF

LOT 70
49210 SF

LOT 71
49210 SF

LOT 72
49210 SF

LOT 73
49210 SF

LOT 74
49210 SF

LOT 75
49210 SF

LOT 76
49210 SF

LOT 77
49210 SF

LOT 78
