

11/5/74 Visual tube needed. In Fr.
12 ft. to 14 ft. deep

APPLICATION

A 13309
P _____

9/6/74
2:30

SEWAGE DISPOSAL TESTING
MARYLAND STATE DEPARTMENT OF HEALTH

ELLICOTT CITY
DISTRICT 3
DATE 1/2/68

Septic Tank - 3 bedrooms - 5000 gal.
" " " " - 1000 gal.
" " " " - 1000 gal.

Dry Well 3 bedrooms - 300 gal. of absorbent material below inlet pipe. Inlet pipe 40' below orig. grade. Max. depth permitted for dry well below orig. grade is 12 ft.

Place dry well 150' from front of house & 45' from left side line as seen when facing house (by house) *CD*

TO: THE COUNTY HEALTH OFFICER
ELLICOTT CITY, MARYLAND

I, HEREBY, APPLY FOR THE NECESSARY TESTS IN ORDER TO CONSTRUCT (OR RECONSTRUCT) A SEWAGE DISPOSAL SYSTEM.

PROPERTY OWNER Andrew J. Harbin - *Roy Hester*

ADDRESS Old Frederick Road, Rt. 99 PHONE HO 5-0594
Ellicott City, Maryland

PROPERTY LOCATION:

SUBDIVISION Hampton Hills LOT NO. 2

ROAD AND DESCRIPTION Douglas Avenue - approx. 600 ft. in off Marriottsville Rd. - left hand side

OCCUPANT _____ PHONE _____

PERSON TO CONSTRUCT SYSTEM _____

ADDRESS _____ PHONE _____

SIZE OF LOT 1.25 acres TYPE BLDG. 3 or 4
NUMBER OF BEDROOMS

IF NOT SINGLE RESIDENCE DESCRIBE _____

SIGNATURE OF APPLICANT Andrew J. Harbin BLDG. PERMIT SIGNED AND RETURNED 9/16/74

APPROVED BY W.H. Manning FOR Secretary DATE 7/22/68


REJECTED BY _____ FOR _____ DATE _____
(KIND OF SYSTEM)

HOLD PENDING FURTHER TESTS _____ DATE _____

REASONS FOR REJECTION OR HOLDING _____

*Mrs. Hester - 795-2100
E/te. 422*

THIS IS NOT A PERMIT

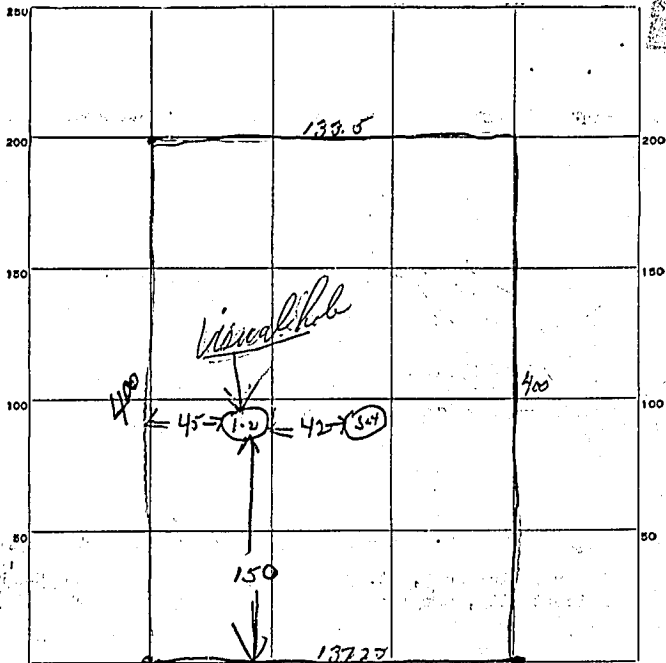

INDICATE NORTH - NAME ADJOINING ROADWAY AS BASE LINE.
Deep Road Council

DATE	TEST NO.	DEPTH	PRE-WET		TEST - 1" DROP		TIME
			START	STOP	START	STOP	
1-4-65	1	5-ft	1 47	1 54	1 54	2 08	14 min
	2	10-ft	1 57	1 58	1 58	2 00	2 min
	3	5-ft	2 00	2 06	2 06	2 19	18 min
	4	10-ft	2 01	2 03	2 03	2 06	3 min

10-1-65

SOIL AUGER FINDING

TESTED BY

DM LFP

REMARKS

*12' visual hole - good soil all the way No water or rock
 who present - Freeman Earth
 Set 2*