


7433 Oakcrest Lane
Clarksville, md 21029

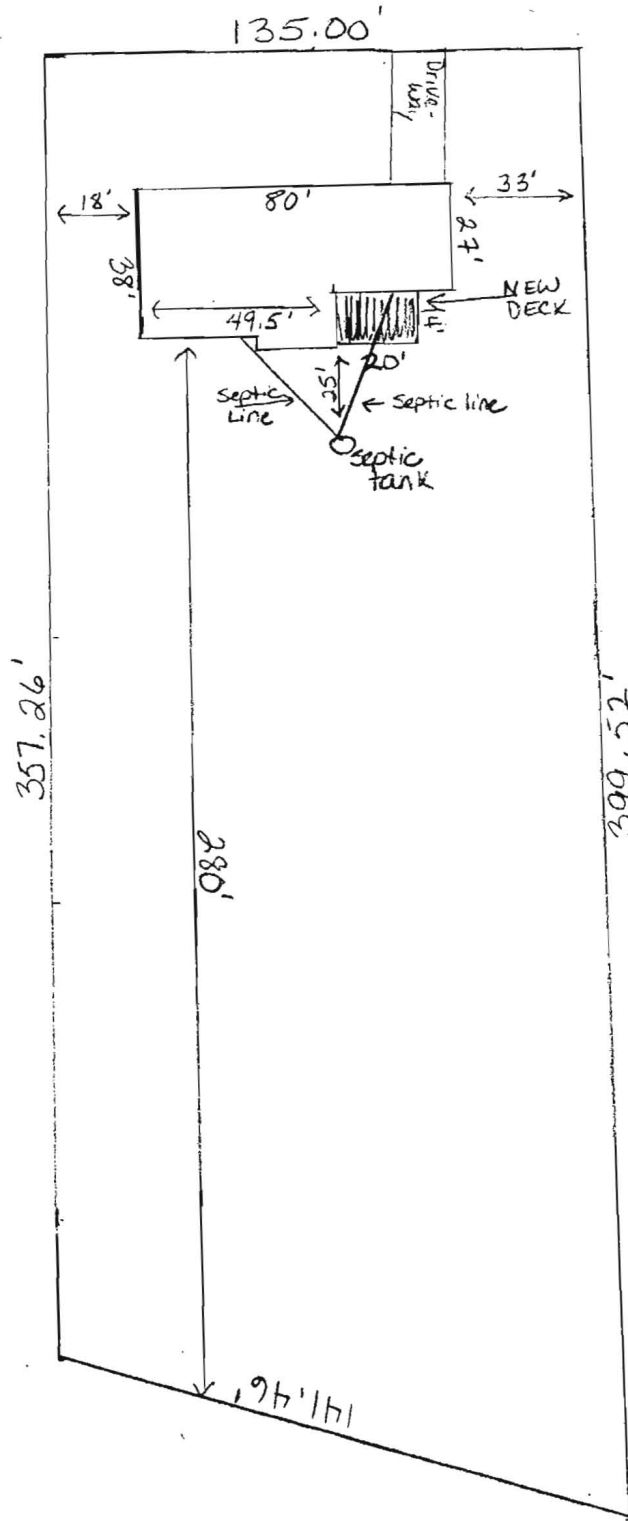

Subdivision:
Hopkins Mead

Lot: 32

Map: 41

Grid: 14

Parcel: 260

Land area: 1.17 AC

APPROVED

WALK-THRU BUILDING PERMIT

BP# B00153164 A# 518640-A

APP. SAN KTB DATE: 4/14/05

DESC. OF WORK: Deck

Plot Plan
1" = 50'