

PRELIMINARY

APPLICATION

A 18532

P _____

SEWAGE DISPOSAL TESTING

STATE OF MARYLAND - DEPARTMENT OF HEALTH AND MENTAL HYGIENE

HOWARD COUNTY HEALTH DEPARTMENT
ENVIRONMENTAL HEALTH SERVICES
P. O. BOX 476, ELLICOTT CITY, MARYLAND 21043
TELEPHONE: 468-8000, EXT. 386

DISTRICT 3rd

DATE 5/25/73

TO: THE COUNTY HEALTH OFFICER
ELLICOTT CITY, MARYLAND

I, HEREBY, APPLY FOR THE NECESSARY TEST IN ORDER TO CONSTRUCT (OR RECONSTRUCT) A SEWAGE DISPOSAL SYSTEM.

PROPERTY OWNER Edward W. & Helen T. Twining (Contractor Purchaser - Stephen Helwig)
3604 Washington Blvd., Elkridge, Md.

ADDRESS _____ PHONE 242-5085

PROPERTY LOCATION:

SUBDIVISION _____ LOT NO. Parcel 2

ROAD AND DESCRIPTION Driver Road - see other application for directions)

SIZE OF LOT 12.939 acres TYPE BLDG. 3 bedrooms
NUMBER OF BEDROOMS

IF NOT SINGLE RESIDENCE DESCRIBE _____

THE SYSTEM INSTALLED UNDER THIS APPLICATION IS ACCEPTABLE ONLY UNTIL PUBLIC FACILITIES BECOME AVAILABLE.

SIGNATURE OF APPLICANT /s/ Linda T. Helwig

APPROVED BY _____ FOR _____ DATE _____
(KIND OF SYSTEM)

REJECTED BY _____ FOR _____ DATE _____
(KIND OF SYSTEM)


HOLD PENDING FURTHER TESTS _____ DATE _____

REASONS FOR REJECTION OR HOLDING _____

THIS IS NOT A PERMIT

APPLICATION

DATE: _____
 TIME: _____
 ADDRESS: _____

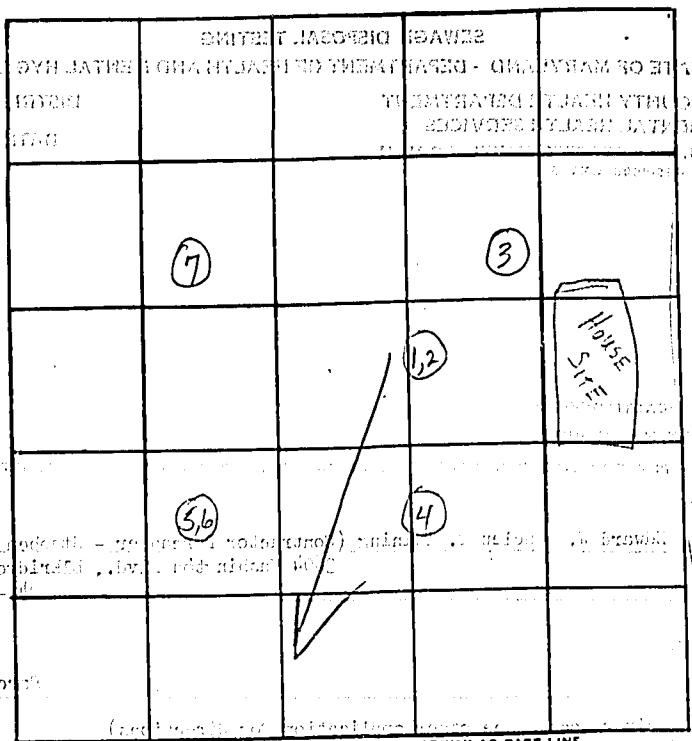

Lot 2

INDICATE NORTH - NAME ADJOINING ROADWAY AS BASE LINE.

Dinner Rd

DATE	TEST NO.	DEPTH	PRE-WET		TEST - 1" DROP		TIME
			START	STOP	START	STOP	
6/24/73	1	3	1:44	1:45	1:45	1:47	2
	2	11	1:30	1:35	1:35	1:44	9
	3	11	Thru sand; down to 142; rocky		down to 142		
	4	11	Thru sand; down to 142		down to 142		
	5	4	1:52	1:55	1:55	2:00	5
	6	12	1:50	1:52	1:52	1:55	3
	7	10 1/2	Thru sand; down to 142		down to 142		

highest tested
request

$\bar{E} = 8 \frac{1}{2}$
 $\text{Inlet} = 3'$

REMARKS: _____

TYPE OF SOIL: Sandy silt