

# APPLICATION

PERCOLATION TESTING

A 516084  
P \_\_\_\_\_

HOWARD COUNTY HEALTH DEPARTMENT  
BUREAU OF ENVIRONMENTAL HEALTH  
3525-H ELLICOTT MILLS DRIVE/ELLICOTT CITY, MARYLAND 21043  
TELEPHONE: 313-2640

DISTRICT \_\_\_\_\_  
DATE \_\_\_\_\_

TO: THE COUNTY HEALTH OFFICER  
ELLICOTT CITY, MARYLAND

I HEREBY APPLY FOR THE NECESSARY TEST PRIOR TO APPLICATION FOR PERMIT TO CONSTRUCT (OR RECONSTRUCT) A SEWAGE DISPOSAL SYSTEM.

PROPERTY OWNER SECURITY DEVELOPMENT, L.L.C.  
P.O. BOX 417  
ADDRESS ELLICOTT CITY, MD 21041 PHONE 410-465-4244

AGENT OR PROSPECTIVE BUYER \_\_\_\_\_  
ADDRESS \_\_\_\_\_ PHONE \_\_\_\_\_

PROPERTY LOCATION:

SUBDIVISION HOMEWOOD LOT NO. 82  
ROAD AND DESCRIPTION HOMEWOOD ROAD

TAX MAP 23 & 29 PARCEL # 20 & 86

SIZE OF LOT 1 ACRE ± TYPE BLDG. SINGLE FAMILY DETACHED  
(SINGLE FAMILY DWELLING OR COMMERCIAL)

THE SYSTEM INSTALLED UNDER THIS APPLICATION IS ACCEPTABLE ONLY UNTIL PUBLIC FACILITIES BECOME AVAILABLE. I FULLY UNDERSTAND THE FEE CONNECTED WITH THE FILING OF THIS PERC TEST APPLICATION IS NON-REFUNDABLE UNDER ANY CIRCUMSTANCES. I ALSO AGREE TO COMPLY WITH ALL M.O.S.H.A. REQUIREMENTS IN TESTING THIS LOT.

SECURITY DEVELOPMENT LLC  
BY: M.C. [Signature]  
(SIGNATURE OF APPLICANT) STEVEN K. BIRFORD

APPROVED BY \_\_\_\_\_ FOR \_\_\_\_\_ DATE \_\_\_\_\_

DISAPPROVED BY \_\_\_\_\_ FOR \_\_\_\_\_ DATE \_\_\_\_\_

HOLD PENDING FURTHER TESTS \_\_\_\_\_

REASONS FOR REJECTION OR HOLDING \_\_\_\_\_

PERCOLATION TEST PLAT/PRELIMINARY PLAT - TITLE OR I.D. # \_\_\_\_\_ DATE \_\_\_\_\_

SITE DEVELOPMENT PLAN/FINAL PLAT - TITLE OR I.D. # \_\_\_\_\_ DATE \_\_\_\_\_

# THIS IS NOT A PERMIT

# MIS REPRESENTED HOLE #S

516084

COUNTY #

SOIL PROFILE

82A

DK RD  
Brn  
CL Lm  
Micaceous  
(some)  
Rx=5%  
5 1/2'  
brn  
y brn  
Micaceous  
SAND fine  
Rx-Trace  
Bottom 14 1/2'

82B

DK brn  
Sm frago 10-15%  
Hvy Lm  
CL Lm  
4'  
Lms SAND  
to SAND  
20-30% Rx  
7'  
platy  
Structure  
Rocks (Hard Saprol)  
Pebbles  
30-40%  
SAND  
Bottom 14'

82E


DK brn  
loam  
Trace Rx  
4'  
DK brn  
V Fine Loamy  
Sand  
(almost s.)  
micaceous  
Trace  
Rx  
Bottom 14'

SOIL PROFILE

82D

4 1/2'  
Mini  
boulder  
Vein  
runs  
N to S  
50%  
otherwise  
soils  
like  
82E

82C aka 10381  
Strong RD  
Hvy Lm  
fine  
sand  
origin  
Bottom

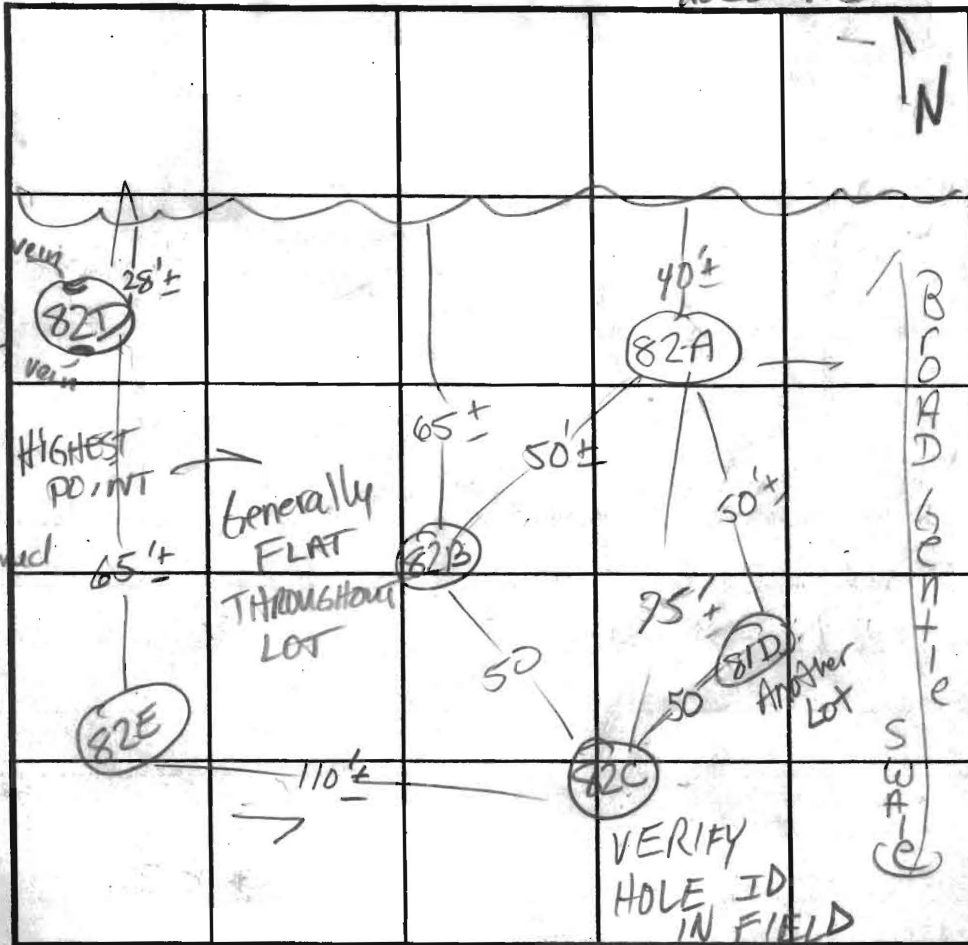

INDICATE NORTH - NAME ADJOINING ROADWAY AS BASE LINE.

DATE	TEST NO.	DEPTH	PRE-WET		TEST - 1" DROP		TIME	
			START	STOP	START	STOP		
6/20/02	82A	5 1/2' / 5 1/4'	10:37:31	Too slow	OK @ 6'	Est 4 min	OK	
	82C	6'					OK	
	Treat ment 4' OK - 82B	4' Post-hole dig	10:51:40	10:52:49		10:54:33	1 1/2 min	OK
		6' / 14'	10:50:18	10:51:50		10:55:45	3 1/2 min	
		2 1/2 gal	14' ✓	10:54:08	10:55:20		1 min	
	82E	4' / 14'	11:00	11:02		11:05:30	3 1/2	
	82D	Excessive mini boulders	4 1/2'	12 1/2'			(F)	
	82B	8 1/2'	11:45	11:47:30		11:51	4 min	OK
10381	82C	7 1/2' post hole digger	1:30:25			1:32:10	2 min	OK

REMARKS Please indicate 82C aka 10381 infield  
 TYPE OF SOIL 82C staked as 10377  
 TESTED BY Kacie ALSO PRESENT HATFIELDS  
 TRENCH DESIGN DATA: AVERAGE PERCOLATION TIME \_\_\_\_\_ TRENCH WIDTH \_\_\_\_\_  
 INLET DEPTH \_\_\_\_\_ MAXIMUM BOTTOM DEPTH \_\_\_\_\_ SQ. FT/BEDROOM \_\_\_\_\_

12020 OPEN RUN ROAD  
1.4 AC +/-

N SPACE

Signed Perc Plan  
by H.O. 7-10-03



OPEN SPACE  
REC'D AND PARS  
N16A23'E

OPEN RUN ROAD

LOT 72

LOT 73

LOT 74

LOT 352