

7/1/74

PERMIT

P 20181
A 18532

SEWAGE DISPOSAL SYSTEM

MARYLAND STATE DEPARTMENT OF HEALTH

HOWARD COUNTY

ELLICOTT CITY

INDEXED

DISTRICT 3rd

DATE 6/19/74

Emerson Feaga IS PERMITTED TO INSTALL ALTER

ADDRESS Old Frederick Road, Woodstock, Maryland 21163 PHONE 328-2481

A SEWAGE DISPOSAL SYSTEM LOCATED AT _____

SUBDIVISION _____ ROAD Driver Road LOT Parcel 2

PROPERTY OWNER Stephen Helwig

ADDRESS 3604 Washington Boulevard, Elkridge, Maryland 21227 Phone: 242-5085

SPECIFICATIONS 3 bedrooms

DRAIN FIELD _____ DEPTH _____ FEET, BOTTOM AREA _____ SQ. FT.

SEEPAGE PITS _____ ABSORBENT SIDE-WALL AREA _____ SQ. FT.

SEPTIC TANK CAPACITY 1000 GALLONS

FOR GARBAGE GRINDER, INCREASE DISPOSAL AREA 22% & TANK CAPACITY 50%

OTHER DRY WELL - Is to have 320 sq. ft. absorbent effective sidewall area below the first 3 feet of non-absorbent ground at original grade. Maximum depth of dry well to be 12 feet. Locate dry well 137 feet from left side line and 443 feet from front lot line as seen when facing lot from Driver Road.

NOTE: ALL PIPE FROM HOUSE TO DRY WELL MUST BE CAST IRON.
PERMIT VOID AFTER THREE YEARS.


NOTE: INSTALL STAND PIPE ON SEPTIC TANK AND DRY WELL.

PLANS APPROVED BY William W. Zepp DATE 8/2/73

FILL SEPTIC TANK AND DISTRIBUTION BOX WITH WATER BEFORE CALLING FOR AN INSPECTION. COVER NO WORK UNTIL INSPECTED AND APPROVED.

NEITHER THE HOWARD COUNTY COMMISSIONERS NOR THE HEALTH DEPARTMENT IS RESPONSIBLE FOR THE SUCCESSFUL OPERATION OF ANY SYSTEM.

A 18532

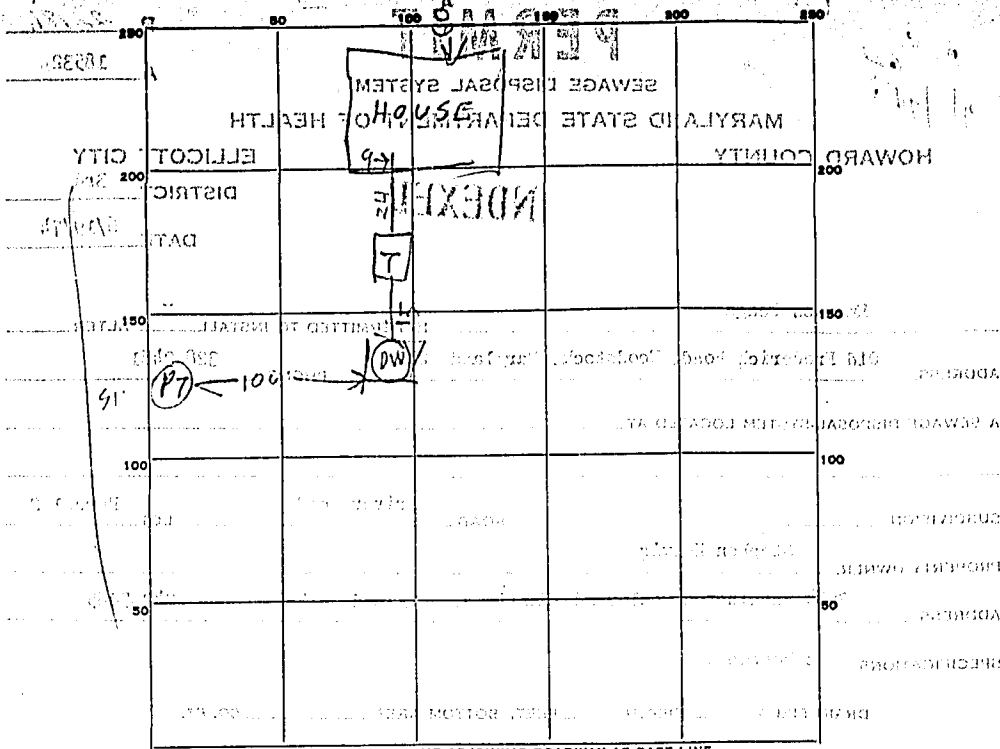

PERMIT CARD YES

SEPTIC TANK, LEVEL CRIMOGGLASS CLEANOUTS WELL RINGS
AEROBIC TANK MODEL # CA 9.00
 DISTRIBUTION BOX, LEVEL TOP 2-3 FT BELOW GRADE

TILE FIELD, DEPTH _____ FT. TRENCH WIDTH _____ FT.

GRAVEL DEPTH _____ IN. TOTAL LENGTH _____ FT.

NUMBER OF TRENCHES _____ TOTAL BOTTOM AREA 1.68 SQ. FT.

SEEPAGE PITS, INSIDE DIAMETER 10 FT. DEPTH BELOW INLET 9 FT.

ABSORBENT AREA 468 SQ. FT. COUNTING STONE

REMARKS 7/1/74 - DW INLET 7 3/4 FT. BELOW GRADE
SPECIAL WRITTEN PERMISSION MUST BE OBTAINED FROM P.W. DIV.
TO INSTALL EXPERIMENTAL AEROBIC TANKS - R.H.
7/2/74 P.W. SAID CRIMOGGLASS UNIT OK IN THIS
CASE WITHOUT LETTER (B) 19

DATE SYSTEM APPROVED 7/2/74 INSPECTOR Raymond Hodgson

