

PERMIT

SEWAGE DISPOSAL SYSTEM

MARYLAND STATE DEPARTMENT OF HEALTH

HOWARD COUNTY

ELLICOTT CITY

DISTRICT 3rd

DATE 6/28/73

INDEXED

11/18/73 Partial c.o.

R.T.

FILE P 18629 A 14732 11/15/74

4/8/73

11/15/73 Early on possible

E. Robert Kent

IS PERMITTED TO INSTALL ALTER

ADDRESS 4530 Hollins Ferry Road, Balto., Md. 21227

PHONE 247-2200

A SEWAGE DISPOSAL SYSTEM LOCATED AT _____

SUBDIVISION Woodmark

ROAD Pan Spring Court

LOT 60, Blk. B, Sec. 6

PROPERTY OWNER Mr. & Mrs. Raymond C. Jung

ADDRESS 12337 Pan Spring Court, Ellicott City, Maryland

SPECIFICATIONS 4 bedrooms

DRAIN FIELD _____ DEPTH _____ FEET, BOTTOM AREA _____ SQ. FT.

SEEPAGE PITS _____ ABSORBENT SIDE-WALL AREA _____ SQ. FT.

SEPTIC TANK CAPACITY 1250 GALLONS

BUDG. PERMIT SIGNED AND RETURNED 10/17/73

Serial # 21705

Install Inground Pool

FOR GARBAGE GRINDER, INCREASE DISPOSAL AREA 22% & TANK CAPACITY 50%.

OTHER DRY WELL 400 sq. ft. sidewall area below inlet. Inlet of dry well to be no deeper than 5 ft. and bottom of dry well to be no deeper than 12 ft. Place the dry well 95 ft. from the back lot line and 25 ft. from the right side of the lot as seen when facing lot from Pan Spring Court.

10/29/73 - OK to have dry well inlet at 6 ft and make

NOTE: ALL PIPE FROM HOUSE TO DRY WELL MUST BE CAST IRON.

Wide Square Hole (17FT) with inlet no deeper than 12 FT. 17H

NOTE: INSTALL STAND PIPE ON SEPTIC TANK AND DRY WELL.

PLANS APPROVED BY Raymond Hodges


DATE 8/27/71

FILL SEPTIC TANK AND DISTRIBUTION BOX WITH WATER BEFORE CALLING FOR AN INSPECTION. COVER NO WORK UNTIL INSPECTED AND APPROVED.

NEITHER THE HOWARD COUNTY COMMISSIONERS NOR THE HEALTH DEPARTMENT IS RESPONSIBLE FOR THE SUCCESSFUL OPERATION OF ANY SYSTEM.

sampling port needed between septic tank & drywell
NO 11/15/73 11/15/73 sampling port not required on Mr. Jung's system

A 147321

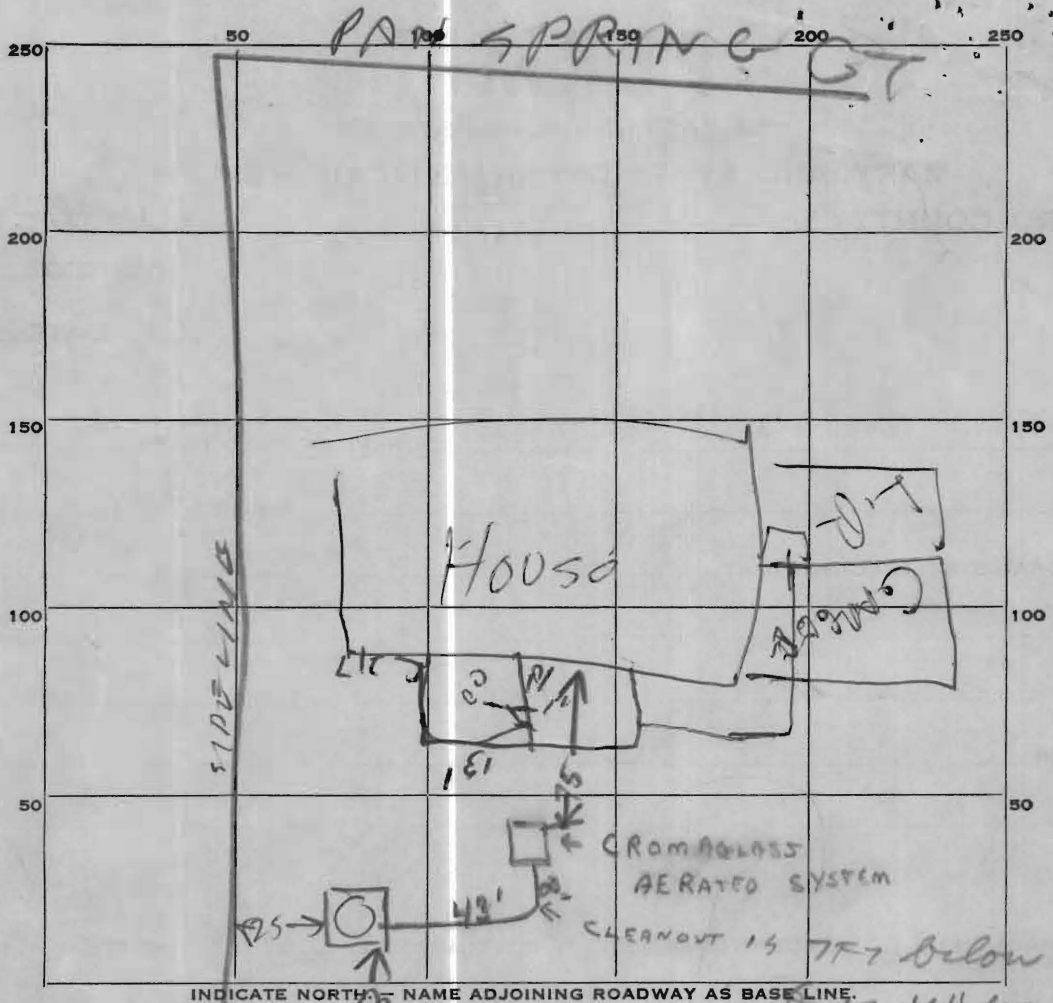

INDICATE NORTH - NAME ADJOINING ROADWAY AS BASE LINE.

PERMIT CARD _____

SEPTIC TANK, LEVEL _____ CLEANOUTS _____

DISTRIBUTION BOX, LEVEL _____

TILE FIELD, DEPTH _____ FT. TRENCH WIDTH _____ FT.

GRAVEL DEPTH _____ IN. TOTAL LENGTH _____ FT.

NUMBER OF TRENCHES _____ TOTAL BOTTOM AREA _____

SEEPAGE PITS, INSIDE DIAMETER 12 FT. DEPTH BELOW INLET 7 1/2 FT.

ABSORBENT AREA 547 SQ. FT. counting below

REMARKS _____

11/8/73 Aerated system checked - R.T.

11/15/73 - Dry Well Inlet is 6 FT below grade

Perimeter is 73 FT Dry Well is O.K. Hold's on

Do not know if all house sewer inspected

"Sampling Port" is nothing but a 4" cleanout

DATE SYSTEM APPROVED 1/15/74 INSPECTOR DW Morgan

PERMIT

SEWAGE DISPOSAL SYSTEM

MARYLAND STATE DEPARTMENT OF HEALTH

HOWARD COUNTY

ELLICOTT CITY

DISTRICT _____

DATE _____

P _____

A _____

_____ IS PERMITTED TO INSTALL _____ ALTER _____

ADDRESS _____ PHONE _____

A SEWAGE DISPOSAL-SYSTEM LOCATED AT _____

SUBDIVISION Woodmont ROAD _____ LOT 60, Blk. B

PROPERTY OWNER _____

ADDRESS _____

SPECIFICATIONS

DRAIN FIELD _____ DEPTH _____ FEET, BOTTOM AREA _____ SQ. FT.

SEEPAGE PITS _____ ABSORBENT SIDE-WALL AREA _____ SQ. FT.

SEPTIC TANK CAPACITY _____ GALLONS

FOR GARBAGE GRINDER, INCREASE DISPOSAL AREA 22% & TANK CAPACITY 50%.

OTHER _____

PLANS APPROVED BY _____ DATE _____

FILL SEPTIC TANK AND DISTRIBUTION BOX WITH WATER BEFORE CALLING FOR AN INSPECTION. COVER NO WORK UNTIL INSPECTED AND APPROVED.

NEITHER THE HOWARD COUNTY COMMISSIONERS NOR THE HEALTH DEPARTMENT IS RESPONSIBLE FOR THE SUCCESSFUL OPERATION OF ANY SYSTEM.

A