

# PERMIT

SEWAGE DISPOSAL SYSTEM  
MARYLAND STATE DEPARTMENT OF HEALTH

HOWARD COUNTY  
BUREAU OF ENVIRONMENTAL HEALTH  
461-9933

P 45286

A REPAIR

DISTRICT 3rd.

DATE 11/28/89

DATE SYSTEM APPROVED 12/21/89 as

INSPECTOR C. Williams per drawing

INDEXED

Jack Fyock IS PERMITTED TO INSTALL ALTER  X

ADDRESS \_\_\_\_\_ PHONE 988-9270

SUBDIVISION Woodmark ROAD 12337 Pam Spring Ct LOT 60

PROPERTY OWNER Raymond Jung

ADDRESS \_\_\_\_\_

IF GARBAGE GRINDER IS USED INCREASE SEPTIC TANK CAPACITY BY 50% AND ABSORPTION AREA BY 22%.

GARBAGE GRINDER? YES  NO \_\_\_\_\_

SEPTIC TANK CAPACITY 2000 GALLONS NUMBER OF BEDROOMS 4

REPAIR - CALL FOR INSPECTION WHEN GROUND IS OPENED SO SANITARIAN CAN RECOMMEND REPAIR.

inlet 6' off dry well 6'-12'  
100'  
2' wide  
Please submit drawing to

PLANS APPROVED BY C. Williams DATE 11/28/89

COVER NO WORK UNTIL INSPECTED AND APPROVED

NEITHER THE HOWARD COUNTY COUNCIL NOR THE HEALTH DEPARTMENT IS RESPONSIBLE FOR THE SUCCESSFUL OPERATION OF ANY SYSTEM


- NOTE: CLEANOUT REQUIRED EVERY 70 FEET OF SEWER LINE AND/OR AT 90° SWEEPS IN LINES FROM HOUSE TO DRAIN FIELDS
- NOTE: ALL PARTS OF SEPTIC SYSTEMS (I.E. TANK, DISTRIBUTION BOX, TRENCHES) TO BE 100 FEET FROM WELL (UNLESS OTHERWISE SPECIFICALLY AUTHORIZED)
- NOTE: IF DEEP TRENCH(IES) ARE USED CALL FOR INSPECTION BEFORE AND AFTER PLACING GRAVEL IN TRENCH(IES)
- NOTE: NO DRY WELL SHALL EXCEED 15 FOOT IN DIAMETER NO ABSORPTION TRENCH TO EXCEED 100 FEET IN LENGTH
- NOTE: ALL PIPE FROM HOUSE TO SEPTIC TANK MUST BE CAST IRON OR SCHEDULE 40 PVC OR ABS
- PERMIT VOID AFTER TWO YEARS
- NOTE: INSTALL STAND PIPE ON SEPTIC TANK AND DRY WELL. STAND PIPES MUST BE 6 INCHES IN DIAMETER. CAST IRON, CONCRETE OR TERRA COTTA OR PVC OR ABS ACCEPTED. IF TOP OF SEPTIC TANK IS DEEPER THAN 3 FEET, MANHOLE TO GRADE REQUIRED
- NOTE: DISTRIBUTION BOXES MUST HAVE BAFFLES

**\*INSTALLER IS RESPONSIBLE FOR OBTAINING FINAL APPROVAL ON THIS PERMIT**

**\*CALL 461-9933 FOR INSPECTION OF SEPTIC SYSTEMS.**

P45286

PAM SPRING COURT

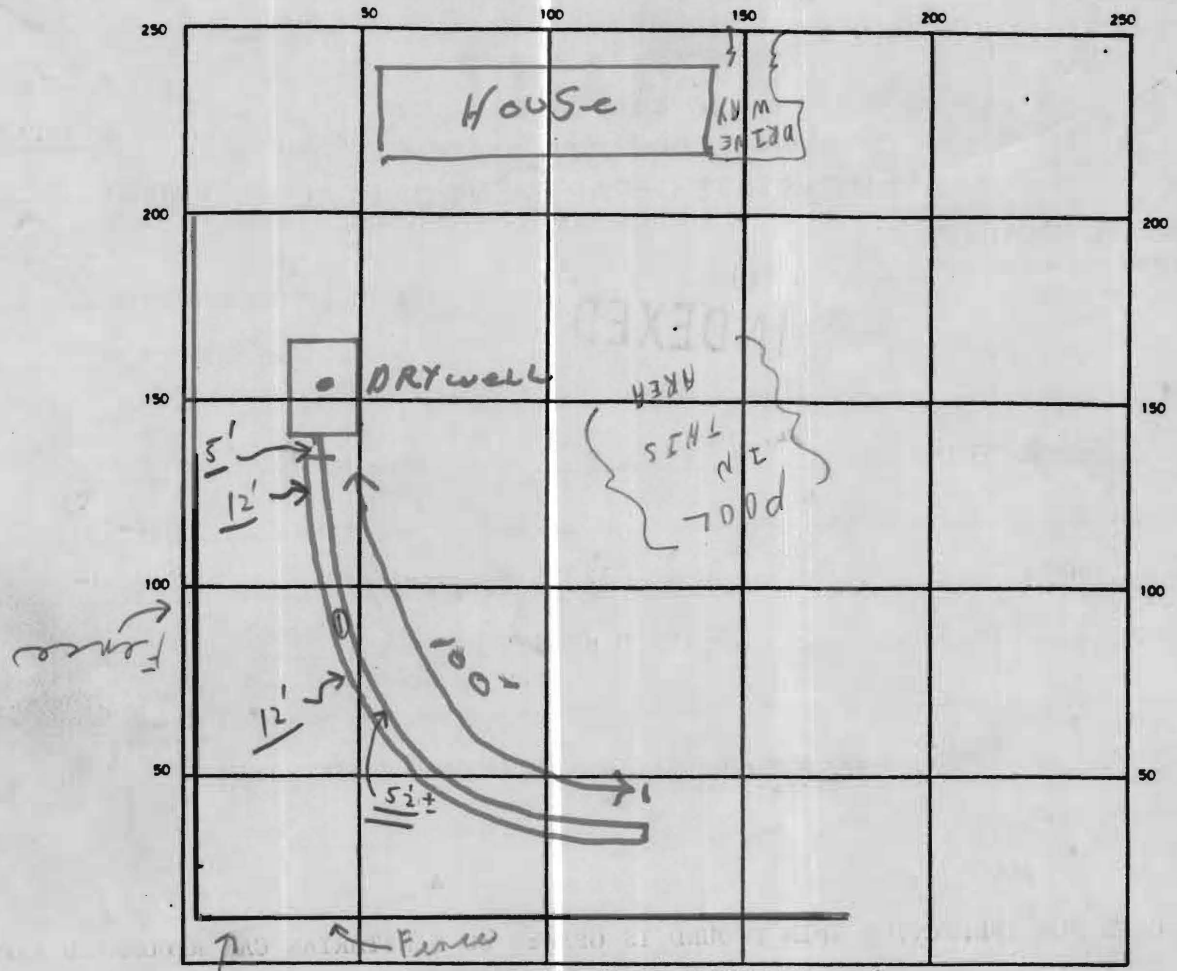

SEPTIC TANK LEVEL Existing CLEANOUTS Existing  
 DISTRIBUTION BOX LEVEL Non-applicable -  
 DRAIN FIELD/TILE FIELD DEPTH 12 FT. TRENCH WIDTH 2 FT. INLET DEPTH 6 ± FT.  
 EFFECTIVE GRAVEL DEPTH 6 FT. TOTAL LENGTH seen 52 ± per above 100 FT.  
 NUMBER OF TRENCHES 1 ONE SIDEWALL AREA 600 ± SQ. FT.  
 DRYWELL INSIDE DIAMETER      FT. EFFECTIVE DEPTH BELOW INLET      FT.  
 ABSORBENT AREA 600 ± SQ. FT.

REMARKS 12/-189 Red area drawn, by possibly Mr. Fyock, or his staff. 1/2 Partial, left permit, ok to continue work and to submit drawing. See above - approved as shown - files. C.B.S.

DATE SYSTEM APPROVED 12/21/89 per above INSPECTOR C.B.S. as directed