

C 1 1272 SEQUENCE NO. (DWR USE ONLY)

STATE OF MARYLAND WATER RESOURCES ADMINISTRATION TAWES STATE OFFICE BLDG., ANNAPOLIS, MD. 21401 WELL COMPLETION REPORT

THIS REPORT MUST BE SUBMITTED WITHIN 30 DAYS AFTER WELL COMPLETION FILL IN THIS FORM COMPLETELY COUNTY NUMBER

DATE RECEIVED (DWR USE ONLY) DATE WELL COMPLETED 6-17-73

DEPTH OF WELL 225 (TO NEAREST FOOT) PERMIT NO. FROM "PERMIT TO DRILL WELL" 40-73-1772

DRILLERS IDENTIFICATION NO. 120

OWNER Jung, Raymond F LAST NAME 210 N. Franklinton Road STREET OR RFD POST OFFICE Baltimore FIRST NAME

WELL LOG

STATE THE KIND OF FORMATIONS PENETRATED, THEIR COLOR, DEPTH, THICKNESS AND IF WATER BEARING

Table with columns: DESCRIPTION, FEET (FROM, TO), CHECK IF WATER BEARING. Rows include: Ovenbunden (0-6), Brown shale (6-41), Gray rock (41-225).

GROUTING RECORD

WELL HAS BEEN GROUTED (YES X NO N) TYPE OF GROUTING MATERIAL (C M B C) NO. OF BAGS 9 NO. OF POUNDS 900 GALLONS OF WATER 54 DEPTH OF GROUT SEAL (TO NEAREST FOOT) FROM 0 FT. TO 43 FT.

CASING RECORD

CASING TYPES (S T C O) MAIN CASING TYPE (S T) NOMINAL DIAMETER TOP (MAIN) CASING (NEAREST INCH) 6 TOTAL DEPTH OF MAIN CASING (NEAREST FOOT) 43

OTHER CASING (IF USED) DIAMETER (INCH) DEPTH (FEET) FROM TO

SCREEN RECORD

SCREEN TYPE OR OPEN HOLE (S T B R H O) PLASTIC OTHER

EACH SCREEN

Table for screen depths: FROM TO. Row 1: 8-9 (H O), 11-15, 17-21, 23-24, 26-30, 32-36, 38-39, 41-45, 47-51.

DIAMETER OF SCREEN 56 (NEAREST INCH) FROM TO

GRAVEL PACK

IF WELL DRILLED WAS A FLOWING WELL CIRCLE BOX 68 F

DWR USE ONLY (NOT TO BE FILLED IN BY DRILLER) TELESCOPE CASING LOG INDICATOR

PUMPING TEST

HOURS PUMPED (TO NEAREST HOUR) 6 PUMPING RATE (GALLONS PER MINUTE TO NEAREST GALLON) 6 METHOD USED TO MEASURE PUMPING RATE Submersible

WATER LEVEL: (DISTANCE FROM LAND SURFACE)

BEFORE PUMPING 34 (NEAREST FOOT) WHEN PUMPING 43 (NEAREST FOOT)

TYPE OF PUMPED USED (CIRCLE APPROPRIATE BOX)

AIR, PISTON, TURBINE, CENTRIFUGAL, ROTARY, OTHER, JET, SUBMERSIBLE

PUMP INSTALLED

TYPE OF PUMP (WRITE APPROPRIATE LETTER IN BOX - SEE ABOVE: A, C, J, P, R, S, T, O)

DRILLER WILL INSTALL PUMP (CIRCLE APPROPRIATE BOX) YES X NO N

CAPACITY: GALLONS PER MINUTE (TO NEAREST GALLON) 31 35

PUMP HORSE POWER 37 41

PUMP COLUMN LENGTH (NEAREST FOOT) 43 47

CASING HEIGHT (CIRCLE APPROPRIATE BOX AND ENTER CASING HEIGHT)

ABOVE, BELOW, LAND SURFACE (NEAREST FOOT) 49 50 51

LOCATION OF WELL ON LOT

SHOW PERMANENT STRUCTURE SUCH AS BUILDINGS, SEPTIC TANKS, AND/OR OTHER LAND MARKS AND INDICATE NOT LESS THAN TWO DISTANCES (MEASUREMENTS TO WELL).

CIRCLE APPROPRIATE BOXES A WELL WAS ABANDONED AND SEALED WHEN THIS WELL WAS COMPLETED ELECTRIC LOG OBTAINED TEST WELL CONVERTED TO PRODUCTION WELL

I HEREBY CERTIFY THAT I HAVE COMPLIED WITH ALL CONDITIONS STATED ON THE ABOVE-CAPTIONED "PERMIT TO DRILL WELL", AND THAT INFORMATION CONTAINED IN THIS REPORT IS TRUE, ACCURATE, AND COMPLETE TO THE BEST OF MY KNOWLEDGE, INFORMATION AND BELIEF.

DRILLERS NAME G. Edgar Harr Sons Corp SIGNATURE

Pitless Adapter

S 85° 52' 49" E 163.93'

5' UTILITY EASEMENT

19,000 GALS
SEPTIC
RESERVE
AREA

PROPOSED 48"
SPLIT RAIL FENCE
E CODE

PLOT PLAN

SCALE
1" = 40' 0"

N 04° 07' 11" E 281.37'

N 04° 07' 11" E 281.37'

DRIVEWAY ACCESS

GAR.

PATIO

PATIO

HOUSE

SEPTIC TANK


101

WELL
86' FROM POOL


110-23-1273

S 83° 52' 49" E 163.93'

PAN'S SPRING COURT

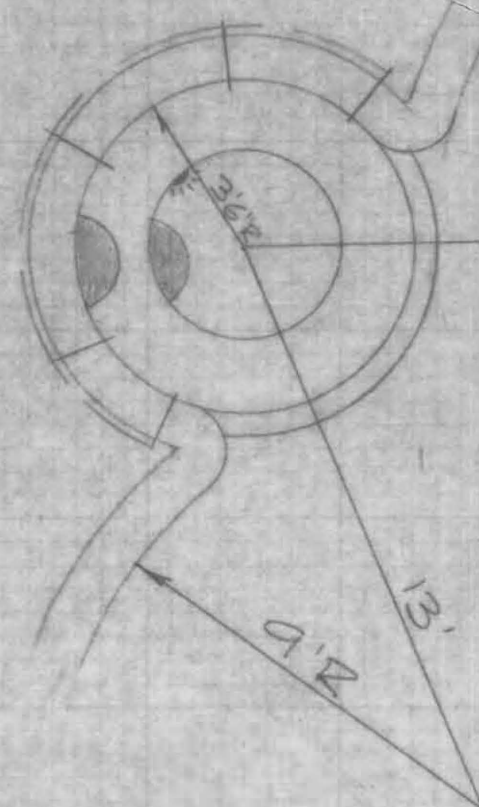

1:40

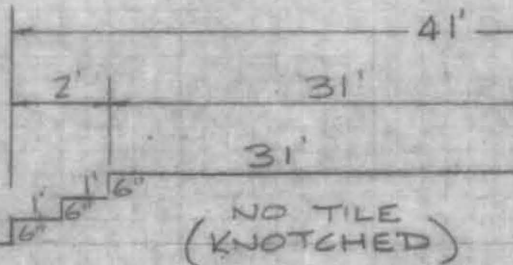

RAISED BOND
NOT TO