

7  
0 S.F.  
ED  
KQ

LOT 8  
S.F.  
EPMS

32  
50' BRL

900  
4A  
30' BRL  
901  
802  
20A  
30' BRL

LOT 13  
45,636 S.F.

FRONT

FRONT

LOT 6  
33,000 S.F.  
SHARED SEPTIC

LOT 5  
33,000 S.F.  
SHARED SEPTIC

LOT 9  
33,000 S.F.  
SHARED SEPTIC

FRONT

FRONT

RYON

FRONT

FRONT


FRONT

FRONT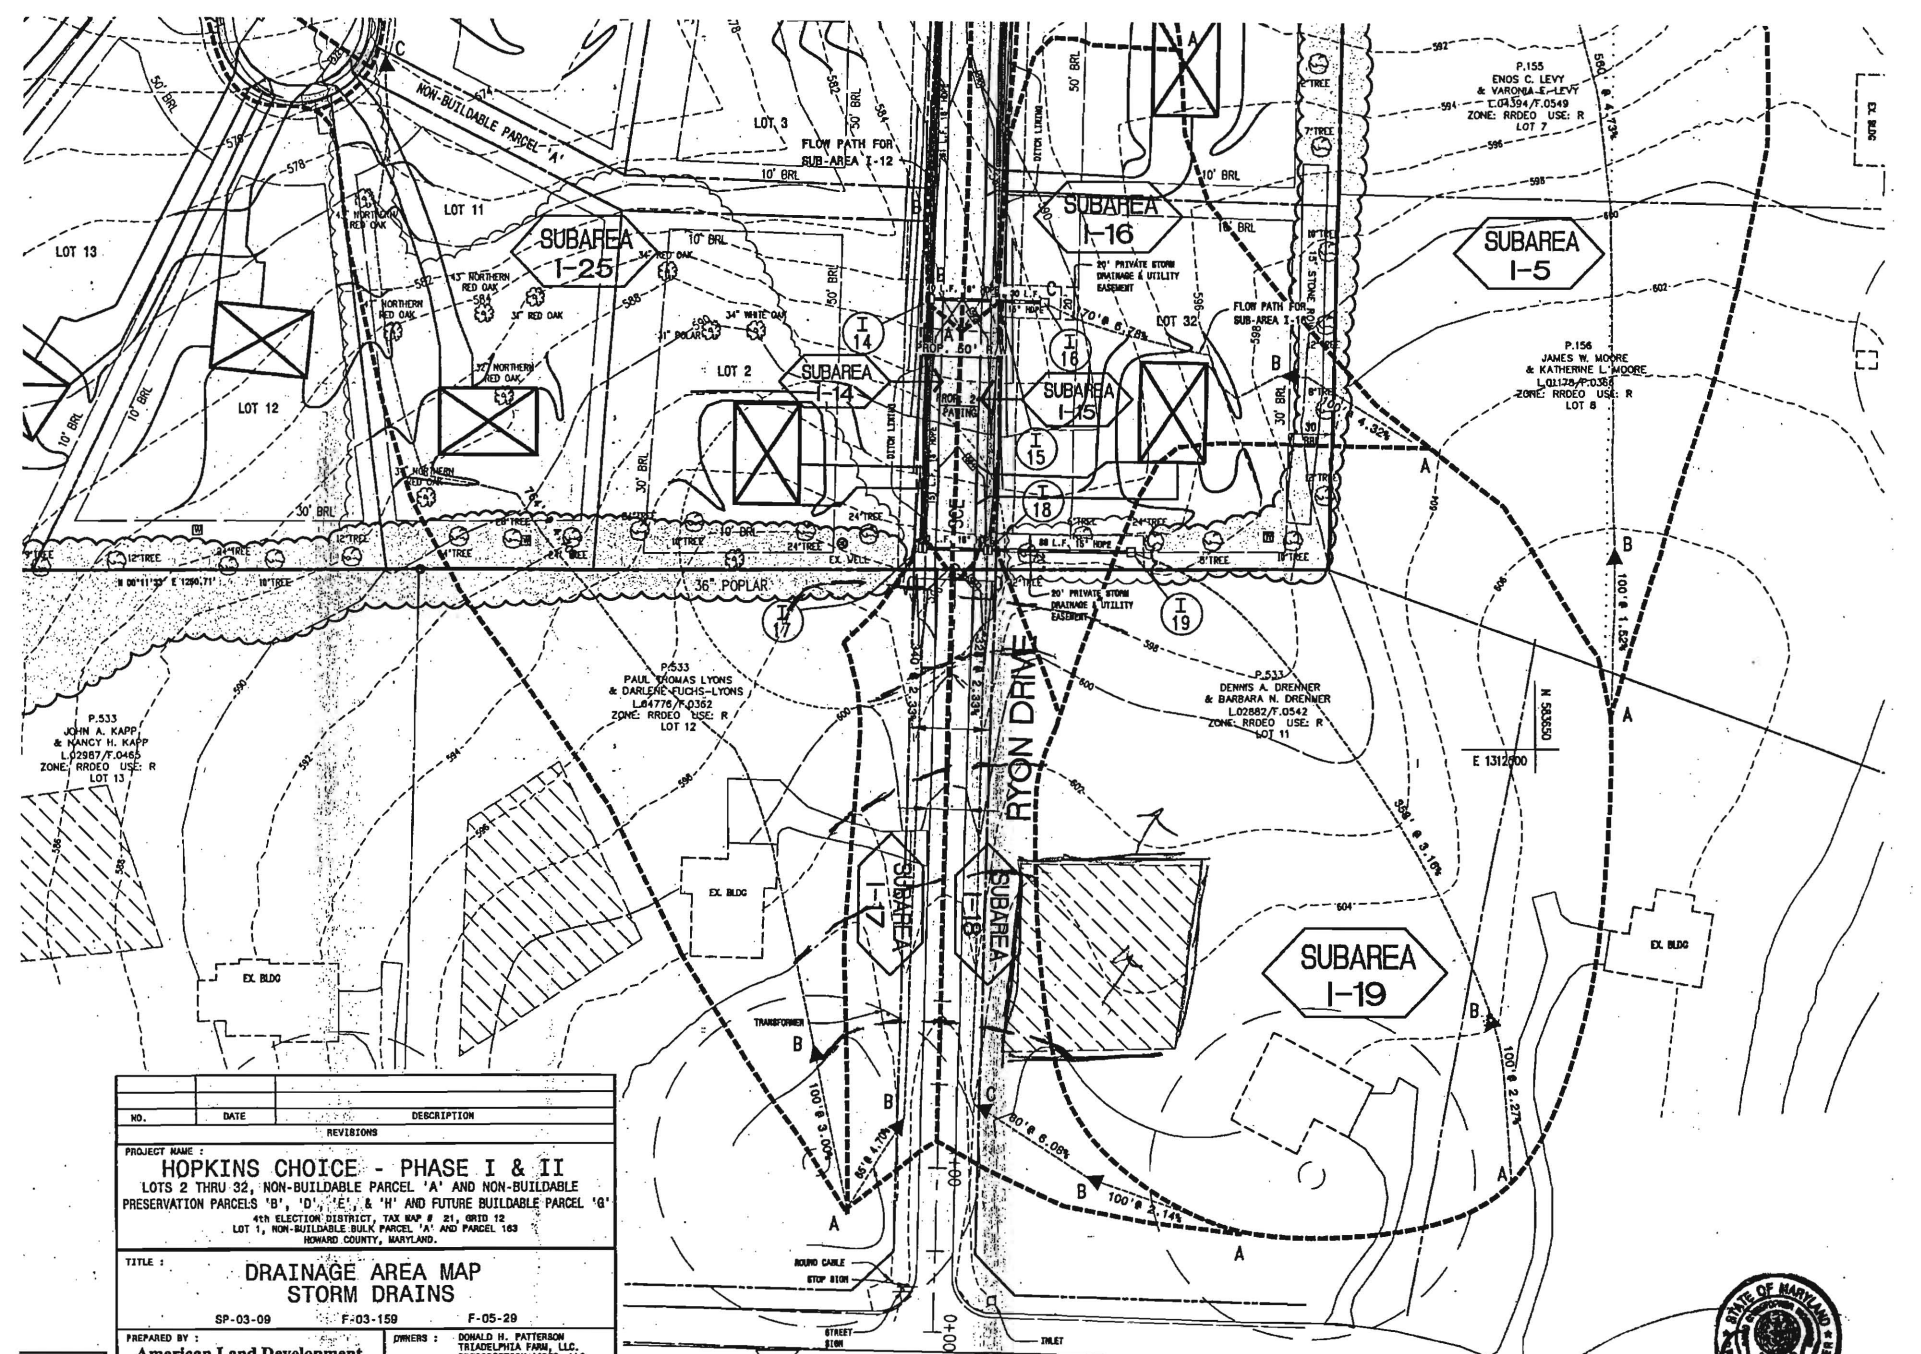

NO.	DATE	DESCRIPTION
REVISIONS		
PROJECT NAME :		
<b>HOPKINS CHOICE - PHASE I &amp; II</b>		
LOTS 2 THRU 32, NON-BUILDABLE PARCEL 'A' AND NON-BUILDABLE PRESERVATION PARCELS 'B', 'D', 'E', & 'H' AND FUTURE BUILDABLE PARCEL 'G'		
4th ELECTION DISTRICT, TAX MAP # 21, GRID 12		
LOT 1, NON-BUILDABLE BULK PARCEL 'A' AND PARCEL 163		
HOWARD COUNTY, MARYLAND.		
TITLE :		
<b>DRAINAGE AREA MAP</b>		
<b>STORM DRAINS</b>		
SP-03-09	F-03-159	F-05-29
PREPARED BY :	OWNERS :	
<b>American Land Development and Engineering, Inc.</b>	DONALD H. PATTERSON TRIADDELPHIA FARM, LLC PRESCRIPTION MOSES, LLC c/o DONALD H. PATTERSON PO BOX 1 GLEBELS, MD. 21737	
10748 BIRMINGHAM WAY WOODSTOCK, MD. 21153 TEL. (410) 465-7903 FAX. (410) 465-3946	DEVELOPER : TRIADDELPHIA FARM, LLC. 6239 CARDINAL LANE COLUMBIA, MD. 21044	
DES. : JHE/AVG	JOB :	SCALE :
DRW. : AVG	PROJ. :	1" = 60'
CHK. : DCW	DATE : MAY 17, 2005	SHEET 7 OF 22



**DRAINAGE AREA MAP - STORM DRAINS**

F-05-29