

PRELIMINARY

APPLICATION

A 21535

SEWAGE DISPOSAL TESTING

P _____

STATE OF MARYLAND - DEPARTMENT OF HEALTH AND MENTAL HYGIENE

DISTRICT 3rd

HOWARD COUNTY HEALTH DEPARTMENT
ENVIRONMENTAL HEALTH SERVICES

DATE 5/20/75

P. O. BOX 476, ELLICOTT CITY, MARYLAND 21043
TELEPHONE: 485-5000, EXT. 358

6/10/75
9:30 A.M.

3 B.R. 1000 gal. septic tank | 4 B.R. 1250 gal. septic tank
Drywell to have 125 sq. ft. effective sidewall absorption area per bedroom to begin below the first 4 ft of non-porous soil. Maximum depth permitted for drywell is 12 ft. below original grade. Place the drywell 10 ft. from the ^{left} right side line and 210 ft. from the front lot line, as seen when facing the property from Driver Road.

TO: THE COUNTY HEALTH OFFICER
ELLICOTT CITY, MARYLAND

I, HEREBY, APPLY FOR THE NECESSARY TEST IN ORDER TO CONSTRUCT (OR RECONSTRUCT) A SEWAGE DISPOSAL SYSTEM.

PROPERTY OWNER Nickolas & Mary Frances Antonis

ADDRESS 1251 Locust Avenue, Baltimore, Md. 21227 PHONE 242-8915

PROPERTY LOCATION:

SUBDIVISION _____ LOT NO. _____

ROAD AND DESCRIPTION Driver Road - Use end of Driver road that comes in by Post Office
Lot is 15 acres on right hand side.

SIZE OF LOT 15 acres TYPE BLDG. 3 or 4 bedrooms
NUMBER OF BEDROOMS

IF NOT SINGLE RESIDENCE DESCRIBE _____

THE SYSTEM INSTALLED UNDER THIS APPLICATION IS ACCEPTABLE ONLY UNTIL PUBLIC FACILITIES BECOME AVAILABLE.

SIGNATURE OF APPLICANT /s/ Pat Lendrim

APPROVED BY Frank Skinner FOR Drywell DATE 8/1/75
(KIND OF SYSTEM)

REJECTED BY _____ FOR _____ DATE _____
(KIND OF SYSTEM)




HOLD PENDING FURTHER TESTS _____ DATE _____

REASONS FOR REJECTION OR HOLDING _____
BLDG PERMIT SIGNED AND RETURNED 8/2/75

THIS IS NOT A PERMIT

A 21535

Soil Profiles

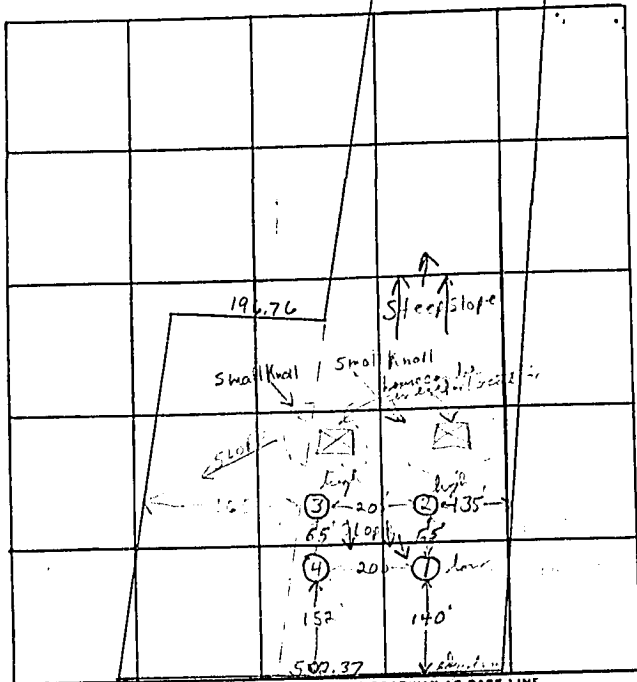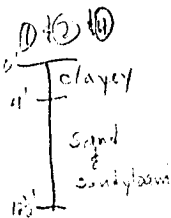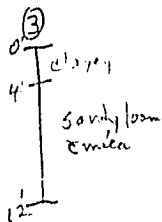

15 acres.

Nicholas & Mary Frances Antonic

Careful to not be ground on right side (15 ac.)

INDICATE NORTH - NAME ADJOINING ROADWAY AS BASE LINE

Driver Road

DATE	TEST NO.	DEPTH	PRE-WET		TEST - 1" DROP		TIME	
			START	STOP	START	STOP		
6/10/75	1 low	4 1/2'	10:19	10:21	10:21	11:27	6 min	
	1A	12 1/2'	10:18	10:20	10:26	10:22	2 min	
	2 hix	4 1/2'	10:30	10:33	10:33	10:38	5 min	
	2A	12'	10:31	10:33	10:33	10:35	2 min	
	3 hix	5'	10:41	10:46	10:46	11:56	10 min	
	3A	12'	10:45	10:48	10:48	11:53	5 min	
	4	12'	Visually clayey to 4' sandy loam below					

Gummy soil 4'

REMARKS (2)-(3)-(4) all about the same character

TYPE OF SOIL sand & sandy loam below top 4' clayey soil

TESTED BY F.S. ALSO PRESENT: P. Leudvian