

C1 9257

SEQUENCE NO. (MDE USE ONLY)

STATE OF MARYLAND WELL COMPLETION REPORT

THIS REPORT MUST BE SUBMITTED WITHIN 45 DAYS AFTER WELL IS COMPLETED.

(THIS NUMBER IS TO BE PUNCHED IN COLS. 3-6 ON ALL CARDS)

COUNTY NUMBER HO-95-1782

DATE RECEIVED MM DD YY

DATE WELL COMPLETED 2/25/09

DEPTH OF WELL 600

PERMIT NO. FROM "PERMIT TO DRILL WELL" 40-95-1687

OWNER RINGHARDT, STREET OR RFD 18571 PENN SHIP, TOWN WELL #1 MEADING

WELL LOG

Not required for driven wells

STATE THE KIND OF FORMATIONS PENETRATED, THEIR COLOR, DEPTH, THICKNESS AND IF WATER BEARING

Table with columns: DESCRIPTION, FEET (FROM, TO), check if water bearing. Rows include Top Soil, Brown slate, Grey slate, Purple slate, etc.

GROUTING RECORD

WELL HAS BEEN GROUTED (Y/N), TYPE OF GROUTING MATERIAL (CEMENT, BENTONITE CLAY), NO. OF BAGS, NO. OF POUNDS, GALLONS OF WATER, DEPTH OF GROUT SEAL

CASING RECORD

MAIN CASING TYPE (ST, PL), Nominal diameter top (main) casing, Total depth of main casing

OTHER CASING (if used)

Table for other casing with columns for diameter and depth

SCREEN RECORD

screen type or open hole (ST, BR, HO, PL, OT)

DEPTH (nearest ft.)

Table for depth measurements with columns for casing height and slot size

DIAMETER OF SCREEN (NEAREST INCH), from to

GRAVEL PACK IF WELL DRILLED WAS FLOWING WELL

MDE USE ONLY (NOT TO BE FILLED IN BY DRILLER)

TELESCOPE CASING, LOG INDICATOR, OTHER DATA

C3

Low yield PUMPING TEST

HOURS PUMPED, PUMPING RATE, METHOD USED TO MEASURE PUMPING RATE, WATER LEVEL, TYPE OF PUMP USED

PUMP INSTALLED

DRILLER INSTALLED PUMP (YES/NO), TYPE OF PUMP INSTALLED PLACE, CAPACITY: GALLONS PER MINUTE

PUMP HORSE POWER, PUMP COLUMN LENGTH

CASING HEIGHT, LAND SURFACE

LOCATION OF WELL ON LOT, SHOW PERMANENT STRUCTURE SUCH AS BUILDING, SEPTIC TANKS, AND /OR LANDMARKS

NUMBER OF UNSUCCESSFUL WELLS: 0

WELL HYDROFRACTURED (Y/N)

CIRCLE APPROPRIATE LETTER: A, E, P

I HEREBY CERTIFY THAT THIS WELL HAS BEEN CONSTRUCTED IN ACCORDANCE WITH COMAR 26.04.04

DRILLERS LIC. NO. 1 MW D040, DRILLERS SIGNATURE

LIC. NO. 1 AV D288

SITE SUPERVISOR (sign. of driller or journeyman responsible for sitework if different from permittee)

B 1 2600
1 2 3 6

SEQUENCE NO.
(MDE USE ONLY)

STATE OF MARYLAND
APPLICATION FOR PERMIT TO DRILL WELL

531055 please type

STATE PERMIT NUMBER

HO-95-1782
fill in this form completely

Date Received (APA)

11047

OWNER INFORMATION

8 MM DD YY 13

RINEHARDT EDWIN
15 Last Name Owner First Name 34

18571 PENN SHOP RD
36 Street or RFD 55

MOUNT AIRY, MD 21771-3614
57 Town 70 State 72 Zip 76

DRILLER INFORMATION

George F. Easterday M W D Y 040
Driller's Name 76 License No. 81

L. Franklin Easterday, Inc.
Firm Name

9265 Brown Church Rd., MT. Airy, Md. 21771
Address

George F. Easterday 6-18-09
Signature Date 2/25/2009

B 3

LOCATION OF WELL

Howard CC#
8 COUNTY 21

Reinhardt
23 SUBDIVISION 42


SECTION 44 46 LOT 48 50

Mt. Airy
52 NEAREST TOWN 71

MILES FROM TOWN (enter 0 if in town) 1 MI
73 76 77 78

B 4

DIRECTION OF WELL FROM TOWN (CIRCLE BOX)

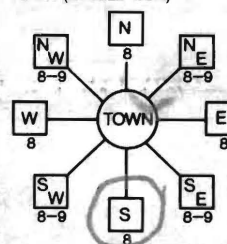

Penn Shop Road (18571)
11 NEAR WHAT ROAD 30

ON WHICH SIDE OF ROAD (CIRCLE APPROPRIATE BOX)

34 50 37
DISTANCE FROM ROAD Ft

ENTER FT OR MI 38 39

TAX MAP: 6 BLK: 3 PARCEL 124

B 2

WELL INFORMATION

APPROX. PUMPING RATE 5
(GAL. PER MIN.) 8 12

AVERAGE DAILY QUANTITY NEEDED 500
(GAL. PER DAY) 14 20

USE FOR WATER (CIRCLE APPROPRIATE BOX)

- D DOMESTIC POTABLE SUPPLY & RESIDENTIAL IRRIGATION
 - F FARMING (LIVESTOCK WATERING & AGRICULTURAL IRRIGATION)
 - I INDUSTRIAL, COMMERCIAL, DEWATERING
 - P PUBLIC WATER SUPPLY WELL
 - T TEST, OBSERVATION, MONITORING
 - G GEO-THERMAL
- Convert dry-hole to geo therm

NOT TO BE FILLED IN BY DRILLER HEALTH DEPARTMENT APPROVAL

Howard AS27893
COUNTY NAME COUNTY NO.

STATE SIGNATURE INSERT S 41

DATE ISSUED 7/1/09 State Dept 7/1/10
43 MM DD YY 48 CO SIGNATURE EXP. DATE

NORTH GRID 551 000 EAST GRID 753 000
50 55 57 63

APPROXIMATE DEPTH OF WELL 300 FEET
24 28

APPROXIMATE DIAMETER OF WELL 6 INCH NEAREST

METHOD OF DRILLING (circle one)

BORED (or Augered) JETTED Jetted & DRIVEN
30 AIR-ROTary AIR-PERcussion ROTARY (Hydraulic Rotary)
37 CABLE REVerse-ROTary DRive-POINT
other

REPLACEMENT OR DEEPEMED WELLS (CIRCLE APPROPRIATE BOX)

- N THIS WELL WILL NOT REPLACE AN EXISTING WELL
- Y THIS WELL WILL REPLACE A WELL THAT WILL BE ABANDONED AND SEALED
- S THIS WELL WILL REPLACE A WELL THAT WILL BE USED AS A STANDBY-CONTACT LOCAL APPROVING AUTHORITY FOR POLICY ON STANDBY WELLS
- D THIS WELL WILL DEEPEN AN EXISTING WELL

PERMIT NUMBER OF WELL TO BE REPLACED OR DEEPEMED (IF AVAILABLE) 41 52

Not to be filled in by driller (MDE OR COUNTY USE ONLY)

APPROP. PERMIT NUMBER G
PERMIT No. HO-95-1782
70 71 72 73 74 75 76 77 78 79


SHOW MAJOR FEATURES OF BOX & LOCATE WELL WITH AN X

SOURCES OF DRILLING WATER
1.
2.
3. wells

WRITE THE BOX NUMBER FROM THE MAP HERE

E 758 3
N 551 1

DRAW A SKETCH BELOW SHOWING LOCATION OF WELL IN RELATION TO NEARBY TOWNS AND ROADS AND GIVE DISTANCE FROM WELL TO NEAREST ROAD JUNCTION 2A8

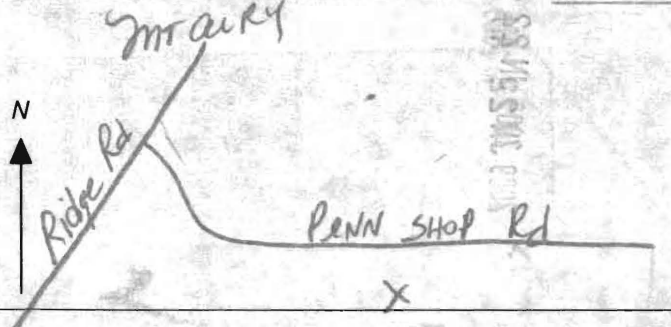

SPECIAL CONDITIONS

NOTE - APPROVING AUTHORITIES SHOULD USE SEPARATE SHEET IF NEEDED

