

9/19/75
Randy

PERMIT

HOLD APPROVAL UNTILL PIPE IS
CONNECTED FROM
S.T TO HSE IN
9-17-75
P 21953
A 21535

SEWAGE DISPOSAL SYSTEM

MARYLAND STATE DEPARTMENT OF HEALTH

HOWARD COUNTY

ELLICOTT CITY

DISTRICT 3rd

DATE 8/13/75

Final
3/5/76
INDEXED
Fule

Ten Oaks Construction Company

IS PERMITTED TO INSTALL ALTER

ADDRESS Ten Oaks Road, Baltimore, Md. 21227

PHONE 242-9515

A SEWAGE DISPOSAL SYSTEM LOCATED AT

SUBDIVISION ROAD Driver Road LOT

PROPERTY OWNER Nickolas & Mary F. Antonis

ADDRESS 1251 Locust Avenue, Baltimore, Md. 21227

Phone: 242-8915

SPECIFICATIONS 4 bedrooms

DRAIN FIELD DEPTH FEET, BOTTOM AREA SQ. FT.

SEEPAGE PITS ABSORBENT SIDE-WALL AREA SQ. FT.

SEPTIC TANK CAPACITY 1250 GALLONS

FOR GARBAGE GRINDER, INCREASE DISPOSAL AREA 22% & TANK CAPACITY 50%.

OTHER DRY WELL - To have 125 sq. ft. effective sidewall absorption area per bedroom to begin below the first 4 ft. of non-porous soil. Maximum depth permitted for dry well is 12 ft. below original grade. Place the dry well 165 ft. from the left side line and 210 ft. from the front lot line as seen when facing the property from Driver Road.

NOTE: ALL PIPE FROM HOUSE TO DISPOSAL AREA MUST BE CAST IRON.
PERMIT VOID AFTER THREE YEARS.

NOTE: INSTALL STAND PIPE ON SEPTIC TANK AND DRY WELL. STAND PIPES MUST BE 6 INCHES IN DIAMETER. CAST IRON, CONCRETE OR TERRA COTTA ACCEPTED.


PLANS APPROVED BY Frank Skinner DATE 8/1/75

FILL SEPTIC TANK AND DISTRIBUTION BOX WITH WATER BEFORE CALLING FOR AN INSPECTION. COVER NO WORK UNTIL INSPECTED AND APPROVED.

NEITHER THE HOWARD COUNTY COMMISSIONERS NOR THE HEALTH DEPARTMENT IS RESPONSIBLE FOR THE SUCCESSFUL OPERATION OF ANY SYSTEM.

A 21535

21535

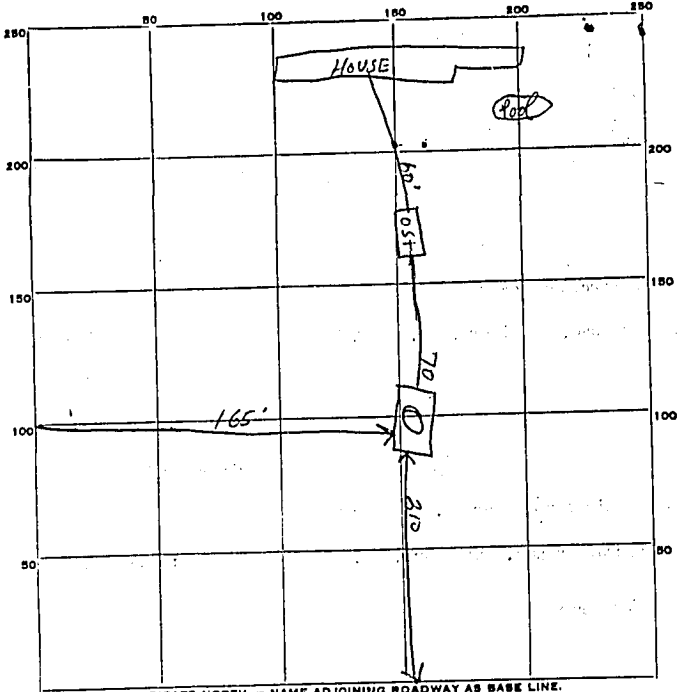

PERMIT CARD PRESENT

SEPTIC TANK, LEVEL OK 1250 CLEANOUTS OK ST

DISTRIBUTION BOX, LEVEL N/A

TILE FIELD, DEPTH N/A FT. TRENCH WIDTH N/A FT.

GRAVEL DEPTH N/A IN. TOTAL LENGTH N/A FT.

NUMBER OF TRENCHES 0 TOTAL BOTTOM AREA N/A

SEEPAGE PITS, ^{OUTSIDE PERIMETER} ~~INSIDE PERIMETER~~ 64 FT. DEPTH BELOW INLET 8 FT.

ABSORBENT AREA 51V SQ. FT.

REMARKS 9-17-75 OK to Cover - 112 - CALL, H.O. WHEN PIPE IS CONNECTED
FROM ST TO HOUSE H.J.V.

DATE SYSTEM APPROVED 9/17/75 INSPECTOR [Signature]

3/5/76 - Cast iron leach ^{line} basement R. T. Toner