

SEQUENCE NO. (MDE USE ONLY)

7293

# STATE OF MARYLAND WELL COMPLETION REPORT

FILL IN THIS FORM COMPLETELY  
PLEASE TYPE

THIS REPORT MUST BE SUBMITTED WITHIN  
45 DAYS AFTER WELL IS COMPLETED.

COUNTY  
NUMBER

1 2 3 6  
(THIS NUMBER IS TO BE PUNCHED  
IN COLS. 3-6 ON ALL CARDS)

ST/CO USE ONLY  
DATE RECEIVED  
MM DD YY  
8 13

DATE WELL COMPLETED  
MM DD YY  
12 5 07

Depth of Well  
22 300 26  
(TO NEAREST FOOT)

PERMIT NO.  
FROM "PERMIT TO DRILL WELL"  
HO - 81 - 02410  
28 29 30 31 32 33 34 35 36 37

OWNER: Moh N Harold  
STREET OR RFD: 995 Sunset Valley Ct TOWN: Sykesville  
SUBDIVISION: \_\_\_\_\_ SECTION: \_\_\_\_\_ LOT: \_\_\_\_\_

**WELL LOG**  
Not required for driven wells

STATE THE KIND OF FORMATIONS PENETRATED, THEIR COLOR, DEPTH, THICKNESS AND IF WATER BEARING

DESCRIPTION (Use additional sheets if needed)	FEET		check if water bearing
	FROM	TO	
Drilled well deeper from 43' to 300' deep.			

**GROUTING RECORD** yes no  
WELL HAS BEEN GROUTED (Circle Appropriate Box)  Y  N  
TYPE OF GROUTING MATERIAL (Circle one)  
CEMENT  CM BENTONITE CLAY  BC  
NO. OF BAGS \_\_\_\_\_ NO. OF POUNDS \_\_\_\_\_  
GALLONS OF WATER \_\_\_\_\_  
DEPTH OF GROUT SEAL (to nearest foot)  
from \_\_\_\_\_ ft. to \_\_\_\_\_ ft.  
(enter 0 if from surface)

**CASING RECORD**  
casing types insert appropriate code below  
STEEL  ST CONCRETE  CO  
PLASTIC  PL OTHER  OT  
MAIN CASING TYPE Nominal diameter top (main) casing (nearest inch)! Total depth of main casing (nearest foot)  
60 61 63 64 66 70

**OTHER CASING (if used)**  
EACH CASING diameter inch depth (feet) from to  
ST 5 35 140

**SCREEN RECORD**  
screen type or open hole insert appropriate code below  
STEEL  ST BRASS  BR OPEN HOLE  HO  
BRONZE  PL PLASTIC  PL OTHER  OT

**C 3**  
1 2

**PUMPING TEST**  
HOURS PUMPED (nearest hour) 01  
PUMPING RATE (gal. per min.) 10  
METHOD USED TO MEASURE PUMPING RATE 1964  
WATER LEVEL (distance from land surface)  
BEFORE PUMPING 30 ft.  
WHEN PUMPING 290 ft.  
TYPE OF PUMP USED (for test)  
 A air  P piston  T turbine  
 C centrifugal  R rotary  O other (describe below)  
 J jet  S submersible

**PUMP INSTALLED**  
DRILLER INSTALLED PUMP (CIRCLE) (YES or NO)  YES  NO  
IF DRILLER INSTALLS PUMP, THIS SECTION MUST BE COMPLETED FOR ALL WELLS.  
TYPE OF PUMP INSTALLED PLACE (A,C,J,P,R,S,T,O) IN BOX 29. S  
CAPACITY: GALLONS PER MINUTE (to nearest gallon) 7  
PUMP HORSE POWER 3/4  
PUMP COLUMN LENGTH (nearest ft.) 280  
CASING HEIGHT (circle appropriate box and enter casing height)  
 + above } LAND SURFACE  
 - below } 01 (nearest foot)

NUMBER OF UNSUCCESSFUL WELLS: 0

WELL HYDROFRACTURED  Y  N

CIRCLE APPROPRIATE LETTER  
A A WELL WAS ABANDONED AND SEALED WHEN THIS WELL WAS COMPLETED  
E ELECTRIC LOG OBTAINED  
P TEST WELL CONVERTED TO PRODUCTION WELL

**C 2**  
1 2

DEPTH (nearest ft.)	1	2	3	4	5	
E 1	8	9	11	15	17	21
A 2	23	24	26	30	32	36
S 3	38	39	41	45	47	51

SLOT SIZE 1 \_\_\_\_\_ 2 \_\_\_\_\_ 3 \_\_\_\_\_


DIAMETER OF SCREEN (NEAREST INCH)  
from \_\_\_\_\_ to \_\_\_\_\_

I HEREBY CERTIFY THAT THIS WELL HAS BEEN CONSTRUCTED IN ACCORDANCE WITH COMAR 26.04.04 "WELL CONSTRUCTION" AND IN CONFORMANCE WITH ALL CONDITIONS STATED IN THE ABOVE CAPTIONED PERMIT, AND THAT THE INFORMATION PRESENTED HEREIN IS ACCURATE AND COMPLETE TO THE BEST OF MY KNOWLEDGE.

DRILLERS LIC. NO. M 5D 009  
DRILLERS SIGNATURE \_\_\_\_\_  
LIC. NO. D

GRAVEL PACK IF WELL DRILLED WAS FLOWING WELL INSERT F IN BOX 68 \_\_\_\_\_

MDE USE ONLY (NOT TO BE FILLED IN BY DRILLER)  
T (E.R.O.S.) W Q  
70 \_\_\_\_\_ 72 \_\_\_\_\_  
TELESCOPE CASING LOG INDICATOR OTHER DATA

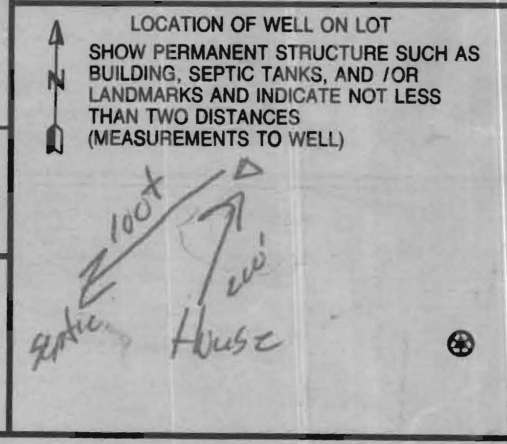

1 2 3 4 5 6  
(THIS NUMBER IS TO BE PUNCHED IN COLS. 3-8 ON ALL CARDS)

FILL IN THIS FORM COMPLETELY PLEASE TYPE

NUMBER

ST/CO USE ONLY  
DATE RECEIVED  
JAN 22 2008

DATE WELL COMPLETED  
12 5 07

Depth of Well  
300  
(TO NEAREST FOOT)  
2/2/08  
O.K. (BR)

PERMIT NO.  
FROM "PERMIT TO DRILL WELL"  
HO-81-0240

OWNER: Main  
STREET OR RFD: 995 Sunset Valley Ct  
TOWN: Spessville  
SUBDIVISION: SECTION: LOT:

WELL LOG  
Not required for driven wells

STATE THE KIND OF FORMATIONS PENETRATED, THEIR COLOR, DEPTH, THICKNESS AND IF WATER BEARING

DESCRIPTION (Use additional sheets if needed)	FEET		check if water bearing
	FROM	TO	
Drilled well deeper from 43' to 300' deep.			

GROUTING RECORD

WELL HAS BEEN GROUTED (Circle Appropriate Box) YES (X) NO (N)  
TYPE OF GROUTING MATERIAL (Circle one) CEMENT (CM) BENTONITE CLAY (BC)  
NO. OF BAGS: 45 46 NO. OF POUNDS: 45 48  
GALLONS OF WATER: \_\_\_\_\_  
DEPTH OF GROUT SEAL (to nearest foot)  
from 45 TOP 52 ft. 54 BOTTOM 58 ft.  
(enter 0 if from surface)

CASING RECORD

casings types insert appropriate code below  
MAIN CASING TYPE: ST (STEEL), PL (PLASTIC), CO (CONCRETE), OT (OTHER)  
Nominal diameter top (main) casing (nearest inch): 80 81 83 84 86 87  
Total depth of main casing (nearest foot): 80 81 83 84 86 87

OTHER CASING (if used) diameter inch from to depth (feet)  
ST 5 35 140

SORREN RECORD

screen type or open hole: ST (STEEL), BR (BRASS), PL (PLASTIC), HO (OPEN HOLE), OT (OTHER)  
DEPTH (nearest ft.): G 2 HO 140 300

NUMBER OF UNSUCCESSFUL WELLS: 0

WELL HYDROFRACTURED: YES (Y) NO (N)

CIRCLE APPROPRIATE LETTER  
A A WELL WAS ABANDONED AND SEALED WHEN THIS WELL WAS COMPLETED  
E ELECTRIC LOG OBTAINED  
P TEST WELL CONVERTED TO PRODUCTION WELL

I HEREBY CERTIFY THAT THIS WELL HAS BEEN CONSTRUCTED IN ACCORDANCE WITH COMAR 28.04.04 "WELL CONSTRUCTION" AND IN CONFORMANCE WITH ALL CONDITIONS STATED IN THE ABOVE CAPTIONED PERMIT, AND THAT THE INFORMATION PRESENTED HEREIN IS ACCURATE AND COMPLETE TO THE BEST OF MY KNOWLEDGE.

DRILLERS LIC. NO.: M 5D 009  
DRILLERS SIGNATURE: Allen Compton

LIC. NO.: M 5D 009  
Allen Compton

SITE SUPERVISOR (sign. of driller or journeyman responsible for sitework if different from permittee)

DEPTH (nearest ft.)  
E 0 9 11 15 17 21  
A 23 24 26 30 32 36  
C 38 39 41 45 47 51  
S  
R  
E  
N  
SLOT SIZE 1 2 3  
DIAMETER OF SCREEN (NEAREST INCH)  
from 58 60 to

GRAVEL PACK IF WELL DRILLED WAS FLOWING WELL INSERT F IN BOX 88

MDE USE ONLY (NOT TO BE FILLED IN BY DRILLER) (E.R.O.S.)  
T W O  
70 72 74 75 76  
TELESCOPE CASING LOG INDICATOR OTHER DATA

PUMPING TEST

HOURS PUMPED (nearest hour) 01  
PUMPING RATE (gal. per min.) 10  
METHOD USED TO MEASURE PUMPING RATE 1506  
WATER LEVEL (distance from land surface)  
BEFORE PUMPING 30 ft.  
WHEN PUMPING 290 ft.  
TYPE OF PUMP USED (for test)  
A (jet), P (pliston), T (turbine), C (centrifugal), R (rotary), O (other), J (jet), S (submersible)

PUMP INSTALLED

DRILLER INSTALLED PUMP (CIRCLE) YES (X) NO  
IF DRILLER INSTALLS PUMP, THIS SECTION MUST BE COMPLETED FOR ALL WELLS.  
TYPE OF PUMP INSTALLED PLACE (A,C,I,P,R,S,T,O) IN BOX 29: S  
CAPACITY: GALLONS PER MINUTE (to nearest gallon) 7  
PUMP HORSE POWER 3/4  
PUMP COLUMN LENGTH (nearest ft.) 280  
CASING HEIGHT (circle appropriate box and enter casing height) (+) above, (-) below LAND SURFACE 01 (nearest foot)

LOCATION OF WELL ON LOT  
SHOW PERMANENT STRUCTURE SUCH / BUILDING, SEPTIC TANKS, AND /OR LANDMARKS AND INDICATE NOT LESS THAN TWO DISTANCES (MEASUREMENTS TO WELL)  
30' to septic tank, 100' to house