

1/16/67 - Approved J.H.H.

PERMIT

P 12395

A 12095

SEWAGE DISPOSAL SYSTEM

MARYLAND STATE DEPARTMENT OF HEALTH

HOWARD COUNTY

ELLICOTT CITY

DISTRICT 3

DATE 1/16/67

INDEXED

Excavating Contractors, Inc. IS PERMITTED TO INSTALL ALTER

ADDRESS Ellicott City, Maryland PHONE HO 5-3849

A SEWAGE DISPOSAL SYSTEM LOCATED AT _____

SUBDIVISION _____ ROAD Driver Rd. - 1st house 1

PROPERTY OWNER Gordon S. Wolfel on right under construction going
toward Marriottville Rd.

ADDRESS 702 Old Frederick Rd., Ellicott City, Md.

SPECIFICATIONS - 2 bedrooms

DRAIN FIELD _____ DEPTH _____ FEET, BOTTOM AREA _____ SQ. FT.

SEEPAGE PITS _____ ABSORBENT SIDE-WALL AREA _____ SQ. FT.

SEPTIC TANK CAPACITY 750 GALLONS

FOR GARBAGE GRINDER, INCREASE DISPOSAL AREA 22% & TANK CAPACITY 50%.

OTHER Dry well - 300 sq. ft. sidewall area below inlet or
Tile field - 300 sq. ft. bottom area, with the inlet no deeper than 4 ft.
below grade. Place the dry well or tile field 300 ft. to 360 ft. from the
fence along the front lot line and 30 ft. to 130 ft. from the left side of the
lot as seen when facing the lot from Driver Rd.


PERMIT VOID AFTER THREE YEARS.

PLANS APPROVED BY Raymond Hodges DATE 10/19/66

FILL SEPTIC TANK AND DISTRIBUTION BOX WITH WATER BEFORE CALLING FOR AN INSPECTION. COVER NO WORK UNTIL INSPECTED AND APPROVED.

NEITHER THE HOWARD COUNTY COMMISSIONERS NOR THE HEALTH DEPARTMENT IS RESPONSIBLE FOR THE SUCCESSFUL OPERATION OF ANY SYSTEM.

A 12095

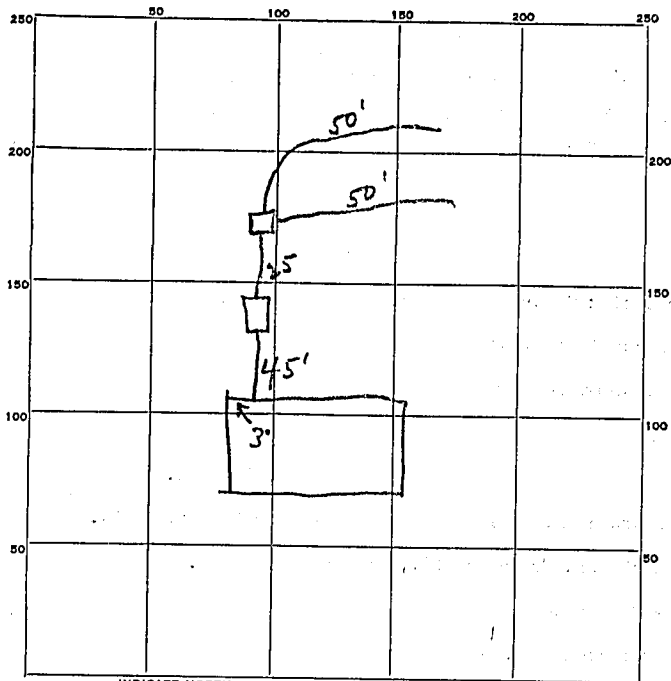

INDICATE NORTH. - NAME ADJOINING ROADWAY AS BASE LINE.

PERMIT CARD OK Driver Rd

SEPTIC TANK, LEVEL OK CLEANOUTS OK

DISTRIBUTION BOX, LEVEL OK

TILE FIELD, DEPTH 3 FT. TRENCH WIDTH 3 FT.

GRAVEL DEPTH 12 IN. TOTAL LENGTH 100 FT.

NUMBER OF TRENCHES 2 TOTAL BOTTOM AREA 300 sq. ft.

SEEPAGE PITS, INSIDE DIAMETER _____ FT. DEPTH BELOW INLET _____ FT.


ABSORBENT AREA _____ SQ. FT.

REMARKS _____

DATE SYSTEM APPROVED 2/16/67 INSPECTOR J. H. Kilmore


APPROVED FOR PRIVATE WATER & SEWERAGE

J. Shrop Aug 19 1966
DR. THEODORE R. SHROP DATE
HOWARD COUNTY HEALTH OFFICER

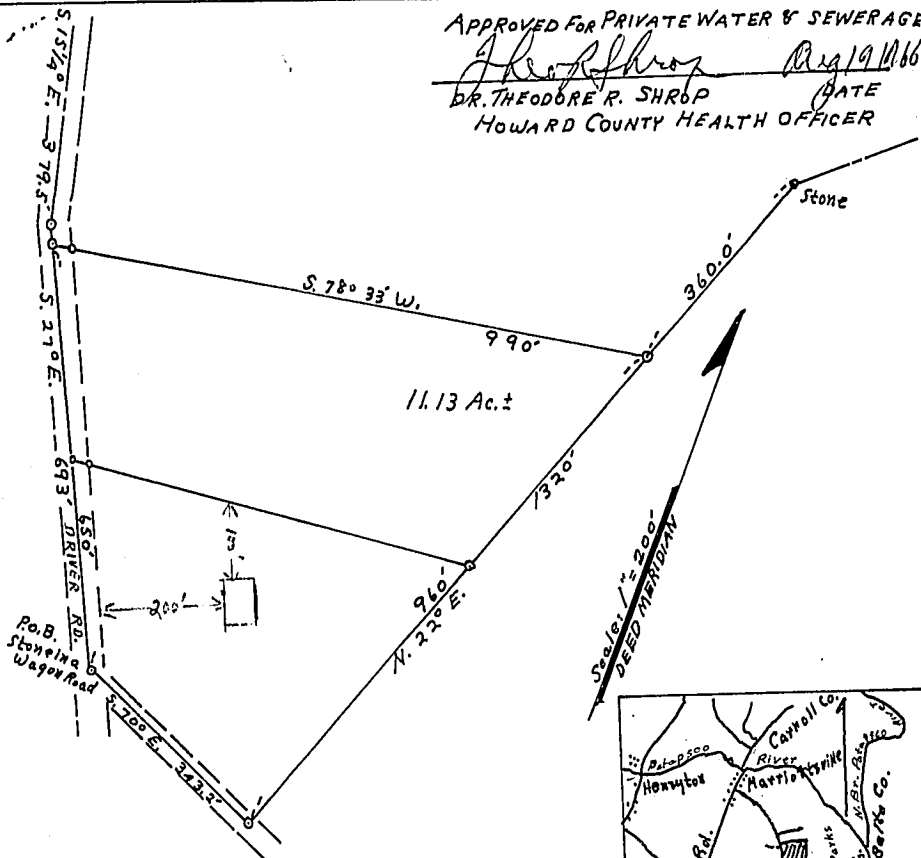

APPROVED BY VIRTUE OF PLANNING COMMISSION ACTION

T.G. HARRIS, JR. PLANNING DIRECTOR - DATE
HOWARD COUNTY PLANNING COMMISSION.

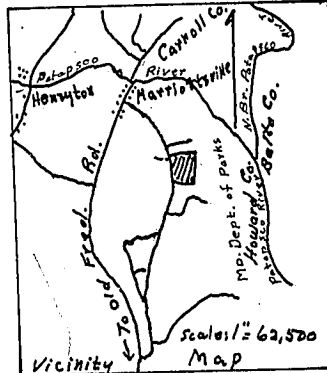

PREPARED BY
J. HARRY KOLLER
REG. LAND SURVEYOR
No. 250
Rt. 2, SYKESVILLE, MD.
PHONE: 301-795-1639

OWNER: EDWARD W. TWINING
THIRD ELECTION DISTRICT,
HOWARD COUNTY, MD.
TITLE REFERENCE:
LIBER M.W.B. No. 232 Folio 489
SCALE: 1" = 200' AUGUST 10, 1966