

9/27/85
9/30/85 am
(AM)

03-301265

Approved
9-30-85
E. H. H. H.
B. Nifon

PERMIT

P 3827
A 24149

SEWAGE DISPOSAL SYSTEM

MARYLAND STATE DEPARTMENT OF HEALTH

HOWARD COUNTY
BUREAU OF ENVIRONMENTAL HEALTH
992-2330

INDEXED

ELLCOTT CITY
DISTRICT 3rd
DATE 8/12/85

{ I.C.O.P. issued
Time expired }

J. Joseph Cartland, Inc. IS PERMITTED TO INSTALL ALTER
ADDRESS 1835 West Old Liberty Road, Westminster, MD 21157 PHONE 875-2400
SUBDIVISION Weisensel Property ROAD 12356 Howard Lodge Drive LOT 6-C
PROPERTY OWNER Mr. & Mrs. Renehan
ADDRESS _____

IF GARBAGE GRINDER IS USED INCREASE SEPTIC TANK CAPACITY BY 50% AND ABSORPTION AREA BY 22%.

GARBAGE GRINDER? YES NO

SEPTIC TANK CAPACITY 1000 GALLONS NUMBER OF BEDROOMS 3

TRENCHES - 245 sq. ft. per bedroom. Trench to be 2 feet wide. Inlet 4 feet below original grade. Bottom maximum depth 9 feet below original grade. Effective area begins at 4 feet below original grade. 5 feet of stone below distribution pipe. LOCATION: Start the first trench 225 feet from the rear (114 ft. long) lot line and 15 feet from the left (423.22 ft. long) sideline as seen when facing the lot from the private road. Continue to dig the trench on level ground running towards the right side of lot. Place the second trench parallel to and 10 feet away from the first trench.

NOTE: No trench to exceed 100 feet in length. If more than one trench used, a distribution box is required. Trenches to be installed on level ground. Call for inspection of trench(s) before and after gravel is installed. Provide 6" - 8" diameter cleanout and cap to grade or above on septic tank. *OK/SK*

LOCAL PERMIT SIGNATURE
AND RETURNED
Serial # 64980

PLANS APPROVED BY Frank Skinner DATE 7/15/85

COVER NO WORK UNTIL INSPECTED AND APPROVED.

NEITHER THE HOWARD COUNTY COUNCIL NOR THE HEALTH DEPARTMENT IS RESPONSIBLE FOR THE SUCCESSFUL OPERATION OF ANY SYSTEM.

NOTE: IF TRENCH IS USED CALL FOR INSPECTION BEFORE AND AFTER PLACING GRAVEL IN TRENCH.

NOTE: NO DRY WELL SHALL EXCEED 15 FOOT IN DIAMETER. NO ABSORPTION TRENCH TO EXCEED 100 FEET IN LENGTH.

NOTE: ALL PIPE FROM HOUSE TO SEPTIC TANK MUST BE CAST IRON OR SCHEDULE 40 PVC OR ABS.

PERMIT VOID AFTER THREE YEARS.


NOTE: INSTALL STAND PIPE ON SEPTIC TANK AND DRY WELL. STAND PIPES MUST BE 6 INCHES IN DIAMETER CAST IRON, CONCRETE OR TERRA COTTA, OR PVC OR ABS ACCEPTED. IF TOP OF SEPTIC TANK IS DEEPER THAN 3 FEET MANHOLE TO GRADE REQUIRED

***INSTALLER IS RESPONSIBLE FOR OBTAINING FINAL APPROVAL ON THIS PERMIT**

*CALL 992-2330 FOR INSPECTION OF SEPTIC SYSTEMS.

A 24149

A24149

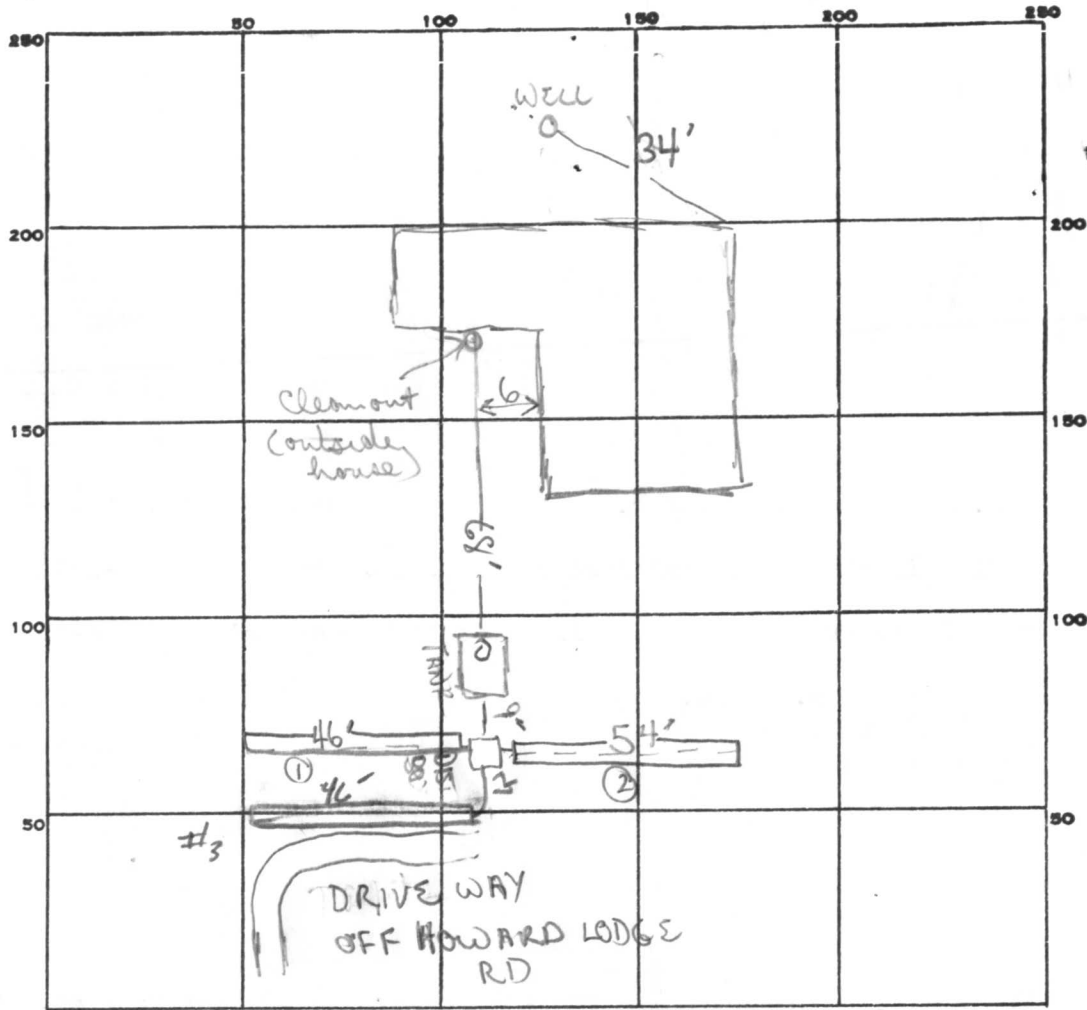

INDICATE NORTH. - NAME ADJOINING ROADWAY AS BASE LINE.

PERMIT CARD

SEPTIC TANK, LEVEL

CLEANOUTS IN LINE

DISTRIBUTION BOX, LEVEL

TILE FIELD, DEPTH 9 FT. TRENCH WIDTH 2 FT.

GRAVEL DEPTH 6 IN. TOTAL LENGTH 46 54 46 FT.

NUMBER OF TRENCHES 3 TOTAL BOTTOM AREA 276 324 276 SQ. FT.

SEEPAGE PITS, INSIDE DIAMETER _____ FT. DEPTH BELOW INLET _____ FT.

ABSORBENT AREA 874 SQ. FT.

REMARKS 9/26/95 OK TO add stone (#1) to trenches 1 + 2 + cover because of imminent rains

9/27/95 23PM STONE ADDED TO TRENCHES #1 & #2 COVER TANK

8 TRENCH #1 & #2 9

9/27/95 TRENCH #3 DOG ADD STONE

DATE SYSTEM APPROVED

9-30-95

INSPECTOR

S. Paul | B. Nelson

RECEIVED
HOWARD COUNTY
HEALTH DEPT.

APR 25 12 19 PM '80

DIVISION OF
ENVIRONMENTAL
HEALTH

DEPT. DIVISION OF ENVIRONMENTAL HEALTH
1000 W. BROADWAY, SUITE 1000
ANNAPOLIS, MARYLAND 21403
PHONE (410) 326-7000
FAX (410) 326-7001

NAME: [REDACTED]
ADDRESS: [REDACTED]
CITY: [REDACTED]
STATE: [REDACTED]
ZIP: [REDACTED]

DATE: [REDACTED]
TIME: [REDACTED]
LOCATION: [REDACTED]

APPLICATION

A 24149

SEWAGE DISPOSAL TESTING

P _____

STATE OF MARYLAND - DEPARTMENT OF HEALTH AND MENTAL HYGIENE

HOWARD COUNTY HEALTH DEPARTMENT
ENVIRONMENTAL HEALTH SERVICES
P. O. BOX 476, ELLICOTT CITY, MARYLAND 21043
TELEPHONE: 465-5000, EXT. 356

DISTRICT Third

DATE Sept. 7, 1976

TO: THE COUNTY HEALTH OFFICER
ELLICOTT CITY, MARYLAND

I, HEREBY, APPLY FOR THE NECESSARY TEST IN ORDER TO CONSTRUCT (OR RECONSTRUCT) A SEWAGE DISPOSAL SYSTEM.

PROPERTY OWNER Donald J. Weisensel
ADDRESS 41 N. Prospect Ave
Catonsville, MD PHONE Any questions call
Mr. Light 730-7950

PROPERTY LOCATION:

SUBDIVISION _____ LOT NO. 6C

ROAD AND DESCRIPTION Off Howard Lodge Rd.

SIZE OF LOT 1.326 Ac. TYPE BLDG. 3 or 4 bedroom
NUMBER OF BEDROOMS _____

IF NOT SINGLE RESIDENCE DESCRIBE _____

THE SYSTEM INSTALLED UNDER THIS APPLICATION IS ACCEPTABLE ONLY UNTIL PUBLIC FACILITIES BECOME AVAILABLE.

SIGNATURE OF APPLICANT /s/ John Rettraliata

APPROVED BY _____ FOR _____ DATE _____
(KIND OF SYSTEM)

REJECTED BY _____ FOR _____ DATE _____
(KIND OF SYSTEM)


HOLD PENDING FURTHER TESTS _____ DATE _____

REASONS FOR REJECTION OR HOLDING _____

THIS IS NOT A PERMIT

A24129

02
 2
 4-5
 clay
 sandy

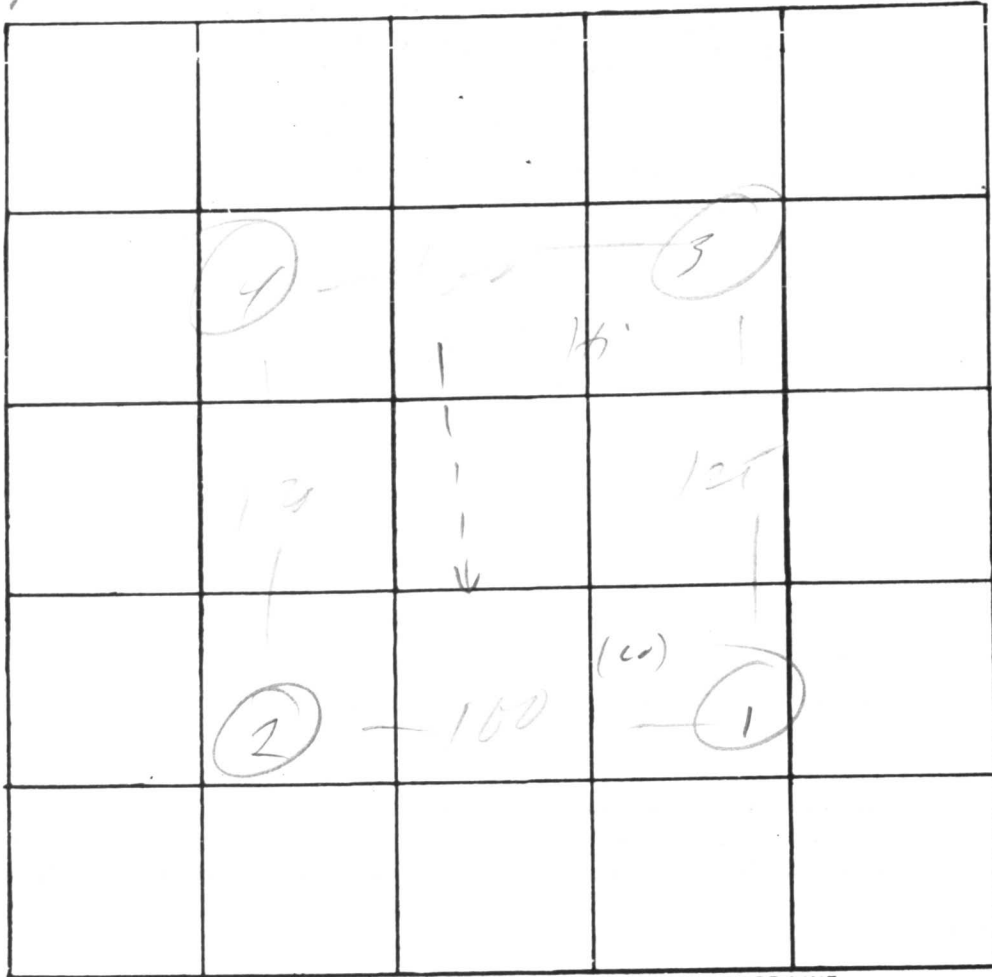

INDICATE NORTH. - NAME ADJOINING ROADWAY AS BASE LINE.

DATE	TEST NO.	DEPTH	PRE-WET		TEST - 1" DROP		TIME
			START	STOP	START	STOP	
10/7/76	7	4 1/2	1024		no Δ		230
	1A	13 1/2	1026	1033	1033	1044	11
	2	5	1031	1037	1037	1045	8
	2A	13	1031	1045	1045	1100	15
	1B	5	1043	1052	1052	1123	26
	3	4	1102	-	NO Δ	-	230
	3A	12	1102	1118	1118	1140	22
	3B	5	1120	1143	1143	1209	26
	4	13	vis		same		

REMARKS _____
 TYPE OF SOIL _____
 TESTED BY MM ALSO PRESENT: Lendrum

