

12/10/69

PERMIT

P 14792
A 14792

SEWAGE DISPOSAL SYSTEM

MARYLAND STATE DEPARTMENT OF HEALTH

HOWARD COUNTY

ELLICOTT CITY

INDEXED

DISTRICT 3

DATE 10/2/69

Charles Doyle IS PERMITTED TO INSTALL ALTER

ADDRESS Box 195, Dear Park Road, Westminster, Md. PHONE 876-1080

A SEWAGE DISPOSAL-SYSTEM LOCATED AT _____

SUBDIVISION _____ ROAD Driver Road (see application for better directional) LOT _____

PROPERTY OWNER Allan C. Driver

ADDRESS _____

SPECIFICATIONS - 4 bedrooms

DRAIN FIELD _____ DEPTH _____ FEET, BOTTOM AREA _____ SQ. FT.

SEEPAGE PITS _____ ABSORBENT SIDE-WALL AREA _____ SQ. FT.

SEPTIC TANK CAPACITY 1,000 GALLONS

FOR GARBAGE GRINDER, INCREASE DISPOSAL AREA 22% & TANK CAPACITY 50%.

OTHER Dry well - 100 sq. ft. absorbent sidewall area to begin below the first

5 1/2 ft. non-porous soil. Maximum depth permitted for dry well is 13 ft. below

original grade. Locate dry well 285 ft. off left side line and 130 ft. off rear

property line as seen from Driver Road.

NOTE: ALL PIPE FROM HOUSE TO SEPTIC TANK MUST CAST IRON.

PERMIT VOID AFTER THREE YEARS.


PLANS APPROVED BY Robert V. Torre DATE 9/11/69

FILL SEPTIC TANK AND DISTRIBUTION BOX WITH WATER BEFORE CALLING FOR AN INSPECTION. COVER NO WORK UNTIL INSPECTED AND APPROVED.

NEITHER THE HOWARD COUNTY COMMISSIONERS NOR THE HEALTH DEPARTMENT IS RESPONSIBLE FOR THE SUCCESSFUL OPERATION OF ANY SYSTEM.

NOTIFY THE HEALTH DEPARTMENT 48 HOURS BEFORE EXCAVATIONS ARE TO BE BACK FILLED.

A 14792

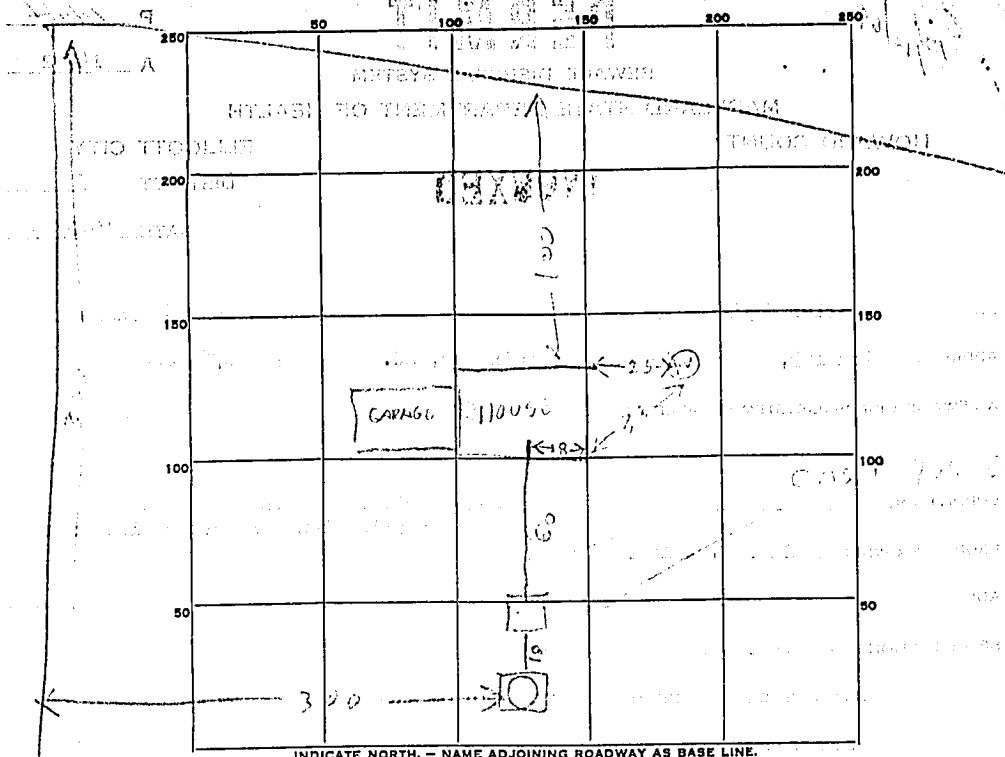

PERMIT CARD _____

SEPTIC TANK, LEVEL 1100.50

CLEANOUTS _____

DISTRIBUTION BOX, LEVEL _____

TILE FIELD, DEPTH _____ FT. TRENCH WIDTH _____ FT.

GRAVEL DEPTH _____ IN. TOTAL LENGTH _____ FT.

NUMBER OF TRENCHES _____ TOTAL BOTTOM AREA _____

SEEPAGE PITS, INSIDE DIAMETER 70 FT. DEPTH BELOW INLET 9 FT.

ABSORBENT AREA 324 SQ. FT.

REMARKS _____

Approx 1/2 ft above ground level

4 BEDR CORNERS COUNT TO A MINIMUM

100' x 100'

DATE SYSTEM APPROVED 12/10/00 INSPECTOR _____