

*Ready 1:30
7/30/69*

PERMIT

SEWAGE DISPOSAL SYSTEM

MARYLAND STATE DEPARTMENT OF HEALTH

HOWARD COUNTY

ELLICOTT CITY

INDEXED

DISTRICT 3

DATE 4/16/69

Appr. 7/31/69
R. Toner P 14421
A _____

Mrs. Velma Cain IS PERMITTED TO INSTALL _____ ALTER X

ADDRESS Box 92C - Driver Road, Marriottsville, Md. PHONE 328-2365

A SEWAGE DISPOSAL SYSTEM LOCATED AT _____

SUBDIVISION _____ ROAD 1201 Driver Road LOT _____

PROPERTY OWNER Herbert Steiner middle way in on Driver Road (Main house) STOVE HOUSE

ADDRESS Turn on farm rd at point on Driver Rd

SPECIFICATIONS - REPAIR where black top & dirt meet

DRAIN FIELD _____ DEPTH _____ FEET, BOTTOM AREA _____ SQ. FT.

SEEPAGE PITS _____ ABSORBENT SIDE-WALL AREA _____ SQ. FT.

SEPTIC TANK CAPACITY 750 GALLONS to be at least 50 ft. from water well.

FOR GARBAGE GRINDER, INCREASE DISPOSAL AREA 22% & TANK CAPACITY 50%.

OTHER REPAIR - 300 sq. ft. absorbent area of dry well or tile field.

NOTE: ALL SEWER LINES WITHIN 50 FT. OF WELL MUST BE 4" CAST IRON PIPE WITH LEADED JOINTS.

Sewer line must be at least 10 ft. from water well. Dry well or tile field must be 100 ft. from water well.


PLANS APPROVED BY Raymond Hodges DATE 4/16/69

FILL SEPTIC TANK AND DISTRIBUTION BOX WITH WATER BEFORE CALLING FOR AN INSPECTION. COVER NO WORK UNTIL INSPECTED AND APPROVED.

NEITHER THE HOWARD COUNTY COMMISSIONERS NOR THE HEALTH DEPARTMENT IS RESPONSIBLE FOR THE SUCCESSFUL OPERATION OF ANY SYSTEM.

NOTIFY THE HEALTH DEPARTMENT 48 HOURS BEFORE EXCAVATIONS ARE TO BE BACK FILLED.

14421

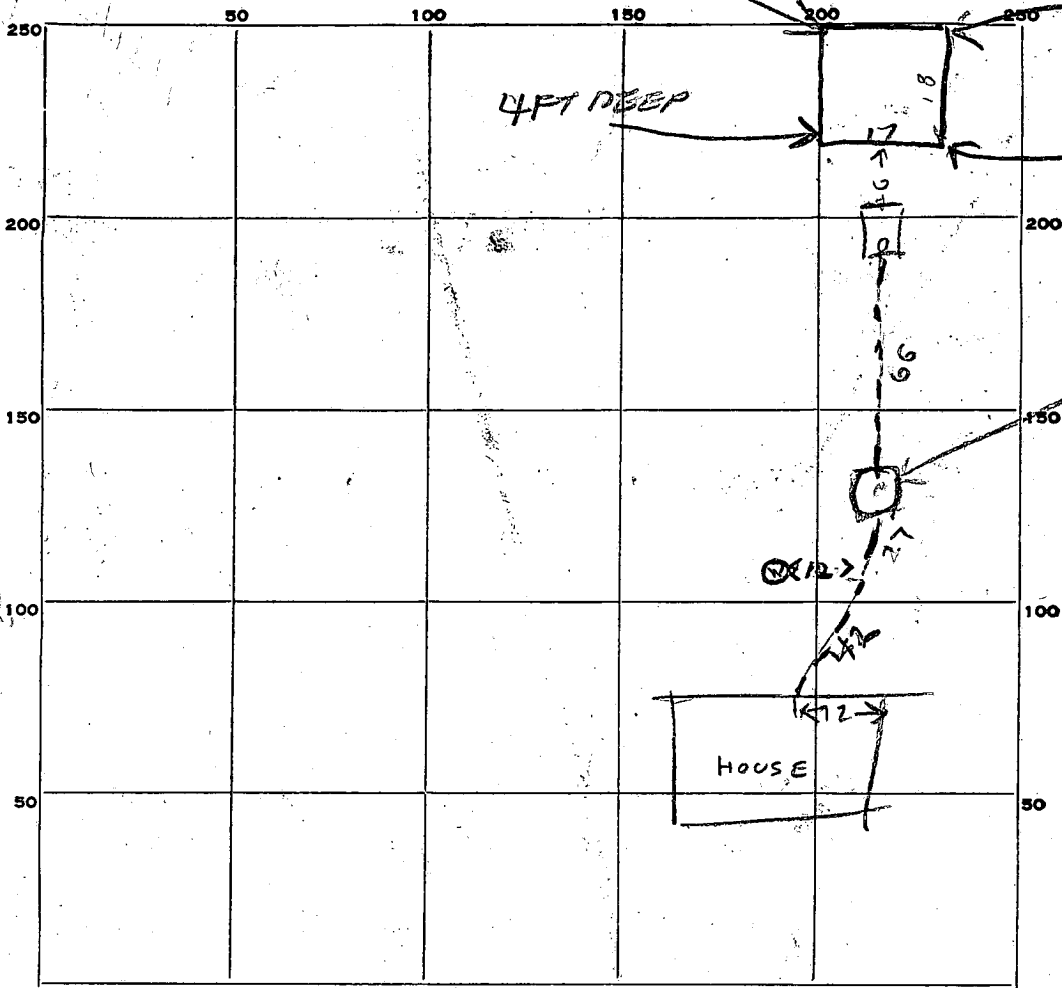

INDICATE NORTH. - NAME ADJOINING ROADWAY AS BASE LINE.

66
27
42
135

PERMIT CARD Liquid

SEPTIC TANK, LEVEL OK 750 concrete
top is 1/2 FT below grade
 DISTRIBUTION BOX, LEVEL

CLEANOUTS 01

RECEIVED
 HOWARD COUNTY
 HEALTH DEPT.
 JUL 16 8 54 PM '69
 DIVISION OF
 ENVIRONMENTAL
 HEALTH

TILE FIELD, DEPTH 4-5 1/2 FT. TRENCH WIDTH 18 FT.

GRAVEL DEPTH 30 IN. TOTAL LENGTH 17

NUMBER OF TRENCHES 3 TOTAL BOTTOM AREA 306

18
17
126
18
306

SEEPAGE PITS, INSIDE DIAMETER FT. DEPTH BELOW INLET FT.

ABSORBENT AREA SQ. FT.

REMARKS 7/17/69 - Soil in bottom of bed looks sandy
Dug Bed about 1 FT deep, Add 3 FT stone, Install Cast Iron
sewers & call for reinspection R/T
Loaded cast iron sections to septic tank.

DATE SYSTEM APPROVED 7/31/69 INSPECTOR R. Lane

Am. Congen. Recife
APO-09676
New York, N.Y.

Office of Building Engineers
County Office Building
Ellicott City, Maryland

GentlemenP

We are rebuilding an old summer and weekend house on our farm near Marriettsville (on Driver Road). Last November or December my wife received your approval on plans for the remodeling job which at present has almost been completed.

In the process of digging the new cellar the machine broke the septic tank which had been in use for many years. This tank was only about 7 feet from the house and had a tile field downhill. Since the tank will have to be rebuilt I would like to have you contact Mr. John Neal of Marriettsville (Box 127, Route 99, Tel. DAS-2412) to make sure that whatever he does, the tank will meet your specifications. This should include a size large enough to take care of all eventualities. In all probability no more than 2 persons will live in the house when we return from Brasil, but it should be large enough to take care of four.

It is difficult to supervise a job from a distance of 5,000 miles. That is why I am asking you to make sure all regulations are honored. We expect to use the house as a haven in between periods of service overseas.

Sincerely,

Herbert Steiner
Herbert Steiner