

THIS REPORT
MUST BE SUBMITTED
WITHIN 30 DAYS
AFTER COMPLETION
OF THE WELL

WELL COMPLETION REPORT

No 1061

WELL DESCRIPTION

Permit Number HD-1B-W-75
Owner Mrs. Herbert Stiner
Address Wartsville MD
Subdivision Farm.
Section _____ Lot _____

WELL LOG

State the kind of formations penetrated, their color, their depth, their thickness, and if water-bearing

CASING AND SCREEN RECORD

State the kind and size and position of casing, liner, shoe, screen, and other accessories (if no casing used, give diameter of well).

WELL LOG	FEET		CASING AND SCREEN RECORD	DIAM. (inches)	FEET	
	from	to			from	to
Clay & Sand.	0	10	Black Steel	6 1/4	0	17
Granite Gray	10	103	1 Screen	4 0		
			2 "	6 0		
			3 "	9 0		

Dewey Brown.

PUMPING TEST
Hours Pumped 4
Type of Pump Used air
Pumping Rate 15
Gallons per Minute 10


WATER LEVEL
(Distance from land surface to water)
Before Pumping 10 Ft.
When Pumping 90 Ft.

APPEARANCE OF WATER
Clear Cloudy _____
Taste _____
Odor _____

Height of Casing Above Land Surface 10 in Ft.

PUMP INSTALLED
Type _____
Capacity _____
Gallons per Minute _____
Gallons per Hour _____
Pump Column Length _____ Ft.

LOCATION OF WELL ON LOT
Show permanent structures such as building(s), septic tank, and/or other landmarks and indicate not less than 2 distances (measurements) to well.

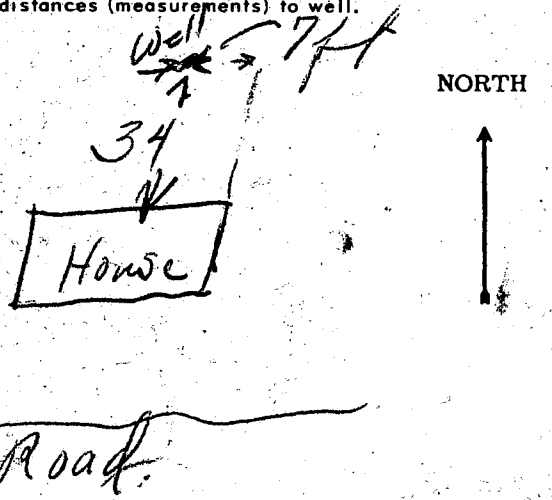

DATE WELL WAS COMPLETED

I hereby affirm that this report contains no willful misrepresentations or falsifications and that information given in this report is true, accurate and complete to the best of my knowledge and belief.

Howard Green
Howard Green, Well Driller.
Well Driller License No.: 235

Oct. 1961

APPLICATION MUST BE SUBMITTED AND PERMIT RECEIVED BEFORE DRILLING IS STARTED.

APPLICATION FOR PERMIT TO DRILL WELL

No. 1061

Owner Gives Herbert H. Steiner
Street or R. F. D. _____
Post Office Marristowne Rd

Driller Denny Brown License Number 113
Street or R. F. D. Mt airy rd
Post Office _____
Date Oct 17 1967

Quantity of Water to be Produced 3 Gallons Per Minute
Total Quantity Needed For Use 1000 Gallons Per Day
Use for Water House
Approximate Depth of Well (feet) 100 ft
Method of Drilling to be used Cable

Location of Well County Howard
Subdivision _____
Section _____ Lot _____
Nearest Town Marristowne Md
Distance from Town 2 mile
Direction from Town North

Is this a Replacement Well? Yes - No
If YES, indicate date abandoned well is to be sealed: _____
and by whom: _____

Description of Location of Well
(This information MUST BE ACCURATE, and should be definite enough to permit locating well on a county map).
Near what road Dunes Road
On which side of road East
(North, East, South, West)
Distance from road 500 yard on E side

PERMIT TO DRILL WELL
(Not To Be Filled In By Driller)

Well Permit No. HO-68-W-95

Samples of Cuttings Required by Department: Yes No
Owner Requires Permit to Appropriate Water: Yes No
Owner Has Permit to Appropriate Water: Yes No

Appropriation Permit No. _____
The applicant is herewith granted a permit to drill this well subject to the conditions stipulated.
Paul W. McKee (Seal) Oct 18-67
Director Date

THIS PERMIT IS NOT TRANSFERRABLE
WITHOUT WRITTEN PERMISSION FROM THE DEPARTMENT
Special conditions that must be observed:

Health Department Approval of Application
Howard County Department of Health
or State Department of Health
Approved by Stalmer F. Wame
Title Director, Environmental Health
Date 10/17/67

Draw a sketch below showing location of well in relation to nearby towns, roads and streams with north in the direction of the arrow, and give distance from well to nearest road junction or stream crossing shown on the sketch. Distances may be approximate, but must be indicated.

