

APPLICATION

SEWAGE DISPOSAL TESTING

A 15352

P _____

MARYLAND STATE DEPARTMENT OF HEALTH

HOWARD COUNTY *Septic Tank - 3 bedrooms - 1000 gal*

ELLICOTT CITY

DISTRICT 3

DATE 7/6/70

*Dry Well - 100 sq. ft. absorbent sidewall area
per bedroom to begin below the inlet pipe.
Maximum depth permitted for dry well is 9 ft.
below original grade. Located dry well 88 ft off
rear property line and 60 ft off left side line*

TO: THE COUNTY HEALTH OFFICER *as seen from Driver Road.*
ELLICOTT CITY, MARYLAND

I, HEREBY, APPLY FOR THE NECESSARY TESTS IN ORDER TO CONSTRUCT (OR RECONSTRUCT) A SEWAGE DISPOSAL SYSTEM.

PROPERTY OWNER Allen C. Driver & wife

ADDRESS Driver Road, Marriottsville, Md.

PHONE _____

PROPERTY LOCATION:

SUBDIVISION Driver

LOT NO. 5, Sec. 1

ROAD AND DESCRIPTION Driver Road

OCCUPANT _____

PHONE _____

PERSON TO CONSTRUCT SYSTEM _____

ADDRESS _____

PHONE _____

SIZE OF LOT 136' x 294'

TYPE BLDG. 3 or 4

NUMBER OF BEDROOMS

IF NOT SINGLE RESIDENCE DESCRIBE _____

SIGNATURE OF APPLICANT /s/ Jack Fyock

APPROVED BY Robert V. Toner

FOR Dry Well

(KIND OF SYSTEM)

DATE 7/31/70

REJECTED BY _____

FOR _____

(KIND OF SYSTEM)

DATE _____

HOLD PENDING FURTHER TESTS _____

DATE _____


REASONS FOR REJECTION OR HOLDING _____

PRINTED NAME JOB _____

Y. 10/10/70

THIS IS NOT A PERMIT

12325

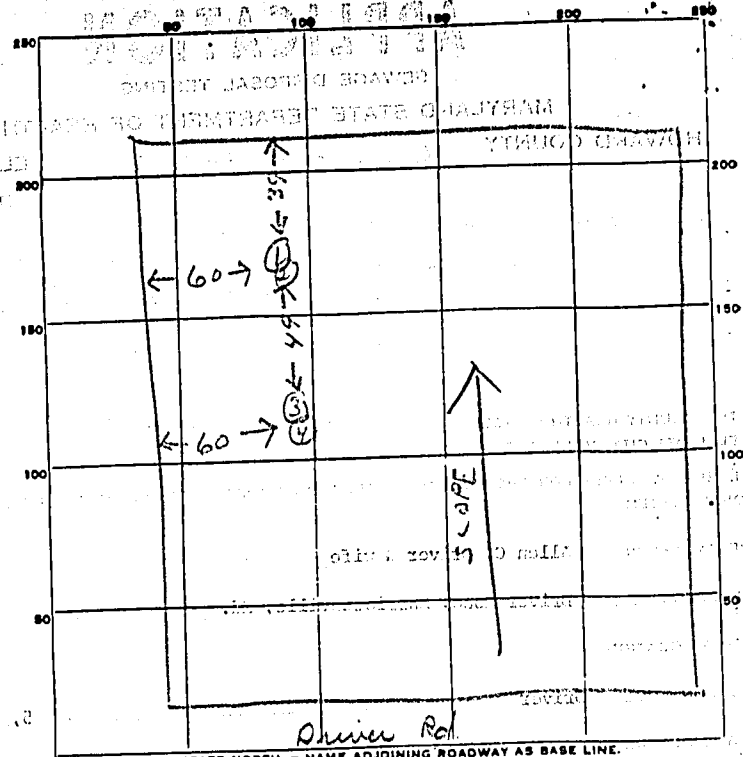

INDICATE NORTH. - NAME ADJOINING ROADWAY AS BASE LINE.

(3 min avg)

DATE	TEST NO.	DEPTH	PRE-WET		TEST - 1" DROP		TIME
			START	STOP	START	STOP	
7/7/70	1	9 1/2 ft.	11 15	11 16	11 16	11 18	2 min
	2	4 ft.	11 15	11 17	11 17	11 20	3 min
	3	8 1/2 ft.	11 20	11 21	11 21	11 22	1 min
	4	3 1/2 ft.	11 20	11 21	11 21	11 24	3 min

1. Outlet ca. street
 anywhere below original grade
 not less than 3 ft., 'Maximum depth' 9 1/2 ft.

SOIL AUGER FINDING _____

TESTED BY _____

REMARKS _____

THANK YOU FOR YOUR SERVICE

A15352

E 95000

N 10500

E 10000

N 10500

ALLAN C. DRIVER
MWB. 215/353

4'x4' CONC. MON.

N 85° 27' 07" E - 238.99

U.S. UTILITY EASEMENT

40.148

(A)

SECTION 2
DRIVER PROPERTY
21/3

ALLAN C. DRIVER
MWB. 215/353

(B)

N 01° 32' 53" W - 296.50

75'

4'x4' CONC. MON.

Lot 5
13 ft
10,000 sq ft
55,719 sq ft

BUILDING RESTRICTION LINE

S 85° 27' 07" W - 232.94

134.50

N 01° 32' 53" W - 46.50

S 85° 27' 07" W - 5.44

PROPOSED AREA FOR PUBLIC USE

SOUTH SIDE - DRIVER ROAD

EXISTING 33' R/W

SISTERS OF BON SECOURS

2,000

E 9500

N 10000

S 25° 00'

L: 27.56'

N 10000

S 02° 50' 16" W - 276.22

40'

S 50° 13' 52" E - 46.50

EXIST. 33' R/W

MWB 215/353

(C)

(D)

(E)

(F)

(G)

(H)

(I)

(J)

(K)

(L)

(M)

(N)

(O)

(P)

(Q)

(R)

(S)

(T)

(U)

(V)

(W)

(X)