

Revised
10/18 + 11/17 +
9:30 11/21

APPLICATION

PERCOLATION TESTING

A 34993

HOWARD COUNTY HEALTH DEPARTMENT
BUREAU OF ENVIRONMENTAL HEALTH
P.O. BOX 476 ELLICOTT CITY, MARYLAND 21043
TELEPHONE: 461-9933

P _____
DISTRICT 3rd

DATE Oct. 20, 1986

12 LOTS

TO: THE COUNTY HEALTH OFFICER
ELLICOTT CITY, MARYLAND

I, HEREBY, APPLY FOR THE NECESSARY TEST IN ORDER TO CONSTRUCT (OR RECONSTRUCT) A SEWAGE DISPOSAL SYSTEM.

PROPERTY OWNER Willard and Ginnie Mathis (BARNARD) BROS. CONST. CO., INC.
12392-A Frederick Rd.
ADDRESS West Friendship, Md. 21794 PHONE 489-4024

PROSPECTIVE BUYER Garry M. Barnard
ADDRESS 1035 St. Michael Rd. Mt. Airy, Md. 21771 PHONE 489-7621

PROPERTY LOCATION:

SUBDIVISION Mathis Property Sec II LOT NO. 21
ROAD AND DESCRIPTION At the end of ¹²⁴⁶⁵ Barnard Way

TAX MAP # 15 PARCEL # 15

SIZE OF LOT 3.05 AC. TYPE BLDG. SFD
(SINGLE FAMILY DWELLING OR COMMERCIAL)

THE SYSTEM INSTALLED UNDER THIS APPLICATION IS ACCEPTABLE ONLY UNTIL PUBLIC FACILITIES BECOME AVAILABLE. I FULLY UNDERSTAND THE FEE CONNECTED WITH THE FILING OF THIS PERC TEST APPLICATION IS NON-REFUNDABLE UNDER ANY CIRCUMSTANCES. I ALSO AGREE TO COMPLY WITH ALL M.O.S.H.A. REQUIREMENTS IN TESTING THIS LOT. Garry M. Barnard
(SIGNATURE OF APPLICANT)

APPROVED BY Sid Abel FOR Drip TRENCHES DATE S. Abel

REJECTED BY _____ FOR _____ DATE _____

HOLD PENDING FURTHER TESTS _____ DATE _____

REASONS FOR REJECTION OR HOLDING 11/19/86 Perc. Satisfactory; Hold For Subdivision Plat. S. Abel

BLDG. PERMIT SIGNED
AND RETURNED 6-1488


BP19238 SAH

THIS IS NOT A PERMIT

A37993

SOIL PROFILE

0"
10"
4"
AP
Yellow BR
Silt loam
9-12% clay
<10% frags
Tan to
Yellow
BR silt
sand
loam
10-15%
Fragments
CH/GI

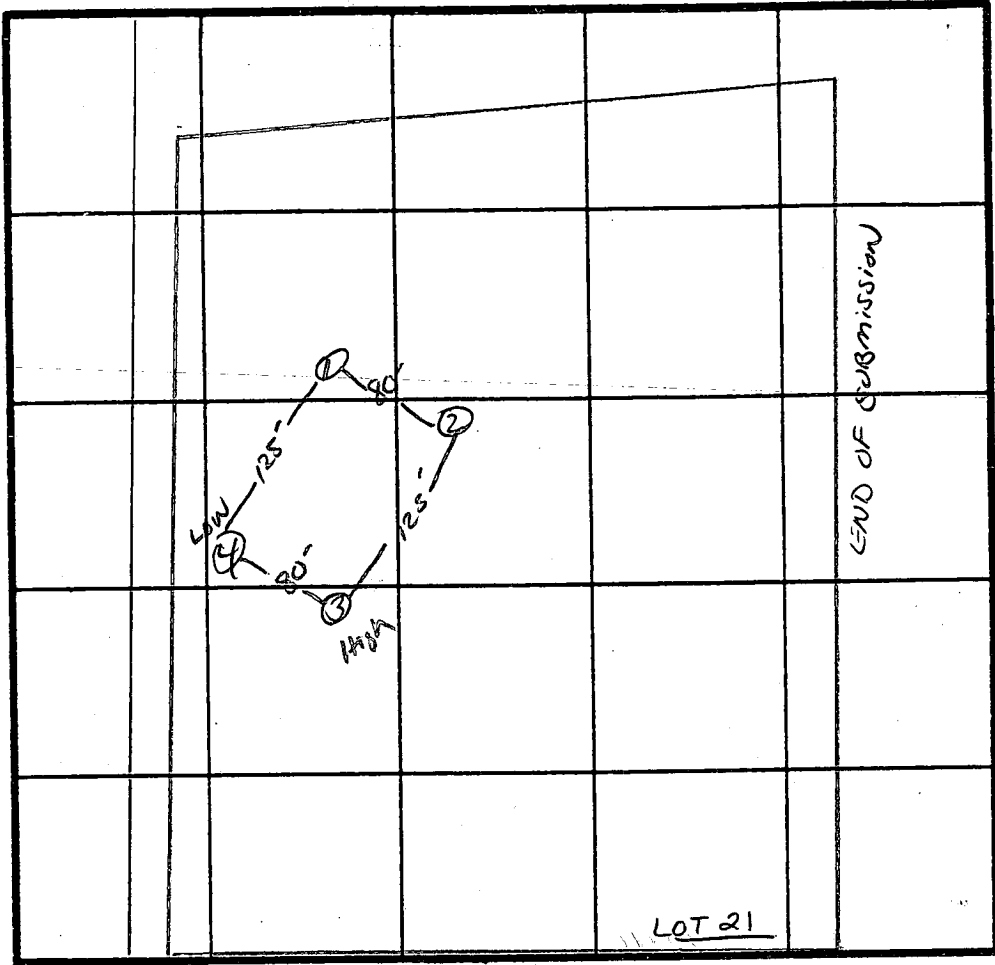

7 Perc
5 min
180 # BR
INLET 4'
BOTTOM 9'

INDICATE NORTH - NAME ADJOINING ROADWAY AS BASE LINE.
BARNARD WAY ↓ TO Rt 70

0"
10"
35"
4.5"
13"
AP
Yellow BR.
Silt loam
9-12% CLAY
10-20%
FRAGS w/ gravel
Yellow BR
Silt sand loam
15-20%
FRAGS
(C₂)

DATE	TEST NO.	DEPTH	PRE-WET		TEST - 1" DROP		TIME
			START	STOP	START	STOP	
11/19/86	1 S	4"	10:34	10:36	10:36	10:39	3 min
	1 V	13"	UNIFORM SOIL below 4"				
	2 S	3.5"	10:44	10:45	10:45	10:46	1 min
	2 M	9"	10:46	10:48	10:48	10:52	4 min
	2 V	10.5"	SAME AS HOLE #		3+4 w/	Good Soil	AT 3.5"
	3 V	13"	SAME AS HOLE # 4 w/		Less Gravel		
	4 S	5"	10:35	10:37	10:37	10:46	9 min
	4 V	13"	uniform soil below		4.5"		

REMARKS: Holes Rep PLAT
 TYPE OF SOIL: Chester/Glenoldy to Chester Gravelly Lm.
 TESTED BY: S. Abel
 ALSO PRESENT: Dave Hopkins, Bannard Brothers