

12/21/76

PERMIT

SEWAGE DISPOSAL SYSTEM

P 24821
A 15352

MARYLAND STATE DEPARTMENT OF HEALTH

HOWARD COUNTY

ELLICOTT CITY

Approved
HB

DISTRICT 3rd

✓ INDEXED

DATE 11/24/76

Leon Morrison IS PERMITTED TO INSTALL ALTER

ADDRESS 106 Hillside Road Catonsville, MD. 21228 PHONE 747-2828

A SEWAGE DISPOSAL SYSTEM LOCATED AT Driver Road

SUBDIVISION Driver ROAD 1350 Driver Road LOT 10, Blk.A, Sec.3

PROPERTY OWNER Allen C. Driver & wife

ADDRESS Driver Road, Marriottsville, Maryland

SPECIFICATIONS

DRAIN FIELD DEPTH FEET, BOTTOM AREA SQ. FT.

SEEPAGE PITS ABSORBENT SIDE-WALL AREA SQ. FT.

SEPTIC TANK CAPACITY 1000 GALLONS

FOR GARBAGE GRINDER, INCREASE DISPOSAL AREA 22% & TANK CAPACITY 50%.

OTHER DRY WELL - 100 sq feet absorbent sidewall area per bedroom to begin below the inlet pipe. Inlet no deeper than 2 1/2 to 3 feet. Maximum depth permitted for dry well is 9 feet below original grade. Locate dry well 160 feet off front property line and 70 feet off right side line as seen from Driver Road.

NOTE: All pipe from house to disposal area must be cast iron. Permit void after 3 years.

NOTE: Install stand pipe on septic tank. Stand pipes must be 6 inches in diameter. Cast iron, concrete or terra cotta accepted.


PLANS APPROVED BY Robert V. Torre DATE 7/21/70

FILL SEPTIC TANK AND DISTRIBUTION BOX WITH WATER BEFORE CALLING FOR AN INSPECTION. COVER NO WORK UNTIL INSPECTED AND APPROVED.

NEITHER THE HOWARD COUNTY COMMISSIONERS NOR THE HEALTH DEPARTMENT IS RESPONSIBLE FOR THE SUCCESSFUL OPERATION OF ANY SYSTEM.

A 15352

15352 85-9-53

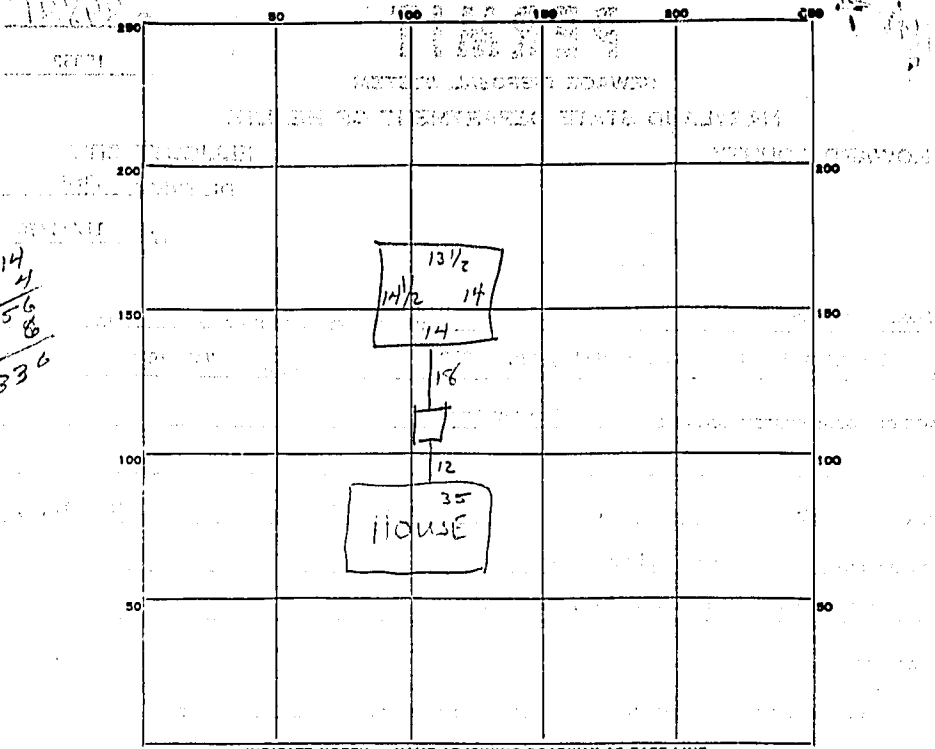

PERMIT CARD _____

SEPTIC TANK, LEVEL 1000 gal ✓ CLEANOUTS ST | DW
 ✓ | ✓

DISTRIBUTION BOX, LEVEL _____

TILE FIELD, DEPTH _____ FT. TRENCH WIDTH _____ FT.

GRAVEL DEPTH _____ IN. TOTAL LENGTH _____ FT.

NUMBER OF TRENCHES _____ TOTAL BOTTOM AREA _____

SEEPAGE PITS, INSIDE DIAMETER Perimeter 56 FT. DEPTH BELOW INLET 6 FT.

ABSORBENT AREA 336 SQ. FT.

REMARKS _____

DATE SYSTEM APPROVED 12-22-78 INSPECTOR WAL HANSON