


600
30
45
13
58
6
348
270
618
45
6
270

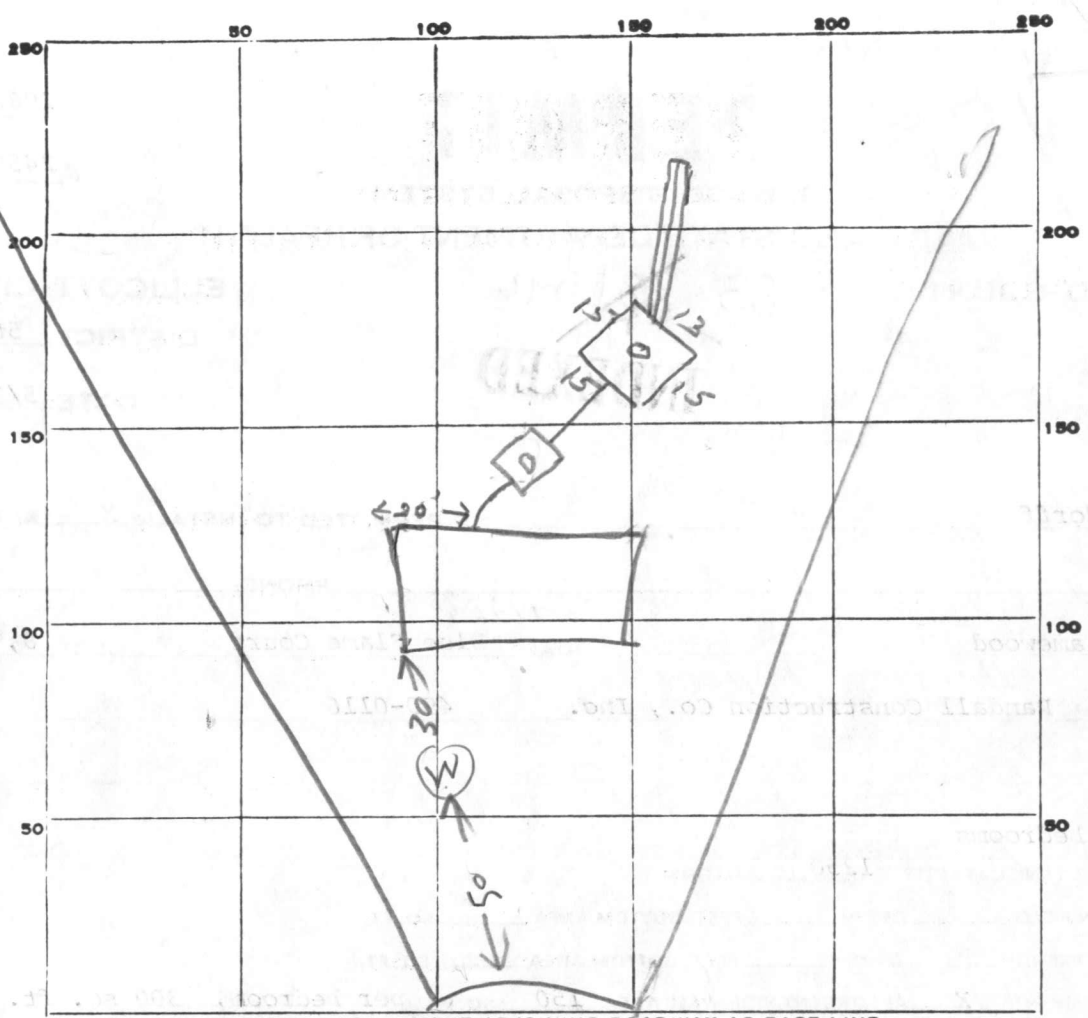

INDICATE NORTH. - NAME ADJOINING ROADWAY AS BASE LINE.

PERMIT CARD _____
 SEPTIC TANK, LEVEL _____ CLEANOUTS ST/DW
 DISTRIBUTION BOX, LEVEL _____
 TILE FIELD, DEPTH 11 FT. TRENCH WIDTH 2 FT.
 GRAVEL DEPTH 6 FT. TOTAL LENGTH 45 FT.
 NUMBER OF TRENCHES 1 TOTAL BOTTOM AREA 270
 SEEPAGE PITS, INSIDE DIAMETER 57 FT. DEPTH BELOW INLET 6 FT.
 ABSORBENT AREA 600+ SQ. FT.

REMARKS 6/29/79 - TANK & DW HOLE DUG LOCATION OK 1230 AM
6/29/79 BARN - DITCH DUG
7/3/79 OK to cover work - JS

DATE SYSTEM APPROVED 7/3/79 INSPECTOR J. Stayer

APPLICATION

A 24501

SEWAGE DISPOSAL TESTING

P _____

STATE OF MARYLAND - DEPARTMENT OF HEALTH AND MENTAL HYGIENE

HOWARD COUNTY HEALTH DEPARTMENT
ENVIRONMENTAL HEALTH SERVICES
P. O. BOX 476, ELLICOTT CITY, MARYLAND 21043
TELEPHONE: 465-5000, EXT. 356

DISTRICT 5

DATE 3-15-76

$E = 12 \text{ min} \Rightarrow 150 \text{ A/BR}$

TO: THE COUNTY HEALTH OFFICER
ELLICOTT CITY, MARYLAND

I, HEREBY, APPLY FOR THE NECESSARY TEST IN ORDER TO CONSTRUCT (OR RECONSTRUCT) A SEWAGE DISPOSAL SYSTEM.

PROPERTY OWNER Henry Dryfoos, III

ADDRESS 4701 Sangamore Road, Washington, D.C. 20016 PHONE 229-5052

PROPERTY LOCATION:

SUBDIVISION Flamewood LOT NO. NEW LOT 8-B
9, Block B

ROAD AND DESCRIPTION _____

SIZE OF LOT 47,500 TYPE BLDG. 4
NUMBER OF BEDROOMS

IF NOT SINGLE RESIDENCE DESCRIBE _____

THE SYSTEM INSTALLED UNDER THIS APPLICATION IS ACCEPTABLE ONLY UNTIL PUBLIC FACILITIES BECOME AVAILABLE.

SIGNATURE OF APPLICANT Henry Dryfoos III

APPROVED BY William H. Jepp FOR DW & trunk DATE 11/2/77
(KIND OF SYSTEM)


REJECTED BY _____ FOR _____ DATE _____
(KIND OF SYSTEM)

HOLD PENDING FURTHER TESTS _____ DATE _____

REASONS FOR REJECTION OR HOLDING _____

BLDG. PERMIT SIGNED
AND RETURNED 3/13/79
serial # 38456

THIS IS NOT A PERMIT

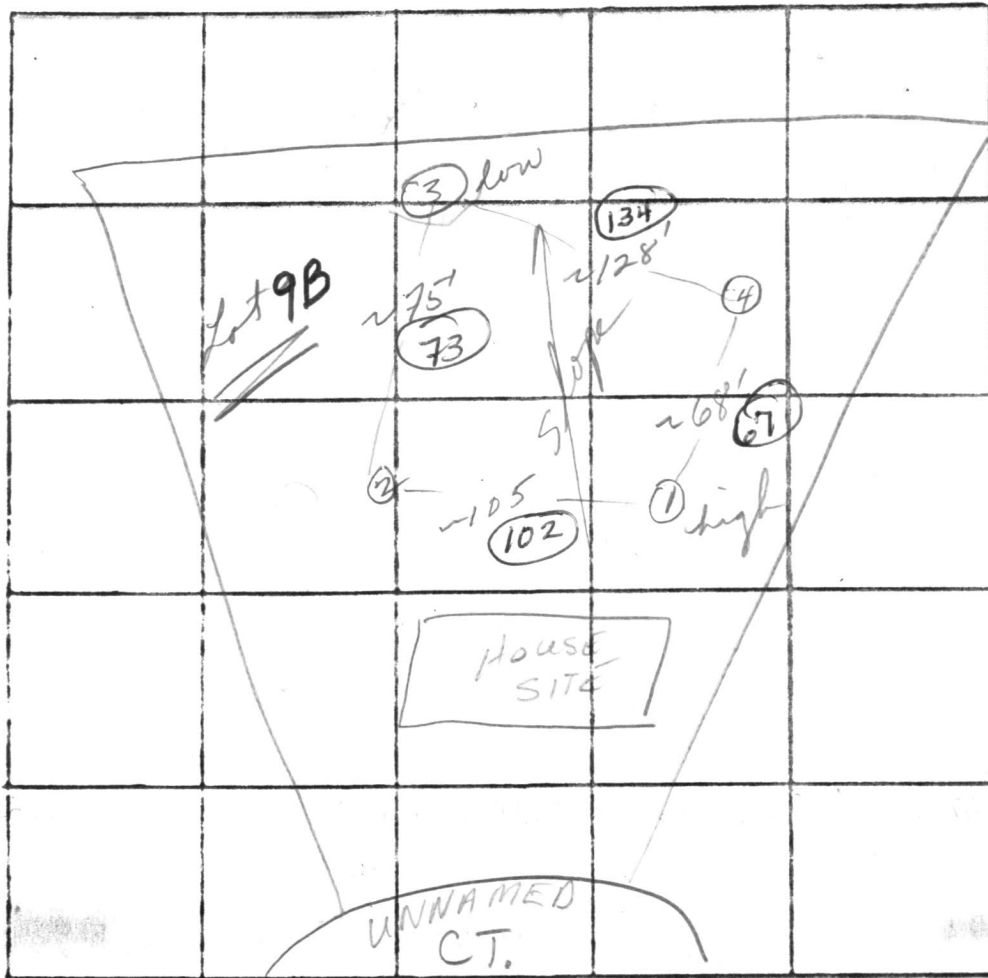

DATE	TEST NO.	DEPTH	PRE-WET		TEST - 1" DROP		TIME	
			START	STOP	START	STOP		
4/22/76	1	6	12:50	12:54	12:54	1:10	16	
	1-A	13	12:50	12:52	12:52	12:54	2	
	2	6 1/2	12:54	1:03	1:03	1:32	29	
	2-A	14	12:54	12:56	12:56	1:00	4	
	3	6	1:06	1:12	1:12	1:25	13	
	3-A	13	1:03	1:25	1:25	NO PERC		
	4	12 1/2	Visual; similar; dry					
	3-B	12	1:37	1:37	1:39	1:45	8	

≤ 1/2 of 2nd 11

REMARKS _____

TYPE OF SOIL Sandy

TESTED BY NWZ + HB ALSO PRESENT Fyock

10'x14' SHEAD

BLOCK B
LOT 8
49,220'02
1.130 AC.

PRIVATE SEWAGE
EASEMENT
PLOT 3822

COVERED PATIO
PROPOSED ADDITION

7'x7' CONC. SLAB
2'x31.7' OVERHANG

7.1'x13.5' CONC. STOOP

2 STORY ALUM. & BRICK

10'x16' OVERHANG
OVER 10'x16' CONC. SLAB

CONC. DRIVEWAY


JEFLAME COURT

295.88

332.90

295.97

LOT 1

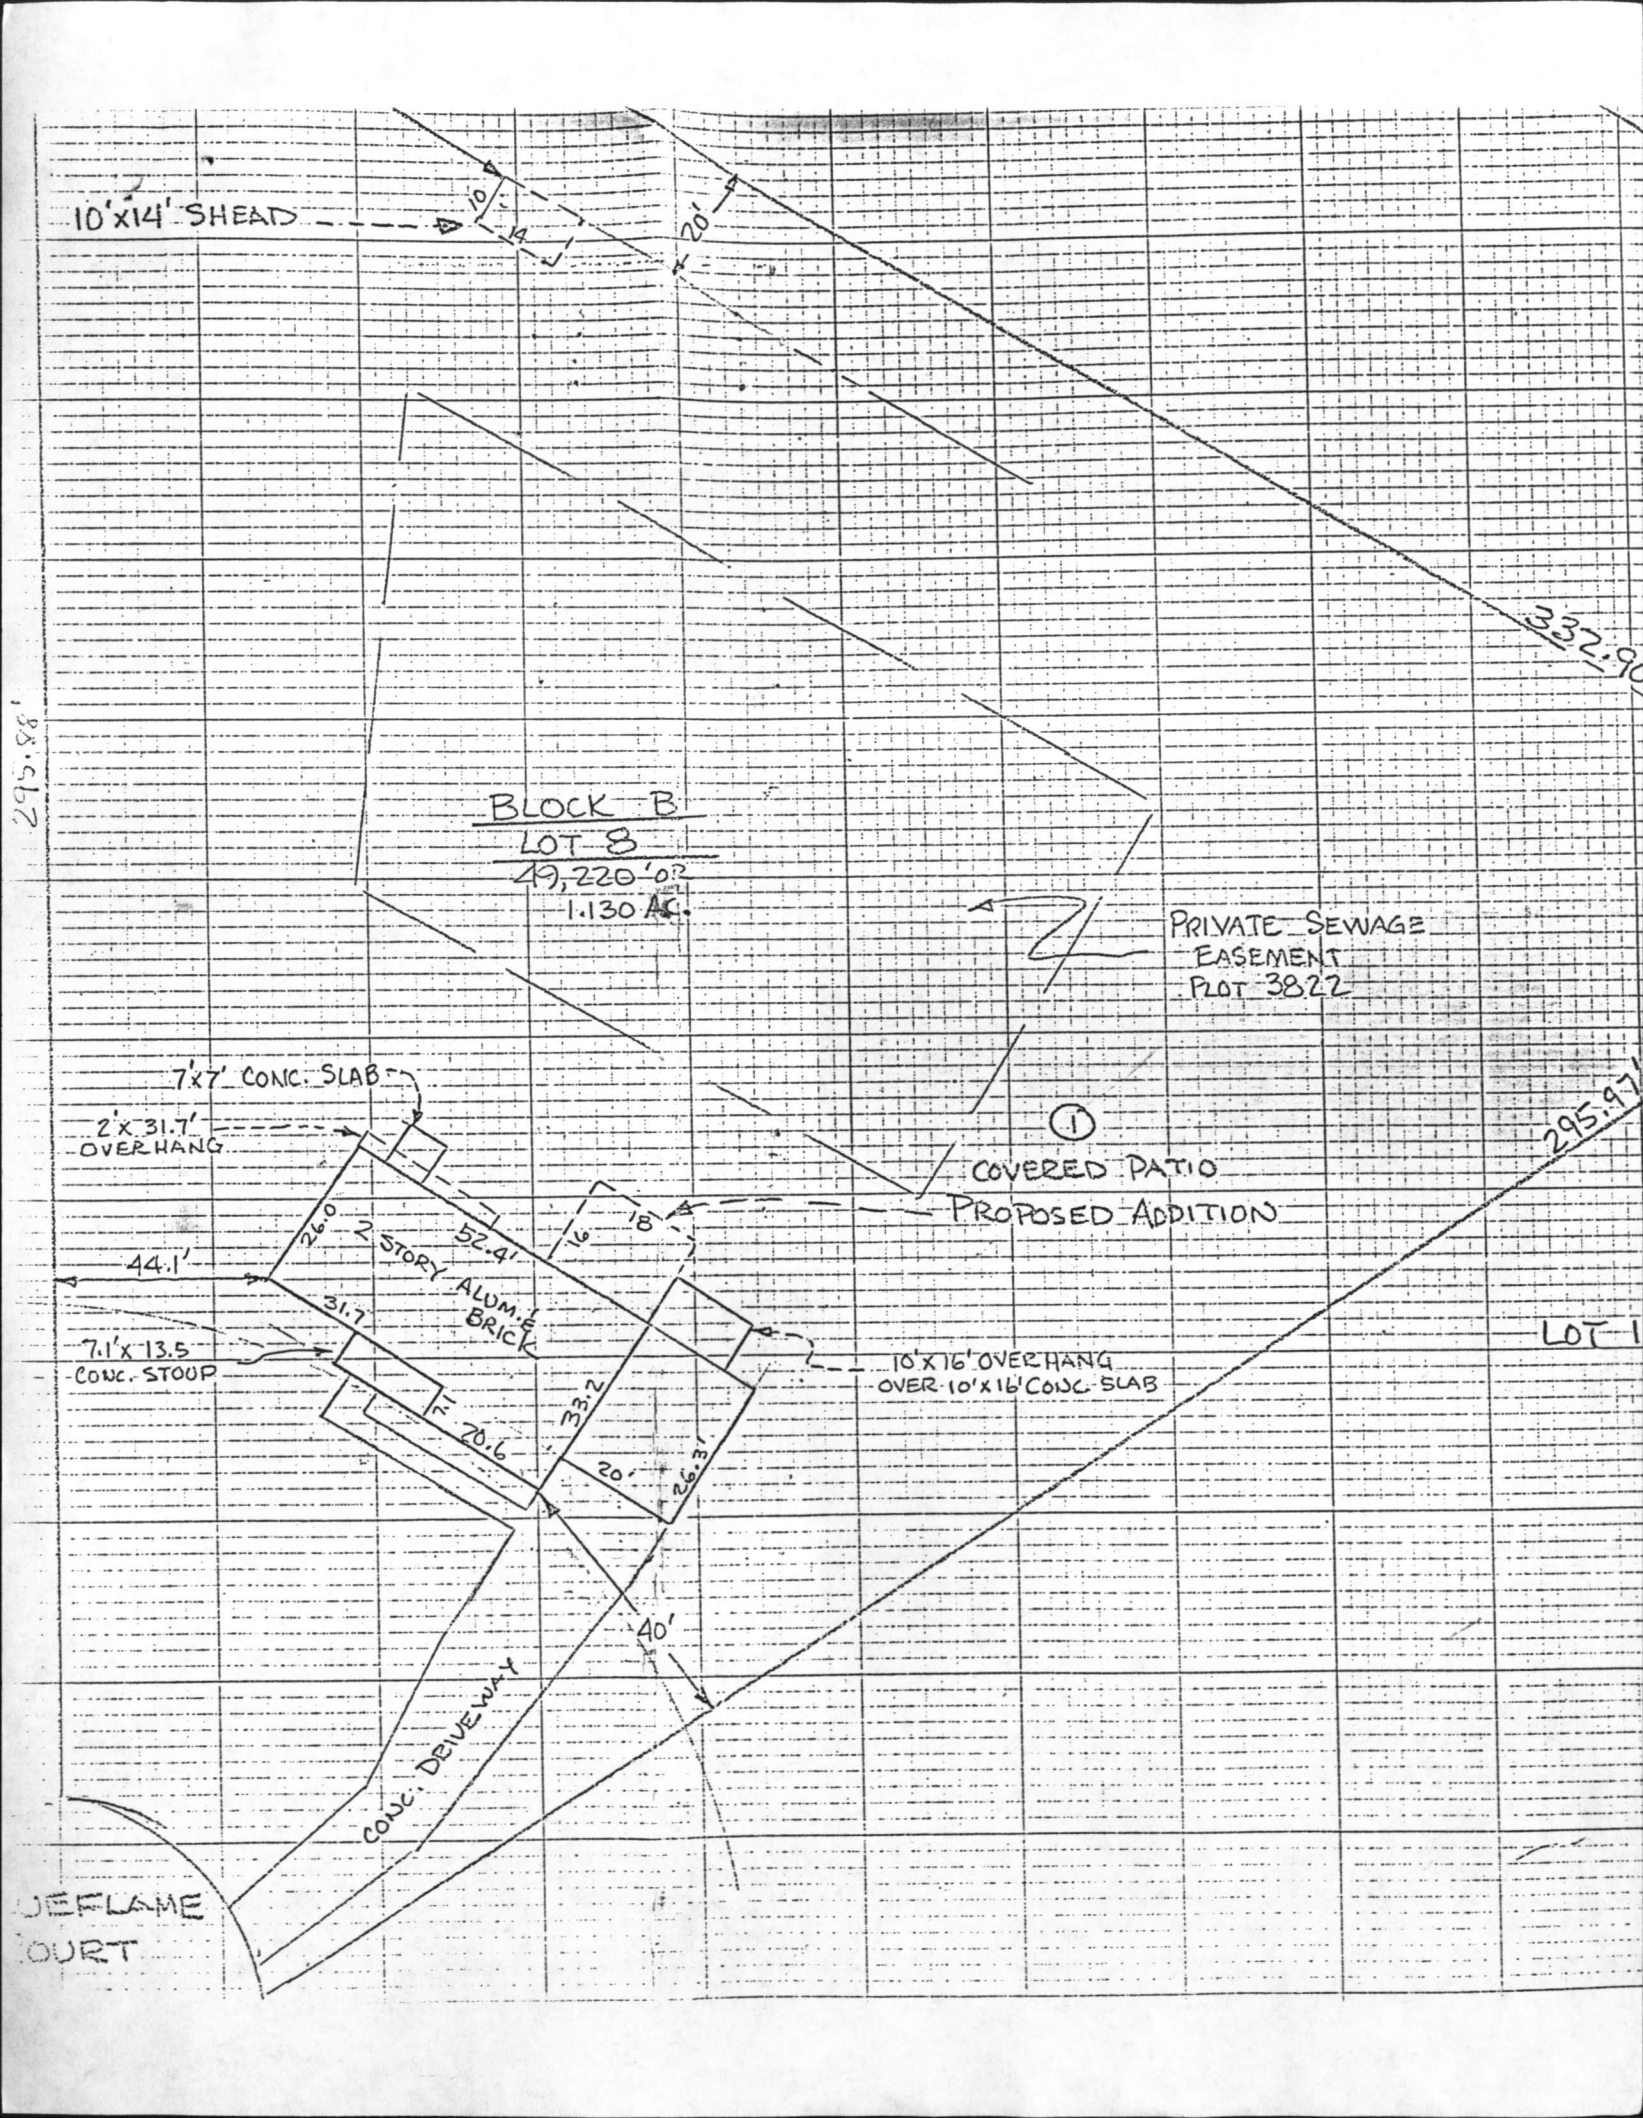

EXTENSION TO EXISTING
OVER HANG ROOF LINE

EXISTING 10X16 OVERHANG

6/12 PITCH

SIDING
CLASSIC CREAM
REVERSE - T1 WOOD GRAIN

9' OVER HANG

APPROX. 2' WALL

(10'X16')
EXISTING CEMENT PAD

PERIMETER WALL 32"

4" CONCRETE SLAB (16'X18')

VAPOR BARRIER

6" GRAVEL FILL

CONCRETE
FOUNDATION
WALL

EXISTING EARTH

12" THK X 24" WIDE
CONCRETE FOOTING

EXISTING
STRUCTURE

ADDITION

EXISTING
GROUND
LEVEL

5/8" DIA STEEL
RODS - SPACED
E.A. FOOT.

SEPTIC
SYSTEM

OK TO PROCEED
FROM DN TO TANK
5/11/62