

4/29/68

97 4-29-68  
sum

# PERMIT

SEWAGE DISPOSAL SYSTEM

P. 13531

A. 13471

MARYLAND STATE DEPARTMENT OF HEALTH

HOWARD COUNTY

ELLICOTT CITY

## INDEXED

DISTRICT 6

DATE 4/19/68

Paul Bounds IS PERMITTED TO INSTALL  ALTER

ADDRESS Brooklyn Bridge Road, Laurel, Md. PHONE EA 5-1359

A SEWAGE DISPOSAL SYSTEM LOCATED AT

SUBDIVISION ROAD Dumhart Rd. off LOT Stansfield Rd.

PROPERTY OWNER Ralph E. Giddings

ADDRESS

SPECIFICATIONS - 3 bedrooms

DRAIN FIELD DEPTH FEET, BOTTOM AREA SQ. FT.

SEEPAGE PITS ABSORBENT SIDE-WALL AREA SQ. FT.

SEPTIC TANK CAPACITY 750 GALLONS

FOR GARBAGE GRINDER, INCREASE DISPOSAL AREA 22% & TANK CAPACITY 50%.

OTHER ~~Dry well - 300 sq. ft. sidewall area below the top 4 ft. of clay, with a maximum depth of 12 ft. Place the dry well 100 ft. from the front lot line and 50 ft. from the right side of the lot as seen when facing the lot from the front lot line. The water well should not be used because the dry well will be too close to it.~~


PERMIT VOID AFTER THREE YEARS.  
PLANS APPROVED BY Raymond Hodges DATE 4/18/68

FILL SEPTIC TANK AND DISTRIBUTION BOX WITH WATER BEFORE CALLING FOR AN INSPECTION. COVER NO WORK UNTIL INSPECTED AND APPROVED.

NEITHER THE HOWARD COUNTY COMMISSIONERS NOR THE HEALTH DEPARTMENT IS RESPONSIBLE FOR THE SUCCESSFUL OPERATION OF ANY SYSTEM.

### NOTIFY THE HEALTH DEPARTMENT 48 HOURS BEFORE EXCAVATIONS ARE TO BE BACK FILLED.

13471

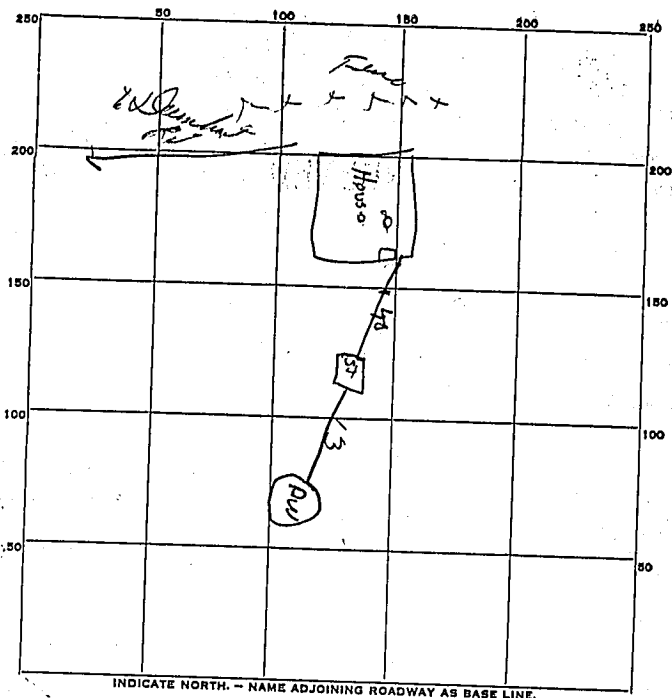

PERMIT CARD \_\_\_\_\_

SEPTIC TANK, LEVEL OK

CLEANOUTS OK

DISTRIBUTION BOX, LEVEL \_\_\_\_\_

TILE FIELD, DEPTH \_\_\_\_\_ FT. TRENCH WIDTH \_\_\_\_\_ FT.

GRAVEL DEPTH \_\_\_\_\_ IN. TOTAL LENGTH \_\_\_\_\_ FT.

NUMBER OF TRENCHES \_\_\_\_\_ TOTAL BOTTOM AREA \_\_\_\_\_

SEEPAGE PITS, <sup>outside</sup> ~~inside~~ DIAMETER 12 FT. DEPTH BELOW INLET 9 FT.

ABSORBENT AREA 338 SQ. FT.

REMARKS \_\_\_\_\_  
 \_\_\_\_\_  
 \_\_\_\_\_  
 \_\_\_\_\_  
 \_\_\_\_\_

DATE SYSTEM APPROVED 4/29/68

INSPECTOR DW Monegh