

APPLICATION

A 16473

P _____

SEWAGE DISPOSAL TESTING

MARYLAND STATE DEPARTMENT OF HEALTH

HOWARD COUNTY

ELLICOTT CITY

DISTRICT 4

DATE 11/17/71

TO: THE COUNTY HEALTH OFFICER
ELLICOTT CITY, MARYLAND

I, HEREBY, APPLY FOR THE NECESSARY TESTS IN ORDER TO CONSTRUCT (OR RECONSTRUCT) A SEWAGE DISPOSAL SYSTEM.

PROPERTY OWNER James McGrath (Contract Purchaser)

Any questions call:

ADDRESS _____ PHONE R. Norman Waller

442-2102

PROPERTY LOCATION:

SUBDIVISION _____ LOT NO. 8

ROAD AND DESCRIPTION Duvall Road

OCCUPANT _____ PHONE _____

PERSON TO CONSTRUCT SYSTEM _____

ADDRESS _____ PHONE _____

SIZE OF LOT 5,000 acres TYPE BLDG. 3

NUMBER OF BEDROOMS

(Single Fmly. Dwllg.)

IF NOT SINGLE RESIDENCE DESCRIBE _____

SIGNATURE OF APPLICANT /s/ R. Norman Waller

APPROVED BY [Signature] FOR [Signature] DATE 11/24/71

(KIND OF SYSTEM)

REJECTED BY _____ FOR _____ DATE _____

(KIND OF SYSTEM)

HOLD PENDING FURTHER TESTS _____ DATE _____


REASONS FOR REJECTION OR HOLDING _____

APPROVED BY _____

TESTED BY _____

THIS IS NOT A PERMIT

APPLICATION

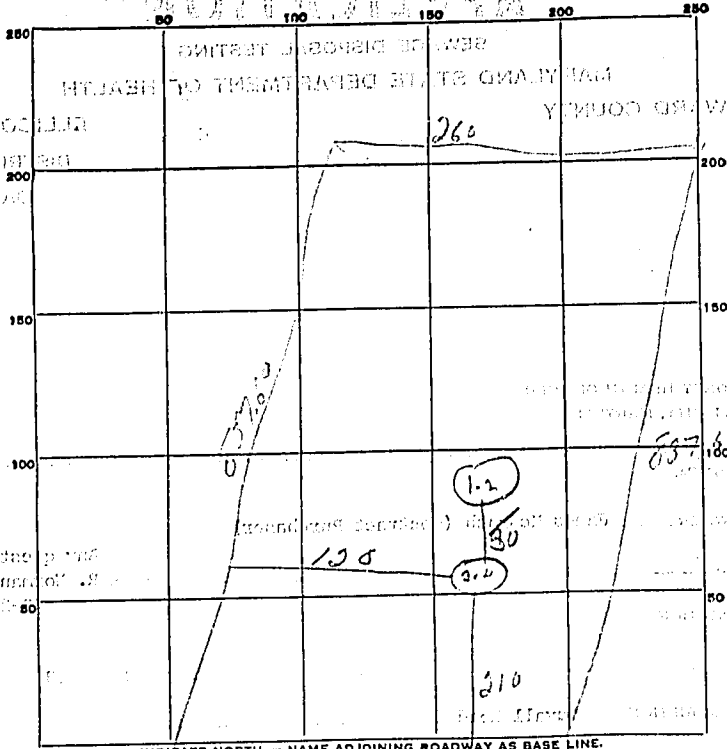

DATE	TEST NO.	DEPTH	PRE-WET		TEST - 1" DROP		TIME
			START	STOP	START	STOP	
11/24/71	1	5ft	10 02	16 06	10 06	10 15	9 min
	2	12.8ft	10 03	10 04	10 04	10 14	10 min
	3	5ft	10 04	10 09	10 08	10 18	9 min
	4	13.8ft	10 05	10 07	10 07	10 18	7 min


SOIL AUGER FINDING

TESTED BY *[Signature]*

REMARKS

dist. measured to edge of road

A116473

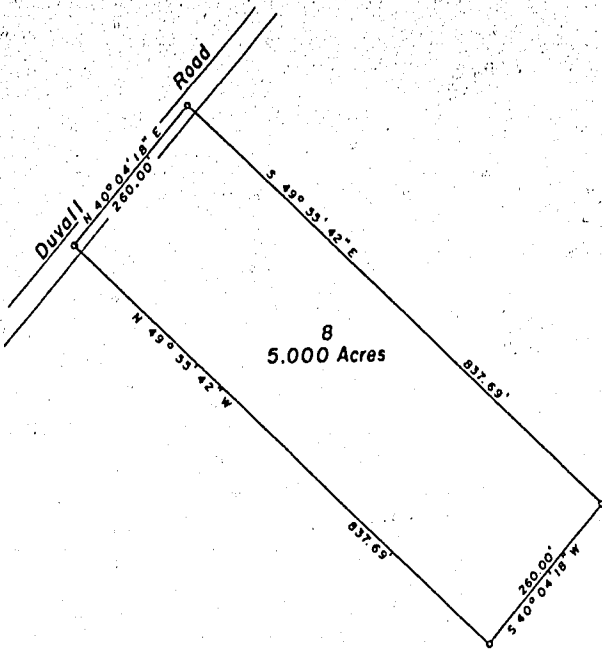

PLAT OF SURVEY
 FOR
 BENJAMIN F. SLAGLE
 FOURTH ELECTION DISTRICT OF HOWARD COUNTY
 WOODBINE, MARYLAND
 SCALE: 1 IN. = 200 FT. JULY 28, 1971

James Mcguffee
To: William A. Miller
Station Md.
442-2102

Claude M. Skinner Jr.
 Claude M. Skinner Jr. Reg. Engineer & Land Surveyor No. 2237

3 Redwood