

4/28/72

7/28/72
app. Dun

PERMIT

SEWAGE DISPOSAL SYSTEM

MARYLAND STATE DEPARTMENT OF HEALTH

HOWARD COUNTY

P: 16391
A: 16473

ELLICOTT CITY

DISTRICT 4

DATE 5/3/72

INDEXED

Buy and Lowe IS PERMITTED TO INSTALL ALTER

ADDRESS 6220 Griffith Road, Laytonville, Md. PHONE 253-2663

A SEWAGE DISPOSAL SYSTEM LOCATED AT _____

SUBDIVISION _____ ROAD 2760 Duvall LOT 8

PROPERTY OWNER John Tacchetti

ADDRESS 9338 Baltimore Pike, Ellicott City, Md. 465-5234

SPECIFICATIONS - 4 bedrooms

DRAIN FIELD _____ DEPTH _____ FEET, BOTTOM AREA _____ SQ. FT.

SEEPAGE PITS _____ ABSORBENT SIDE-WALL AREA _____ SQ. FT.

SEPTIC TANK CAPACITY 1,200 GALLONS

FOR GARBAGE GRINDER, INCREASE DISPOSAL AREA 22% & TANK CAPACITY 50%.

OTHER Dry well - 436 sq. ft. absorbent sidewall area to begin below the first 4 ft. of non-absorbent ground. Max. depth permitted for dry well is 12 ft. below original grade. Place dry well 260 ft. from edge of Duvall Road and 120 ft. from left side line

as soon when facing lot from Duvall Road.

NOTE: ALL PIPE FROM HOUSE TO SEPTIC TANK MUST BE CAST IRON.

PERMIT VOID AFTER THREE YEARS.

NOTE: INSTALL STAND PIPE ON SEPTIC TANK AND DRY WELL.

PLANS APPROVED BY D. W. Monaghan DATE 11/24/71


FILL SEPTIC TANK AND DISTRIBUTION BOX WITH WATER BEFORE CALLING FOR AN INSPECTION. COVER NO WORK UNTIL INSPECTED AND APPROVED.

NEITHER THE HOWARD COUNTY COMMISSIONERS NOR THE HEALTH DEPARTMENT IS RESPONSIBLE FOR THE SUCCESSFUL OPERATION OF ANY SYSTEM.

BLDG. PERMIT SIGNED
AND RETURNED 8/13/72
Serial # 44983
2 story addition

A 16473

60/20/20

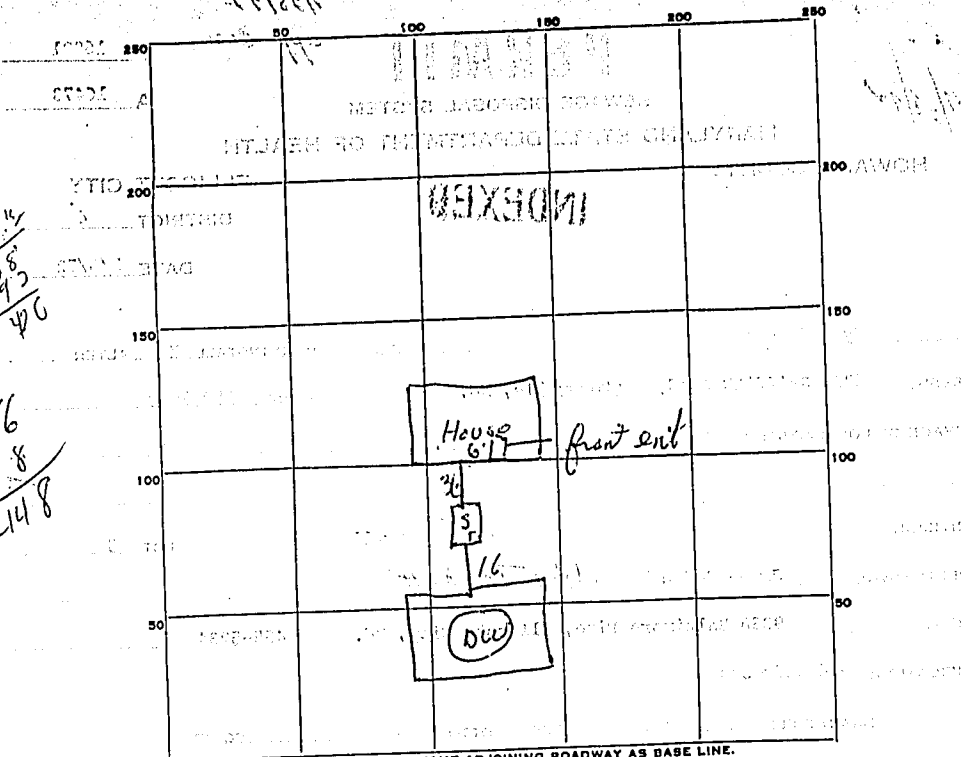

$$\frac{56.4}{\frac{38}{375}} = 440$$

$$\frac{56}{8} = 448$$

INDICATE NORTH - NAME ADJOINING ROADWAY AS BASE LINE.

PERMIT CARD OK

SEPTIC TANK, LEVEL OK CLEANOUTS OK

DISTRIBUTION BOX, LEVEL _____

TILE FIELD, DEPTH _____ FT. TRENCH WIDTH _____ FT.

GRAVEL DEPTH _____ IN. TOTAL LENGTH _____ FT.

NUMBER OF TRENCHES _____ TOTAL BOTTOM AREA _____

SEEPAGE PITS, INSIDE DIAMETER Perimeter 56 1/2 FT. DEPTH BELOW INLET 8 7/8 FT.

ABSORBENT AREA 448 SQ. FT.

REMARKS _____

DATE SYSTEM APPROVED 7/28/72 INSPECTOR DW. P. [Signature]

A16473

340°04'18"W 260.00'

Lot 8
5.0 ACRES

MARCH 16 1972
SCALE: 1"=100'

NOTE:
All Elevations are assumed.

I hereby certify that
the measurements shown &
assumed elevation differences
are correct to the best
of my knowledge & belief

Daniel M. Keusel
Daniel M. Keusel

Ground elev. at time of
percolation test = 96.0
at dry well

Invert elev @ house = 93.0
Invert elev @ tank = 92.2
Invert elev @ D.W. = 91.0

Elev at Well = 105.0 ±

OK.
3-20-72
dk

