

# APPLICATION

A 02751  
P 02970

SEWAGE DISPOSAL TESTING

MARYLAND STATE DEPARTMENT OF HEALTH

HOWARD COUNTY 750 Gallon Tank

ELLICOTT CITY

Dry Well - 390 sq. ft. sidewalk  
area below the inlet

DISTRICT 4

DATE July 25, 1960

Place the dry well about 130 ft to  
170 ft from the edge of Duwall Rd  
and about 100 ft to 140 ft from the side  
of the garage (T hat side which  
is further from  
Mullinix Rd)

TO: THE COUNTY HEALTH OFFICER  
ELLICOTT CITY, MARYLAND

I, HEREBY, APPLY FOR THE NECESSARY TESTS IN ORDER TO CONSTRUCT (OR RECONSTRUCT) A SEWAGE  
DISPOSAL SYSTEM.

PROPERTY OWNER John Colius Duvall

Address Woodbine Route 2 Box 49

PHONE Glenwood 396W3

PROPERTY LOCATION:

SUBDIVISION

LOT NO.

ROAD AND DESCRIPTION Off 94 to Mullinix Road, Rt on to Duvall Rd, building site is  
on left side of road just beyond the <sup>third</sup> house.  
second

OCCUPANT

PHONE

PERSON TO CONSTRUCT SYSTEM ~~XXXXXXXXXX~~ Preston Brown

ADDRESS ~~XXXXXXXX~~ Mt. Airy

PHONE

SIZE OF LOT 10 acres

TYPE BLDG. 2

NUMBER OF BEDROOMS

IF NOT SINGLE RESIDENCE DESCRIBE

SIGNATURE OF APPLICANT John Colius Duvall

APPROVED: Raymond Hodges FOR Dry Well

DATE 7/29/60

REJECTED BY FOR

DATE


HOLD PENDING FURTHER TESTS R.H.

DATE

7/28/60

REASONS FOR REJECTION OR HOLDING 7/2/60 resolution in only one shallow hole  
for a tile field.

## THIS IS NOT A PERMIT

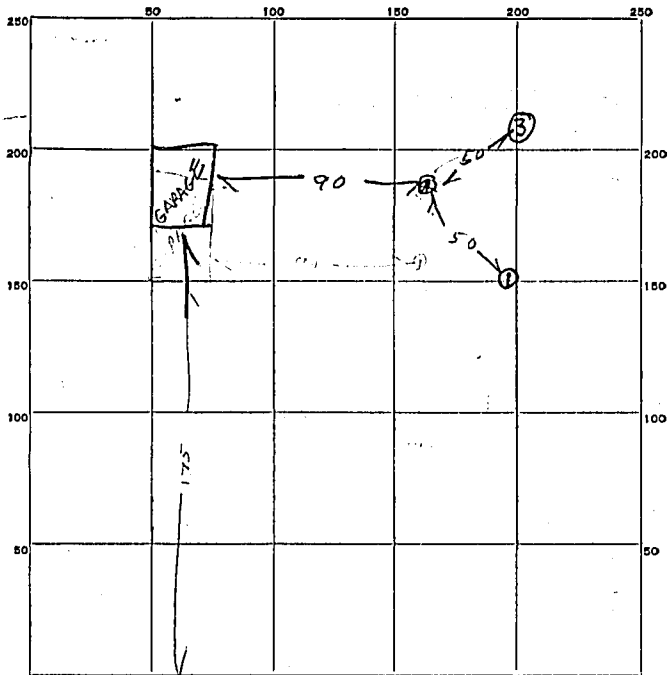

TO MULLINIX RD

INDICATE NORTH. - NAME ADJOINING ROADWAY AS BASE LINE.

DUVALL RD

DATE	TEST NO.	DEPTH	PRE-WET		TEST - 1" DROP		TIME
			START	STOP	START	STOP	
7/27/60	1	4	132	138	138	150	2 min
	2	3 1/2	134	213	little pore		
	3	3	136	213	little pore		
7/29/60	4	9	101	105	105	132	21 min
	5	5	101	105	105	111	6 min

SOIL AUGER FINDING

TESTED BY

Raymond Hodges 7/29/60 B/H

REMARKS

(4) & (5) dig in same hole as #1

ALSO PRESENT

John L. Duvall 7/29/60 JLD  
LOT NO. JLDuvall