

APPLICATION

A 21319

SEWAGE DISPOSAL TESTING

P _____

STATE OF MARYLAND - DEPARTMENT OF HEALTH AND MENTAL HYGIENE

HOWARD COUNTY HEALTH DEPARTMENT
ENVIRONMENTAL HEALTH SERVICES
P. O. BOX 476, ELLICOTT CITY, MARYLAND 21043
TELEPHONE: 465-5000, EXT. 356

DISTRICT Fourth

DATE 3/26/75

TO: THE COUNTY HEALTH OFFICER
ELLICOTT CITY, MARYLAND

I, HEREBY, APPLY FOR THE NECESSARY TEST IN ORDER TO CONSTRUCT (OR RECONSTRUCT) A SEWAGE DISPOSAL SYSTEM.

PROPERTY OWNER Lawrence W. and Glyndon L. Dabbs

ADDRESS 3570 Powder Mill Road, #101, Beltsville, Md. 20705 PHONE (301)937-8086

PROPERTY LOCATION:

SUBDIVISION N/A LOT NO. N/A

ROAD AND DESCRIPTION Duvall Road -- South west of Mullinix Rd. (approx. 300 yds. from Mullinix Rd.)

SIZE OF LOT 2.500 acres TYPE BLDG. Single-family house
NUMBER OF BEDROOMS 3-4

IF NOT SINGLE RESIDENCE DESCRIBE _____

THE SYSTEM INSTALLED UNDER THIS APPLICATION IS ACCEPTABLE ONLY UNTIL PUBLIC FACILITIES BECOME AVAILABLE.

SIGNATURE OF APPLICANT Lawrence W. Dabbs



APPROVED BY _____ FOR _____ DATE _____
(KIND OF SYSTEM)

REJECTED BY _____ FOR _____ DATE _____
(KIND OF SYSTEM)

HOLD PENDING FURTHER TESTS _____ DATE _____

REASONS FOR REJECTION OR HOLDING _____

THIS IS NOT A PERMIT

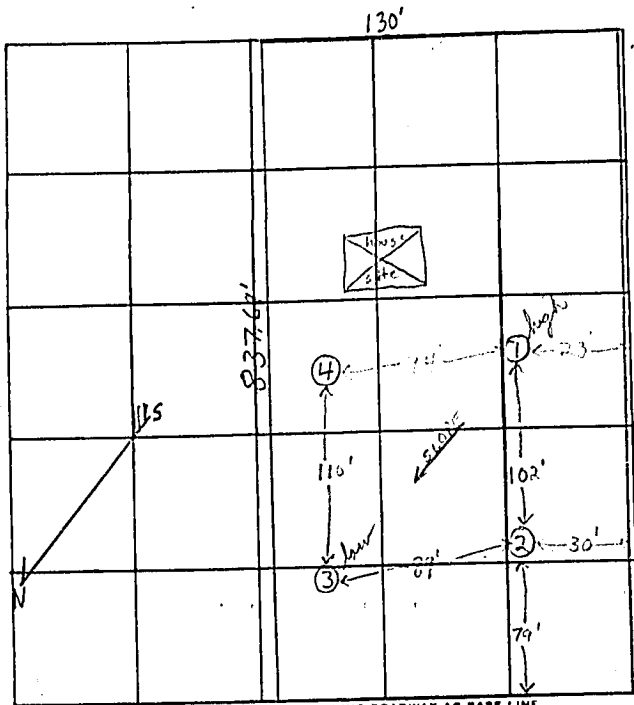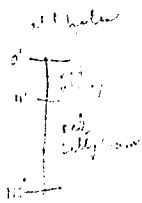

INDICATE NORTH. - NAME ADJOINING ROADWAY AS BASE LINE

Dovell Rd.

DATE	TEST NO.	DEPTH	PRE-WET		TEST - 1" DROP		TIME
			START	STOP	START	STOP	
5/2/75	1 high	4 1/2'	10:02	10:05	10:05	10:13	8 min.
	1A	11 1/2'	10:00	10:13	10:13	10:47	27 min.
	2	4'	10:14	10:19	10:19	10:26	8 min.
	2A	11 1/2'	10:13	10:19	10:19	10:28	9 min.
	3 low	4'	10:23	10:31	10:31	10:50	19 min.
	3A	11'	10:18	10:19	10:19	10:21	2 min.
	4	11 1/2'	10:00	10:13	10:13	10:47	27 min.

12.5 min. avg.
155 #/B.R.
inlet 4 1/2'

REMARKS

TYPE OF SOIL clayey to 4' silty loam some with shale below

TESTED BY E.S. + J.M. ALSO PRESENT: H.S. + K.F.