

1/29/79
1/26/79
trench
early afternoon

Approved 1/26/79
GLK
30 Jan 79
P 29421
A 24782
P.C.C.
C.B.J.

PERMIT

SEWAGE DISPOSAL SYSTEM
MARYLAND STATE DEPARTMENT OF HEALTH*

HOWARD COUNTY

ELLICOTT CITY

INDEXED

DISTRICT 5th

05-380618

DATE 1/16/79

Jim Brittingham IS PERMITTED TO INSTALL ALTER

ADDRESS 3004 N. Rogers Avenue, Ellicott City, Md. 21043 PHONE 461-1870

SUBDIVISION The Heritage ROAD 14218 Day Farm Road LOT 30, Sec. 2

PROPERTY OWNER Grayson Homes Kenneth E. Melton

ADDRESS 2000 Century Plaza, Suite 245, Columbia, Md. 21044 Phone: 997-1250

SPECIFICATIONS 4 bedrooms

SEPTIC TANK CAPACITY 1250 GALLONS

DRAIN FIELD _____ DEPTH _____ FEET, BOTTOM AREA _____ SQ. FT.

DEEP TRENCH _____ DEPTH _____ FEET, BOTTOM AREA _____ SQ. FT.

SEEPAGE PITS ABSORBENT SIDE-WALL AREA 300 SQ. FT. total sidewall area in dry well.

INLET PIPE 4 FT. BELOW ORIGINAL GRADE. MAXIMUM DEPTH 10 FT. BELOW ORIGINAL GRADE

EFFECTIVE DEPTH AT _____ FT. BELOW ORIGINAL GRADE.

LOCATE DISPOSAL AREA 140 FT. FROM front LOT LINE AND 20 FT. FROM left LOT LINE AS SEEN WHEN FACING LOT FROM the road.

Begin the trenches after a 5 ft. earth buffer. The trenches will each be 55 ft. long, 2 ft. wide, 10 ft. deep and contain 6 ft. of stone. Trenches will follow contour of the land.

PLANS APPROVED BY Robert T. Moorefield DATE 2/19/77

COVER NO WORK UNTIL INSPECTED AND APPROVED.

NEITHER THE HOWARD COUNTY COUNCIL NOR THE HEALTH DEPARTMENT IS RESPONSIBLE FOR THE SUCCESSFUL OPERATION OF ANY SYSTEM.

NOTE: IF TRENCH IS USED CALL FOR INSPECTION BEFORE PLACING GRAVEL IN TRENCH.

NOTE: NO DRY WELL SHALL EXCEED 15 FOOT IN DIAMETER.

NOTE: ALL PIPE FROM HOUSE TO DISPOSAL AREA MUST BE CAST IRON.

PERMIT VOID AFTER THREE YEARS.


NOTE: INSTALL STAND PIPE ON SEPTIC TANK AND DRY WELL. STAND PIPES MUST BE 8 INCHES IN DIAMETER. CAST IRON, CONCRETE OR TERRA COTTA ACCEPTED.

*INSTALLER IS RESPONSIBLE FOR OBTAINING FINAL APPROVAL ON THIS PERMIT.

BLDG. PERMIT SIGNED
AND RETURNED 8/21/87
Serial # 14095
P.M.

A 24782

need 960
total

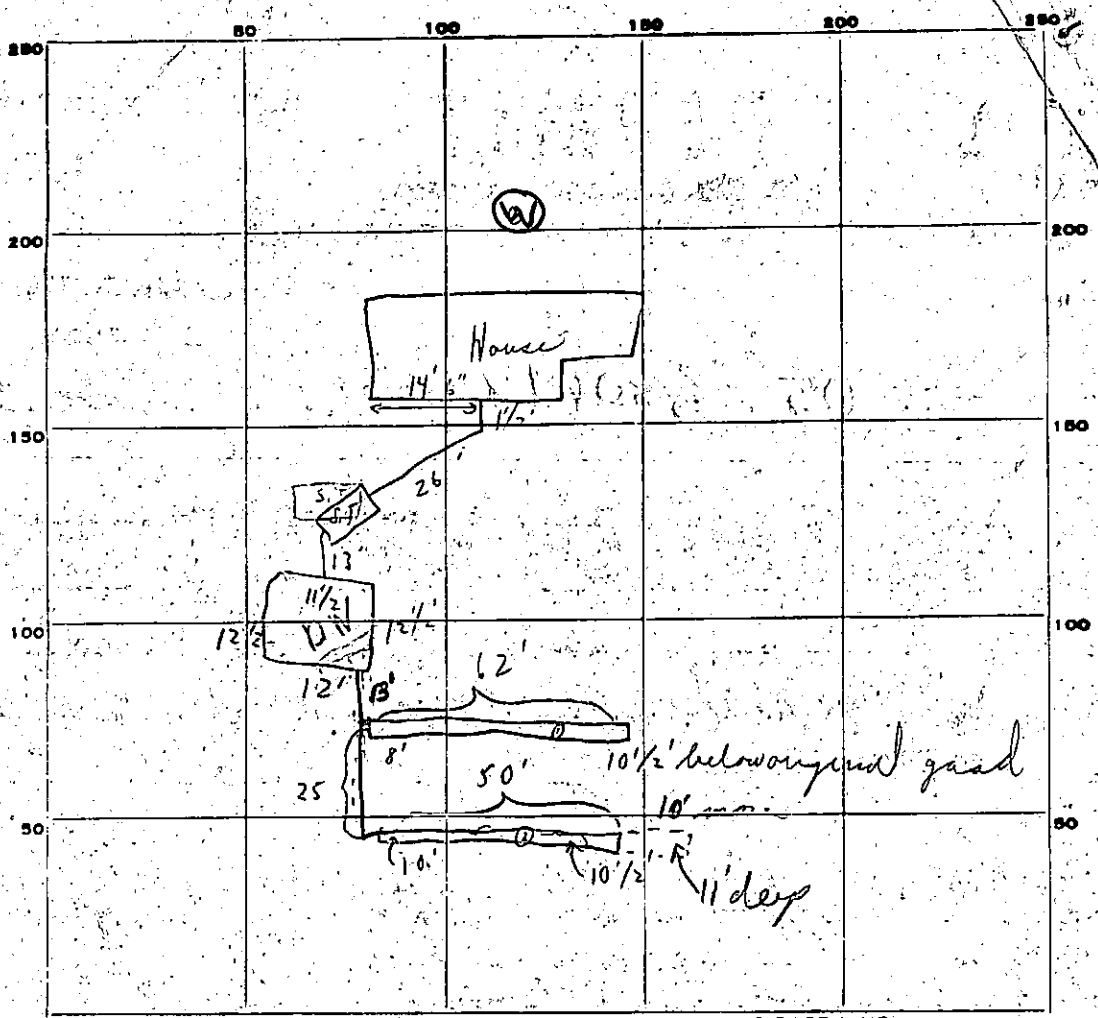

INDICATE NORTH - NAME ADJOINING ROADWAY AS BASE LINE.

43
+6

858
376

372

PERMIT CARD 1/30 1/26/79 (Not seen) Day Farm Rd
SEPTIC TANK, LEVEL ok CLEANOUTS ok ok

DISTRIBUTION BOX, LEVEL N/A
Trench 1 8' x 19' 2 50' x 10 1/2' 3 6' x 37.2'
TILE FIELD, DEPTH 1 8' 2 10 1/2' avg 3 10'
GRAVEL DEPTH 1 8' 2 10 1/2' 3 10'
TRENCH WIDTH 1 19' 2 10' 3 10'
TOTAL LENGTH 1 19' 2 50' 3 37.2' total 122'
TOTAL BOTTOM AREA 1 152' 2 500' 3 223' total 706'
SEEPAGE PITS, INSIDE DIAMETER 1 48.5' 2 48.5' 3 48.5' total 145.5'
DEPTH BELOW INLET 1 6' 2 6' 3 6' total 18'

Total ABSORBENT AREA ±997 SQ. FT.

REMARKS P.M. 1/26/79 #1 trench 62' long, 8' front 19' back 43' 10 1/2' deep
#2 trench 50' long, 10' width, 10 1/2' deep
#3 Needed 6' of trench - added 10' more while vegetation inspected father's lot
partial-ok to cover front head of drywell near trenches - no p.s. from trenches to drywell at this inspection, 29 Jan 79 - Need to add gravel to trenches (GLK) 1/30/79 - FINAL OK (GLK) C.B.E.

DATE SYSTEM APPROVED 1/30/79 INSPECTOR George Keller

C 1 **3103** SEQUENCE NO. (WRA USE ONLY)

1 2 3 (SEQ. NO.) 6
(THIS NUMBER IS TO BE PUNCHED IN COLS. 3-6 ON ALL CARDS)

STATE OF MARYLAND
WATER RESOURCES ADMINISTRATION
 TAWES STATE OFFICE BLDG., ANNAPOLIS, MD. 21401
WELL COMPLETION REPORT

THIS REPORT MUST BE SUBMITTED WITHIN 30 DAYS AFTER WELL COMPLETION

FILL IN THIS FORM COMPLETELY

COUNTY NUMBER

DATE RECEIVED (WRA USE ONLY) 10/18/78 DEPTH OF WELL 185 PERMIT NO. FROM "PERMIT TO DRILL WELL" 44-AS-2993

DATE WELL COMPLETED 10/18/78 (TO NEAREST FOOT) 22 26

8-13 15 20 DRILLERS IDENTIFICATION NO. 209

OWNER GRAYSON LAST NAME Floyd FIRST NAME

STREET OR RFD 2000 Century Plaza POST OFFICE Columbia, Md. 21044

WELL LOG

STATE THE KIND OF FORMATIONS PENETRATED, THEIR COLOR, DEPTH, THICKNESS AND IF WATER BEARING

DESCRIPTION (USE ADDITIONAL SHEETS IF NECESSARY)	FEET		CHECK IF WATER BEARING
	FROM	TO	
Mica Soil	0	50	
Mica Sand	50	185	X

GROUTING RECORD

WELL HAS BEEN GROUTED (CIRCLE APPROPRIATE BOX) Y N

TYPE OF GROUTING MATERIAL (CIRCLE BOX):
 CEMENT C M BENTONITE CLAY B C

NO. OF BAGS 17 NO. OF POUNDS 1615

GALLONS OF WATER 136

DEPTH OF GROUT SEAL (TO NEAREST FOOT)
 FROM 0 FT. TO 18 FT.
 (ENTER 0 IF FROM SURFACE)

CASING RECORD

INSERT APPROPRIATE CODE BELOW

STEEL S T CONCRETE C O

PLASTIC P L OTHER O T

MAIN CASING TYPE S T NOMINAL DIAMETER TOP (MAIN) CASING (NEAREST INCH) 6 TOTAL DEPTH OF MAIN CASING (NEAREST FOOT) 51

OTHER CASING (IF USED)

EACH CASING	DIAMETER (INCH)		DEPTH (FEET)	
	FROM	TO	FROM	TO
1				
2				

SCREEN RECORD

INSERT APPROPRIATE CODE BELOW

STEEL S T BRASS OR BRONZE B R OPEN HOLE H O

PLASTIC P L OTHER O T

DEPTH (NEAREST WHOLE FOOT)

FROM TO

1 8 9 11 15 17 21

2 23 24 26 30 32 36

3 38 39 41 45 47 51

SLOT SIZE 1, 2, 3,

DIAMETER OF SCREEN 56 60 (NEAREST INCH)
 FROM TO

GRAVEL PACK

IF WELL DRILLED WAS A FLOWING WELL CIRCLE BOX 68 F

WRA USE ONLY (NOT TO BE FILLED IN BY DRILLER)

T 70 (E.R.O.S.) 72 W Q 74 75 76 OTHER DATA AVAILABLE

TELESCOPE CASING LOG INDICATOR

PUMPING TEST

HOURS PUMPED (TO NEAREST HOUR) 8 9

PUMPING RATE (GALLONS PER MINUTE TO NEAREST GALLON) 4 11 15

METHOD USED TO MEASURE PUMPING RATE

WATER LEVEL: (DISTANCE FROM LAND SURFACE)
 BEFORE PUMPING 30 (NEAREST FOOT) 17 20

WHEN PUMPING 175 (NEAREST FOOT) 22 25

TYPE OF PUMPED USED (CIRCLE APPROPRIATE BOX) (FOR PUMPING TEST)

A AIR P PISTON T TURBINE

C CENTRIFUGAL R ROTARY O OTHER (DESCRIBE BELOW)

J JET S SUBMERSIBLE

PUMP INSTALLED

TYPE OF PUMP (WRITE APPROPRIATE LETTER IN BOX - SEE ABOVE: A, C, J, P, R, S, T, O) 29

DRILLER WILL INSTALL PUMP (CIRCLE APPROPRIATE BOX) Y N

CAPACITY:
 GALLONS PER MINUTE (TO NEAREST GALLON) 31 35

PUMP HORSE POWER 37 41

PUMP COLUMN LENGTH (NEAREST FOOT) 43 47

CASING HEIGHT (CIRCLE APPROPRIATE BOX AND ENTER CASING HEIGHT)

ABOVE } LAND SURFACE

BELOW } 2 (NEAREST FOOT)

LOCATION OF WELL ON LOT

SHOW PERMANENT STRUCTURE SUCH AS BUILDINGS, SEPTIC TANKS, AND/OR OTHER LAND MARKS AND INDICATE NOT LESS THAN TWO DISTANCES (MEASUREMENTS TO WELL).

CIRCLE APPROPRIATE BOXES

A A WELL WAS ABANDONED AND SEALED WHEN THIS WELL WAS COMPLETED

E ELECTRIC LOG OBTAINED

P TEST WELL CONVERTED TO PRODUCTION WELL

I HEREBY CERTIFY THAT I HAVE COMPLIED WITH ALL CONDITIONS STATED ON THE ABOVE-CAPTIONED "PERMIT TO DRILL WELL", AND THAT INFORMATION CONTAINED IN THIS REPORT IS TRUE, ACCURATE, AND COMPLETE TO THE BEST OF MY KNOWLEDGE, INFORMATION AND BELIEF.

DRILLERS NAME Howard Dillon

(PLEASE PRINT) Howard Dillon

SIGNATURE Howard Dillon

C 1 **3103** SEQUENCE NO. (WRA USE ONLY)

1 2 3 (SEQ. NO.) 6
(THIS NUMBER IS TO BE PUNCHED IN COLS. 3-6 ON ALL CARDS)

STATE OF MARYLAND
WATER RESOURCES ADMINISTRATION
 TAWES STATE OFFICE BLDG., ANNAPOLIS, MD. 21401
WELL COMPLETION REPORT

THIS REPORT MUST BE SUBMITTED WITHIN 30 DAYS AFTER WELL COMPLETION

FILL IN THIS FORM COMPLETELY

COUNTY NUMBER

DATE RECEIVED (WRA USE ONLY) **OCT 20 1978** 8-13

DATE WELL COMPLETED **10/18/78**

DEPTH OF WELL **185** (TO NEAREST FOOT)

PERMIT NO. FROM "PERMIT TO DRILL WELL" **HO-73-2993**

DRILLERS IDENTIFICATION NO. **209**

OWNER **GRAYSON** LAST NAME **Floyd** FIRST NAME

STREET OR RFD **2000 Century Plaza** POST OFFICE **Columbia, Md. 21044**

WELL DESCRIPTION

WELL LOG

STATE THE KIND OF FORMATIONS PENETRATED, THEIR COLOR, DEPTH, THICKNESS AND IF WATER BEARING

DESCRIPTION (USE ADDITIONAL SHEETS IF NECESSARY)	FEET		CHECK IF WATER BEARING
	FROM	TO	
Mica Soil	0	50	
Mica Sand	50	185	X

GROUTING RECORD

WELL HAS BEEN GROUTED (CIRCLE APPROPRIATE BOX) YES NO

TYPE OF GROUTING MATERIAL (CIRCLE BOX):
 CEMENT BENTONITE CLAY

NO. OF BAGS **17** NO. OF POUNDS **1615**

GALLONS OF WATER **136**

DEPTH OF GROUT SEAL (TO NEAREST FOOT)
 FROM **0** FT. TO **48** FT.

CASING RECORD

INSERT APPROPRIATE CODE BELOW

STEEL CONCRETE
 PLASTIC OTHER

MAIN CASING TYPE S T

NOMINAL DIAMETER TOP (MAIN) CASING (NEAREST INCH) **6**

TOTAL DEPTH OF MAIN CASING (NEAREST FOOT) **51**

OTHER CASING (IF USED)

DIAMETER (INCH) _____ DEPTH (FEET) FROM _____ TO _____

SCREEN RECORD

INSERT APPROPRIATE CODE BELOW

STEEL BRASS OR BRONZE OPEN HOLE
 PLASTIC OTHER

SCREEN

DEPTH (NEAREST WHOLE FOOT) FROM _____ TO _____

1 H O **51** FROM 8 TO 11

2 _____ FROM _____ TO _____

3 _____ FROM _____ TO _____

SLOT SIZE 1, _____ 2, _____ 3, _____

DIAMETER OF SCREEN _____ (NEAREST INCH) FROM _____ TO _____

GRAVEL PACK _____

IF WELL DRILLED WAS A FLOWING WELL CIRCLE BOX 68 F

WRA USE ONLY (NOT TO BE FILLED IN BY DRILLER)

TELESCOPE CASING LOG INDICATOR

PUMPING TEST

HOURS PUMPED (TO NEAREST HOUR) **6**

PUMPING RATE (GALLONS PER MINUTE TO NEAREST GALLON) **4**

METHOD USED TO MEASURE PUMPING RATE **Time**

WATER LEVEL: (DISTANCE FROM LAND SURFACE)
 BEFORE PUMPING **30** (NEAREST FOOT)
 WHEN PUMPING **175** (NEAREST FOOT)

TYPE OF PUMPED USED (CIRCLE APPROPRIATE BOX) (FOR PUMPING TEST)
 AIR PISTON TURBINE
 CENTRIFUGAL ROTARY OTHER (DESCRIBE BELOW)
 JET SUBMERSIBLE

PUMP INSTALLED

TYPE OF PUMP (WRITE APPROPRIATE LETTER IN BOX - SEE ABOVE: A, C, J, P, R, S, T, O) 29

DRILLER WILL INSTALL PUMP (CIRCLE APPROPRIATE BOX) YES NO

CAPACITY:
 GALLONS PER MINUTE (TO NEAREST GALLON) _____

PUMP HORSE POWER _____


PUMP COLUMN LENGTH (NEAREST FOOT) _____

CASING HEIGHT (CIRCLE APPROPRIATE BOX AND ENTER CASING HEIGHT)

ABOVE } LAND SURFACE
 BELOW } **2** (NEAREST FOOT)

LOCATION OF WELL ON LOT

SHOW PERMANENT STRUCTURE SUCH AS BUILDINGS, SEPTIC TANKS, AND/OR OTHER LAND MARKS AND INDICATE NOT LESS THAN TWO DISTANCES (MEASUREMENTS TO WELL).

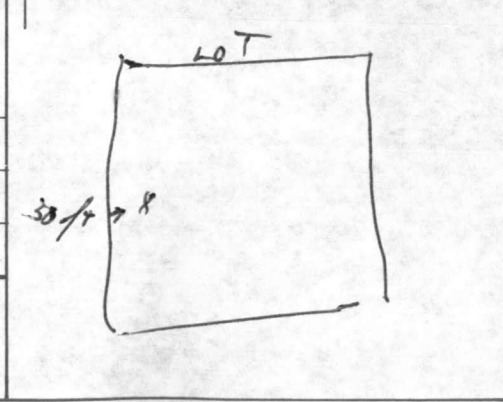

CIRCLE APPROPRIATE BOXES

A WELL WAS ABANDONED AND SEALED WHEN THIS WELL WAS COMPLETED

ELECTRIC LOG OBTAINED

TEST WELL CONVERTED TO PRODUCTION WELL

I HEREBY CERTIFY THAT I HAVE COMPLIED WITH ALL CONDITIONS STATED ON THE ABOVE-CAPTIONED "PERMIT TO DRILL WELL", AND THAT INFORMATION CONTAINED IN THIS REPORT IS TRUE, ACCURATE, AND COMPLETE TO THE BEST OF MY KNOWLEDGE, INFORMATION AND BELIEF.

DRILLERS NAME **Howard Dillon**

(PLEASE PRINT) **Howard Dillon**

SIGNATURE *Howard Dillon*

APPLICATION

A 24782
21208

SEWAGE DISPOSAL TESTING

P _____

STATE OF MARYLAND - DEPARTMENT OF HEALTH AND MENTAL HYGIENE

HOWARD COUNTY HEALTH DEPARTMENT
ENVIRONMENTAL HEALTH SERVICES
P. O. BOX 476, ELLICOTT CITY, MARYLAND 21043
TELEPHONE: 465-5000, EXT. 356

DISTRICT 5

DATE 3/12/75

TO: THE COUNTY HEALTH OFFICER
ELLICOTT CITY, MARYLAND

I, HEREBY, APPLY FOR THE NECESSARY TEST IN ORDER TO CONSTRUCT (OR RECONSTRUCT) A SEWAGE DISPOSAL SYSTEM.

PROPERTY OWNER Walgrow Joint Venture Company

ADDRESS _____ PHONE _____

Any questions call:
Mr. Schneider
465-7777

PROPERTY LOCATION:

SUBDIVISION Walgrow Estates LOT NO. 35

ROAD AND DESCRIPTION Normanshire Circle

SIZE OF LOT approx. 1 mile TYPE BLDG. 3 or 4

IF NOT SINGLE RESIDENCE DESCRIBE _____

NUMBER OF BEDROOMS
(Single Fmly. Dwllg.)

THE SYSTEM INSTALLED UNDER THIS APPLICATION IS ACCEPTABLE ONLY UNTIL PUBLIC FACILITIES BECOME AVAILABLE.

SIGNATURE OF APPLICANT /s/ John Schneider

APPROVED BY _____ FOR _____ DATE _____

(KIND OF SYSTEM)

REJECTED BY _____ FOR _____ DATE _____

(KIND OF SYSTEM)



HOLD PENDING FURTHER TESTS _____ DATE _____

REASONS FOR REJECTION OR HOLDING _____

THIS IS NOT A PERMIT

Tridelpia Rd

LOT 29
35

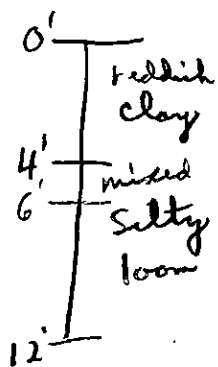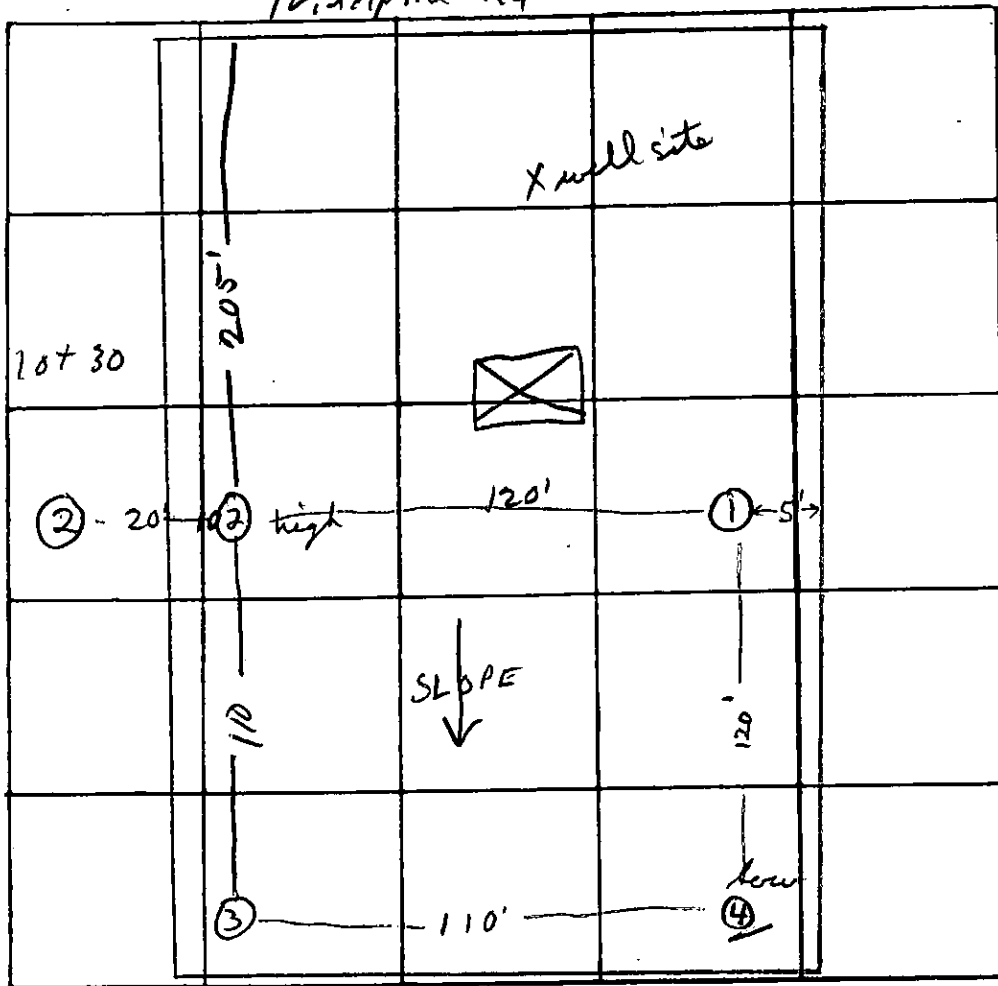

INDICATE NORTH. - NAME ADJOINING ROADWAY AS BASE LINE
NORMANSHIRE CIRCLE

DATE	TEST NO.	DEPTH	PRE-WET		TEST - 1" DROP		TIME	
			START	STOP	START	STOP		
3/21/75	1	12'	Visual; clayey to 5' silty loam below					
	2	5'	1:39	1:41	1:41	1:49	8	
	2A	12 1/2'	1:39	1:41	1:41	1:51	10	
	3	5'	1:31	1:32	1:32	1:53	21	
	3A	12'	1:31	1:35	1:35	1:50	15	
	4	5'	1:50	1:53	1:53	1:59	6	
	4A	12 1/2'	2:23	2:48	Pulled peg 1" loop hook in bottom			
	4B	11 1/2'	3:07	3:15	3:15	3:31	16 min.	

REMARKS

TYPE OF SOIL clayey to ~ 5'; silty & sandy loam below

TESTED BY P. O'N. & F.S. ALSO PRESENT: J. Borteyhorn

B 1 **5034** SEQUENCE NO. (WRA USE ONLY)

1 2 3 (SEQ. NO.) 6
 (THIS NUMBER IS TO BE PUNCHED IN COLS. 3-6 ON ALL CARDS)

STATE OF MARYLAND
WATER RESOURCES ADMINISTRATION
TAWES STATE OFFICE BLDG., ANNAPOLIS, MARYLAND 21401
APPLICATION FOR PERMIT TO DRILL WELL

WRA PERMIT NUMBER
 40-73-242

FILL IN THIS FORM COMPLETELY

DATE RECEIVED (WRA USE ONLY)
 10/16/78

OWNER GRAYSON Floyd
 COL 15 LAST NAME FIRST NAME COL. 34

STREET OR RFD 2000 Century Plaza
 COL 36 COL. 55

POST OFFICE Columbia, Maryland 21044
 COL 57 COL. 76

B 1 **CONTINUED** **DRILLER INFORMATION**

1 2 3 (SEQ. NO.) 6

DATE 9/19/78 **LICENSE NUMBER** 209
 77 80

Howard Dillon
 FIRST NAME DRILLER LAST NAME

SIGNATURE Howard Dillon

B 3 **LOCATION OF WELL**

1 2 3 (SEQ. NO.) 6 HOWARD
 COUNTY 8 (DO NOT ABBREVIATE COUNTY NAME) 21

SUBDIVISION Heritage 23 42

SECTION 44 46 **LOT** 30 48 50

NEAREST TOWN 3 52 71

MILES FROM TOWN (ENTER 0 IF IN TOWN) 3 73 76 77 78

B 2 **WELL INFORMATION**

1 2 3 (SEQ. NO.) 6

MAXIMUM PUMPING RATE (GALLONS PER MINUTE) 5 8 12

AVERAGE DAILY QUANTITY NEEDED (GALLONS PER DAY) 300 14 20

USE FOR WATER (CIRCLE APPROPRIATE BOX)

D HOME (SINGLE OR DOUBLE HOUSEHOLD UNIT ONLY)

F FARMING, AGRICULTURE, IRRIGATION

I INDUSTRIAL, COMMERCIAL, STATE AND FEDERAL GOVERNMENT.

M MUNICIPAL WATER SUPPLY } MUST HAVE STATE HEALTH DEPT. APPROVAL

P PRIVATE WATER COMPANY }

T TEST 9E11

B 4 **DIRECTION FROM TOWN (CIRCLE APPROPRIATE BOX)**

1 2 3 (SEQ. NO.) 6

N NORTH **E** EAST **NE** NORTHEAST **SE** SOUTHEAST

S SOUTH **W** WEST **NW** NORTHWEST **SW** SOUTHWEST

NEAR WHAT ROAD Day Farm Road

ON WHICH SIDE OF ROAD (CIRCLE APPROPRIATE BOX) **N** **S** **E** **W** 11 30

DISTANCE FROM ROAD (ENTER DISTANCE AND CIRCLE APPROPRIATE BOX) 100 34 37 38 39

APPROXIMATE DEPTH OF WELL 200 FEET
 24 28

APPROXIMATE DIAMETER OF WELL 6 (NEAREST INCH)

METHOD OF DRILLING USED (CIRCLE APPROPRIATE METHOD)

BORED (OR AUGERED) **JETTED** **DRIVEN**

30-37 **AIR-ROTARY** **AIR-PERCUSSION** **ROTARY** (HYDRAULIC ROTARY)

CABLE **REVERSE-ROTARY** **DRIVE-POINT**

OTHER (DESCRIBE)

REPLACEMENT OR DEEPEINED WELLS (CIRCLE APPROPRIATE BOX)

N THIS WELL WILL NOT REPLACE AN EXISTING WELL

Y THIS WELL WILL REPLACE A WELL THAT WILL BE ABANDONED AND SEALED

S THIS WELL WILL REPLACE A WELL THAT WILL BE USED AS A STANDBY

D THIS WELL WILL DEEPEIN AN EXISTING WELL PERMIT NUMBER OF WELL TO BE REPLACED OR DEEPEINED (IF AVAILABLE)

NOT TO BE FILLED IN BY DRILLER (WRA USE ONLY)

APPROPRIATION PERMIT NUMBER 54 63 65

ENGINEER REVIEW DISTRICT NO. W28900

FORCE 67 68 **WRITE INITIALS IN BOX**

CONDITIONS 70 71 72 73 74 75 76 77 78 79

B 4 **CONTINUED** **HEALTH DEPARTMENT APPROVAL**

1 2 3 (SEQ. NO.) 6 Howard W28900
 41 **S** STATE HEALTH (CIRCLE BOX) COUNTY NAME COUNTY NO.

MO. DAY YR. 9 21 78

DATE 43 48 **APPROVED BY** Donald W. Monaghan, Sanitarian

DRAW A SKETCH BELOW SHOWING LOCATION OF WELL IN RELATION TO NEARBY TOWNS, ROADS AND STREAMS WITH NORTH IN THE DIRECTION OF THE ARROW, AND GIVE DISTANCE FROM WELL TO NEAREST ROAD JUNCTION OR STREAM CROSSING SHOWN ON THE SKETCH. ALSO SHOW, BY MEANS OF AN "X", THE WELL LOCATION IN THE BOX BELOW AND THE BOX NUMBER FROM THE WELL LOCATION MAP.

N ↑

57' CASING

51' open hole (solid bottom)

1' above grade

17 bags cement

location OK

(GLK) 18 Oct. 78

DAY FARM RD

SHARP

MD RT. # 32

BOX NUMBER 790 520

NORTH COORDINATE 50 51 52 53 54 55

EAST COORDINATE 57 58 59 60 61 62 63

ELEVATION AT WELL HEAD (FEET) 0/0 5/0

B 5 **SPECIAL CONDITIONS 8-63 (WRA USE ONLY)**

1 2 3 (SEQ. NO.) 6

DE. MARYL
CH BEND
-LAND OF
LRED
AIA
A. MARYL
URE PLA
SON JD
DER - O
ON
1330'
29.30
SEC
FOR
CO
SITE

EXISTING MAC.

ROAD

9,750

105

135.00'

DRAINAGE

LOT 30

10/1/78
01/1
M


PROP. WELL LOC.
EL. 189.0

RECOMMENDED
(10/2/78)

PROP. WEL
EL. 177.6

S 13° 57' 18" E
309.21'

S 13° 57' 18" E
307.74'

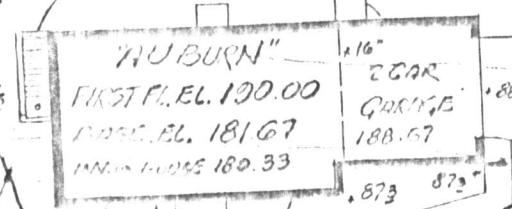

ED. IN TIME OF FLD.
TEST 183.5

TRENCH 55 C.F.

TRENCH 55 C.F.

P.D. 50.0
15 L.F.


ACK DEVIS
LIZATION
E ENIT
V. DCH
S/AC
MERE
I QUI
SE BOLL
E. P

152'


TRIADELPHIA ROAD

LOCATION OF HOUSE
14218 DAY FARM ROAD
LOT 30

THE HERITAGE
SECTION 1 AREA 2
5TH ELECTION DISTRICT
HOWARD COUNTY, MARYLAND

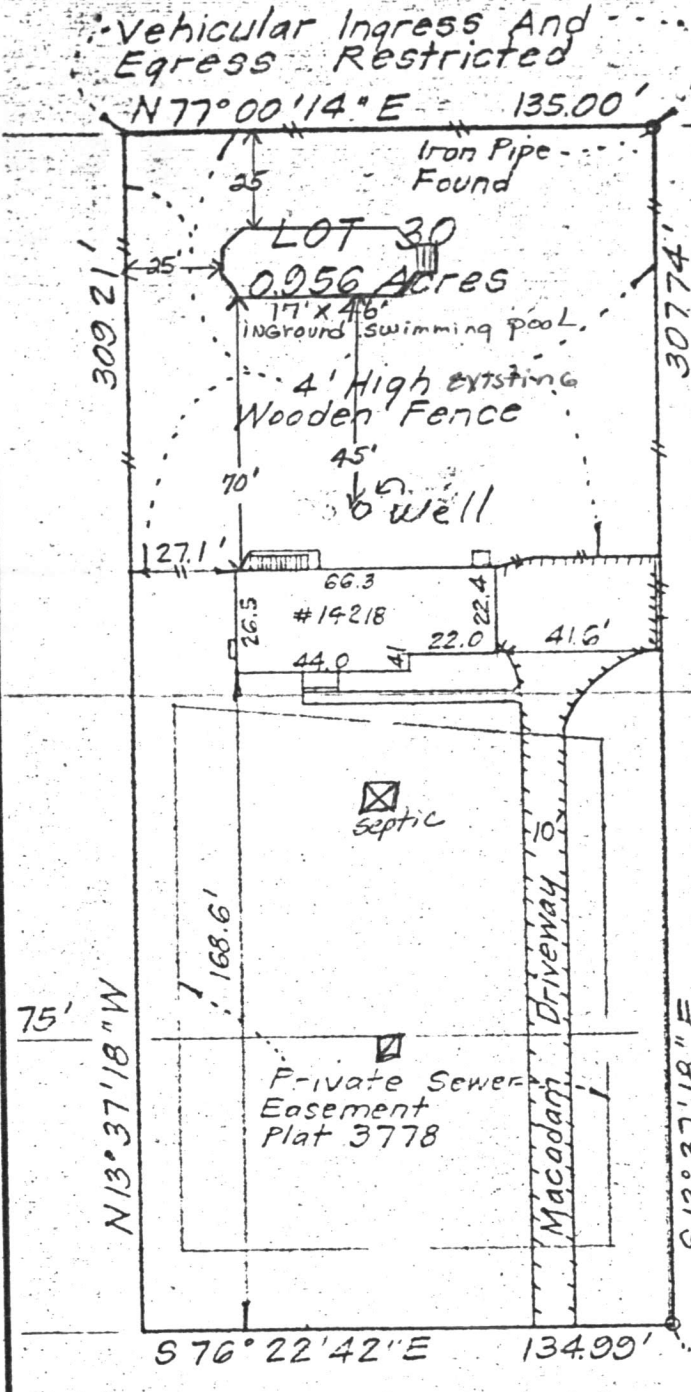

No Impact on well or septic OK to proceed 8/24/82

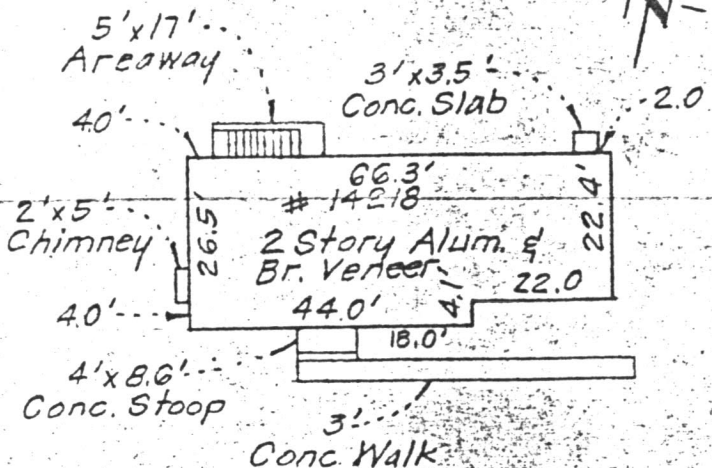

BRL Scale
1" = 30'

310.13' to Corner @ Pioneer Circle

Final: 3-25-82

DAY FARM ROAD
50' R/W

SURVEYOR'S CERTIFICATE

I hereby certify that the position of all existing improvements on the above described property have been carefully established by a transit-tape survey and that unless otherwise shown there are no encroachments.

Donald R. Sackett
No. 6059

CLARK • FINEFROCK & SACKETT

ENGINEERS • PLANNERS • SURVEYORS
11315 LOCKWOOD DRIVE SILVER SPRING, MD. 20904
TEL. NO 593-3400

REFERENCE	DRAWN BY VLB	CHECKED BY KWC
Plat 3778	DATE 3-26-82	FILE NO.
	SCALE 1" = 50'	8525-H

BRUNING 40-22 36166