

12/27/71

opp
12-27-71
JLL

PERMIT

P 16132

SEWAGE DISPOSAL SYSTEM

A 16044

MARYLAND STATE DEPARTMENT OF HEALTH

HOWARD COUNTY

ELLICOTT CITY

INDEXED

DISTRICT 4

DATE 7/21/71

Roger Nicklas IS PERMITTED TO INSTALL ALTER

ADDRESS Buckeystown, Maryland PHONE 874-5161

A SEWAGE DISPOSAL SYSTEM LOCATED AT _____

SUBDIVISION _____ ROAD ²⁰⁴⁵ Duyall Rd. LOT 6
(see application for better directions)

PROPERTY OWNER Carl Reed
Garmen LaPenna

ADDRESS _____

SPECIFICATIONS - 3 bedrooms

DRAIN FIELD _____ DEPTH _____ FEET. BOTTOM AREA _____ SQ. FT.

SEEPAGE PITS _____ ABSORBENT SIDE-WALL AREA _____ SQ. FT.

SEPTIC TANK CAPACITY 1,000 GALLONS

FOR GARBAGE GRINDER, INCREASE DISPOSAL AREA 22% & TANK CAPACITY 50%.

OTHER Dry well to be 330 sq. ft. of absorbent sidewall area below the inlet pipe. Inlet pipe to begin 4 1/2 ft. below original grade. Max. depth of dry well to be 13 ft. below original grade. Locate dry well 288 ft. from rear lot line and 120 ft. from right side line as lot is seen standing on Duyall Rd., facing lot.

NOTE: ALL PIPE FROM HOUSE TO SEPTIC SYSTEM MUST BE CAST IRON.
PERMIT VOID AFTER THREE YEARS.


PLANS APPROVED BY James T. Wright DATE 6/29/71

FILL SEPTIC TANK AND DISTRIBUTION BOX WITH WATER BEFORE CALLING FOR AN INSPECTION. COVER NO WORK UNTIL INSPECTED AND APPROVED.

NEITHER THE HOWARD COUNTY COMMISSIONERS NOR THE HEALTH DEPARTMENT IS RESPONSIBLE FOR THE SUCCESSFUL OPERATION OF ANY SYSTEM.

BODG. PERMIT SIGNED
AND RETURNED 6/28/71
Serial # 33674
3 Cw Garage

A 16044

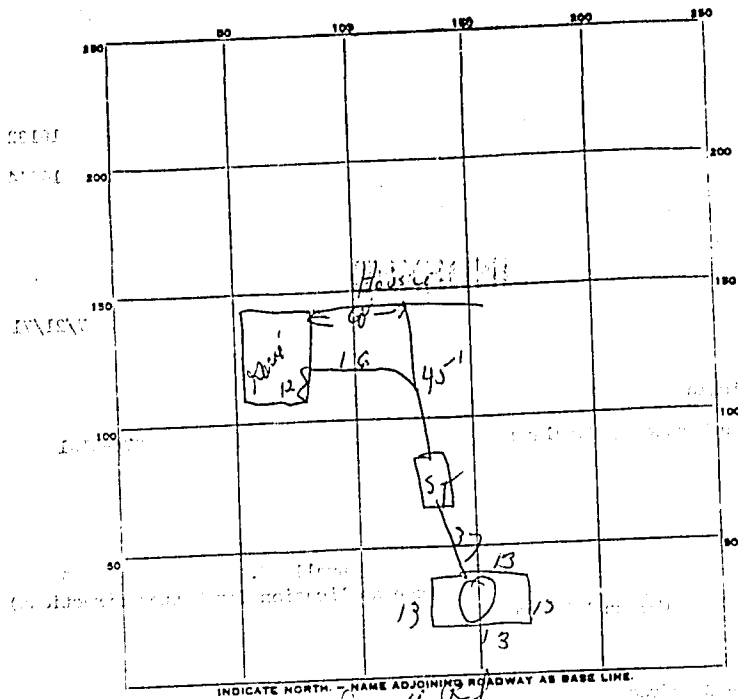

PERMIT CARD OK

SEPTIC TANK, LEVEL OK

CLEANOUTS OK

DISTRIBUTION BOX, LEVEL _____

TILE FIELD, DEPTH _____ FT. TRENCH WIDTH _____ FT.

GRAVEL DEPTH _____ IN. TOTAL LENGTH _____ FT.

NUMBER OF TRENCHES _____ TOTAL BOTTOM AREA _____

SEEPAGE PITS, INSIDE DIAMETER 5.2 FT. DEPTH BELOW INLET 9 FT.


ADSORBENT AREA 468 SQ. FT.

REMARKS _____

DATE SYSTEM APPROVED 12/27/71 INSPECTOR DW Murray

JUL 18 '90 09:35 RUSHERMAN CONST. CO.
 HOUSE LOCATION
 REED PROPERTY
 LIBER 741 FOLIO 985 AND LIBER 731 FOLIO 104
 FOURTH ELECTION DISTRICT
 HOWARD COUNTY, MARYLAND

A16044

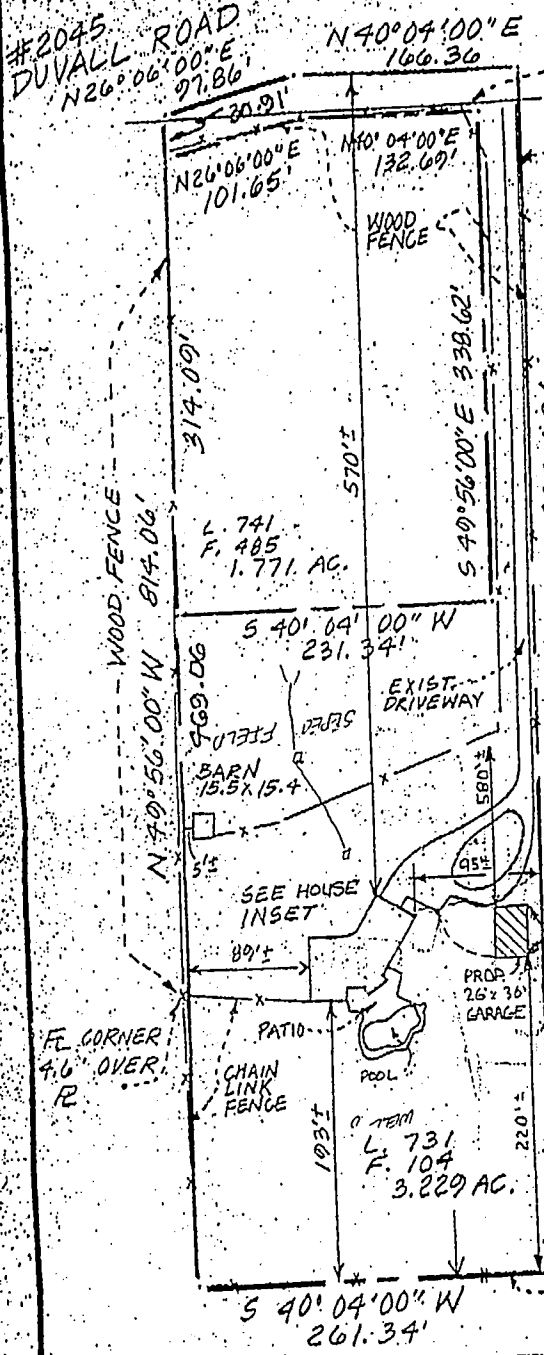

OVERHEAD UTILITIES
 END OF FE 1.2' OVER R



INSET
 SCALE: 1"=30'
 6/20/90
 PLANS OK
 RH

PLOT PLAN
 PROPOSED
 DETACHED GARAGE
 SCALE 1"=10'