

ci 8780
SEQUENCE NO. 18780
1 2 3 (SEQ. NO.) 6
(THIS NUMBER IS TO BE PUNCHED IN COLS. 3-6 ON ALL CARDS)

STATE OF MARYLAND
DEPARTMENT OF WATER RESOURCES
STATE OFFICE BLDG., ANNAPOLIS, MARYLAND 21401
WELL COMPLETION REPORT

THIS REPORT MUST BE SUBMITTED WITHIN 30 DAYS AFTER WELL COMPLETION

FILL IN THIS FORM COMPLETELY

AL6044

PERMIT NO. FROM "PERMIT TO DRILL WELL"

20-22-7793
20 29 30 31 32 33 34 35 36 37

DATE RECEIVED (DWR USE ONLY)

NOV 5 1971
DATE WELL COMPLETED 22 (TO NEAREST FOOT) 26

DRILLERS IDENTIFICATION NO. 139

OWNER

LADENNA
LAST NAME

CARMEN
FIRST NAME

ROCKVILLE MD
POST OFFICE

STREET OR RFD

15016 WESTBORG RD

WELL DESCRIPTION

WELL LOG

STATE THE KIND OF FORMATIONS PENETRATED, THEIR COLOR, DEPTH, THICKNESS AND IF WATER BEARING

DESCRIPTION (USE ADDITIONAL SHEETS IF NECESSARY)

FEET

FROM TO

CHECK IF WATER BEARING

SOFT BROWN SHALE
GREEN SLATE

0 95
95 170 ✓

GROUTING RECORD

WELL HAS BEEN GROUTED (CIRCLE APPROPRIATE BOX) YES NO
TYPE OF GROUTING MATERIAL (CIRCLE BOX) CEMENT BENTONITE CLAY
NO. OF BAGS 26 NO. OF POUNDS 2516
GALLONS OF WATER 156
DEPTH OF GROUT SEAL (TO NEAREST FOOT) FROM 0 FT. TO 100 FT.

CASING RECORD

MAIN CASING TYPE ST 6 NOMINAL DIAMETER TOP (MAIN) CASING (NEAREST INCH) 6 TOTAL DEPTH OF MAIN CASING (NEAREST FOOT) 101.4
OTHER CASING (IF USED) DIAMETER (INCH) DEPTH (FEET) FROM TO

SCREEN RECORD

SCREEN TYPE OR OPEN HOLE ST BR HD PL OT
STEEL BRASS OR BRONZE OPEN HOLE PLASTIC OTHER
C 2
1 2 3 (SEQ. NO.) 6
DEPTH (NEAREST WHOLE FOOT) FROM 110 TO 170

PUMPING TEST

HOURS PUMPED (TO NEAREST HOUR) 1
PUMPING RATE (GALLONS PER MINUTE TO NEAREST GALLON) 12
METHOD USED TO MEASURE PUMPING RATE TIME
WATER LEVEL: (DISTANCE FROM LAND SURFACE) BEFORE PUMPING 62 (NEAREST FOOT) WHEN PUMPING 170 (NEAREST FOOT)
TYPE OF PUMP USED (CIRCLE APPROPRIATE BOX) AIR PISTON TURBINE CENTRIFUGAL ROTARY OTHER (DESCRIBE BELOW) JET SUBMERSIBLE

PUMP INSTALLED


TYPE OF PUMP (WRITE APPROPRIATE LETTER IN BOX - SEE ABOVE: A, C, J, P, R, S, T, O)
DRILLER WILL INSTALL PUMP (CIRCLE APPROPRIATE BOX) YES NO
CAPACITY: GALLONS PER MINUTE (TO NEAREST GALLON) 31 35
PUMP HORSE POWER 37 41
PUMP COLUMN LENGTH (NEAREST FOOT) 43 47

CASING HEIGHT

ABOVE LAND SURFACE 1 (NEAREST FOOT)
BELOW 49 51

LOCATION OF WELL ON LOT

SHOW PERMANENT STRUCTURE SUCH AS BUILDINGS, SEPTIC TANKS, AND/OR OTHER LAND MARKS AND INDICATE NOT LESS THAN TWO DISTANCES (MEASUREMENTS TO WELL).

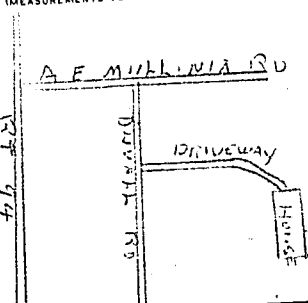

CIRCLE APPROPRIATE BOXES

- A WELL WAS ABANDONED AND SEALED WHEN THIS WELL WAS COMPLETED
- E ELECTRIC LOG OBTAINED
- C COPY OF ELECTRIC LOG ATTACHED

I HEREBY CERTIFY THAT I HAVE COMPLIED WITH ALL CONDITIONS STATED ON THE ABOVE-CAPTIONED "PERMIT TO DRILL WELL", AND THAT INFORMATION CONTAINED IN THIS REPORT IS TRUE, ACCURATE, AND COMPLETE TO THE BEST OF MY KNOWLEDGE, INFORMATION AND BELIEF.

DRILLERS NAME

ROBERT CLINE

Robert Cline

DIAMETER OF SCREEN 56 60 (NEAREST INCH) FROM TO

GRAVEL PACK

IF WELL DRILLED WAS A FLOWING WELL CIRCLE BOX F

DWR USE ONLY (NOT TO BE FILLED IN BY DRILLER) (E.R.O.S.) W Q

TELESCOPE CASING LOG INDICATOR OTHER DATA AVAILABLE