

APPLICATION

SEWAGE DISPOSAL TESTING

MARYLAND STATE DEPARTMENT OF HEALTH

HOWARD COUNTY

ELLICOTT CITY

DISTRICT 4th

DATE 7-1-69

A 14621
P _____

TO: THE COUNTY HEALTH OFFICER
ELLICOTT CITY, MARYLAND

I, HEREBY, APPLY FOR THE NECESSARY TESTS IN ORDER TO CONSTRUCT (OR RECONSTRUCT) A SEWAGE DISPOSAL SYSTEM.

PROPERTY OWNER Bernard D. Warfield

ADDRESS A. E. Mullinix Rd., Woodbine, Ho. Co., Md. PHONE 489-4764

PROPERTY LOCATION:

SUBDIVISION _____ LOT NO. _____

ROAD AND DESCRIPTION South on Duvall Rd. from A. E. Mullinix Rd. approx. 1/2 mile. Lot is on west (right) side of Duvall Rd., and marked with concrete markers (4"), approx. 8 - 10 foot from edge of roadway.

OCCUPANT _____ PHONE _____

PERSON TO CONSTRUCT SYSTEM _____

ADDRESS _____ PHONE _____

SIZE OF LOT 52,000 sq. ft. TYPE BLDG. 3 bedroom ranch home
175 foot frontage, 300 ft. depth 2 1/2 baths
NUMBER OF BEDROOMS

IF NOT SINGLE RESIDENCE DESCRIBE _____

SIGNATURE OF APPLICANT (Purchaser) G. Edward Vessel G. Edward Vessel 489-4482
Rt. 3, Mt. Airy Ho Co., Md.

APPROVED BY W. Monaghan FOR G. W. Vessel DATE 7-1-69
(KIND OF SYSTEM)


REJECTED BY _____ FOR _____ DATE _____
(KIND OF SYSTEM)

HOLD PENDING FURTHER TESTS _____ DATE _____

REASONS FOR REJECTION OR HOLDING _____

THIS IS NOT A PERMIT

Father to daughter

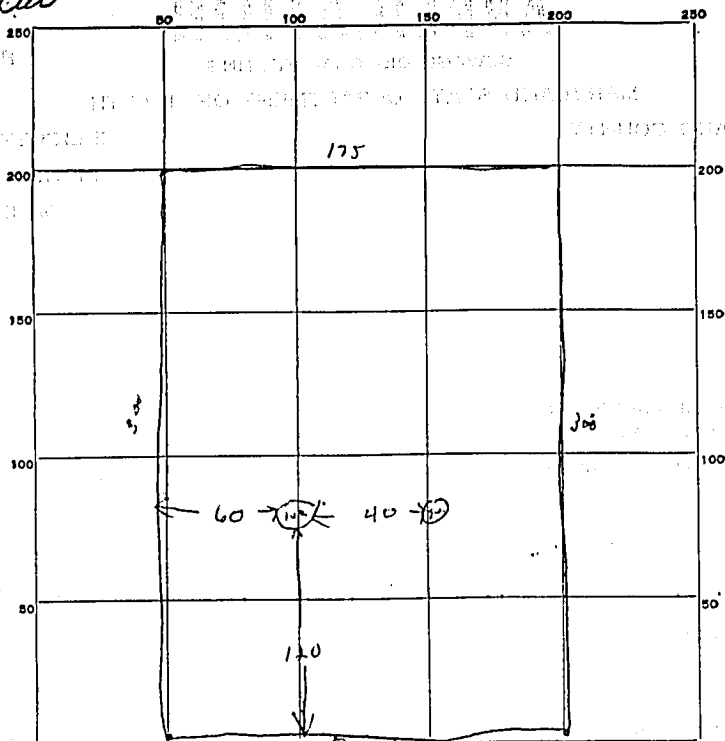

INDICATE NORTH. - NAME ADJOINING ROADWAY AS BASE LINE.

Divall Rd

DATE	TEST NO.	DEPTH	PRE-WET		TEST - 1" DROP		TIME
			START	STOP	START	STOP	
7/18/02	1	10p	9 ⁵⁰	9 ⁵²	9 ⁵¹	10 ⁰⁵	13 min
	2	7 1/2	9 ⁵⁰	stop test - slow perc			
	3	10ft	9 ⁵²	9 ⁵⁷	9 ⁵⁷	10 ⁰⁸	14 min
	4	4 1/2	9 ⁵³	stop test - slow perc.			

SOIL AUGER FINDING *fine sp. clay.*

TESTED BY *DUM*

REMARKS *no more of hammer sink*