

10/15/76
after 11:00 A.M.

PERMIT

P 24294

A _____

SEWAGE DISPOSAL SYSTEM

MARYLAND STATE DEPARTMENT OF HEALTH

HOWARD COUNTY

02-206773

ELLICOTT CITY

INDEXED

DISTRICT 2

DATE 10/13/76

Jenkins Brothers IS PERMITTED TO INSTALL ALTER X

ADDRESS Wallas Park, Ellicott City, Md. PHONE 465-6646

A SEWAGE DISPOSAL SYSTEM LOCATED AT _____

SUBDIVISION _____ ROAD 9194 Old Frederick LOT _____

PROPERTY OWNER Charles Ekloff corner of Old Frederick Road and Mt. Hebron Drive

ADDRESS 9194 Old Frederick Road, Ellicott City, Md.

SPECIFICATIONS

DRAIN FIELD _____ DEPTH _____ FEET, BOTTOM AREA _____ SQ. FT.

SEEPAGE PITS _____ ABSORBENT SIDE-WALL AREA _____ SQ. FT.

SEPTIC TANK CAPACITY _____ GALLONS

FOR GARBAGE GRINDER, INCREASE DISPOSAL AREA 22% & TANK CAPACITY 50%.

OTHER CALL FOR INSPECTION WHEN GROUND IS OPENED UP SO SANITARIAN CAN RECOMMEND


REPAIR SYSTEM. trench 60ft long, 12' deep with 6ft of gravel under distribution pipe. F.S.

PLANS APPROVED BY Palmer F. Wine DATE 10/13/76

FILL SEPTIC TANK AND DISTRIBUTION BOX WITH WATER BEFORE CALLING FOR AN INSPECTION. COVER NO WORK UNTIL INSPECTED AND APPROVED.

NEITHER THE HOWARD COUNTY COMMISSIONERS NOR THE HEALTH DEPARTMENT IS RESPONSIBLE FOR THE SUCCESSFUL OPERATION OF ANY SYSTEM.

24294

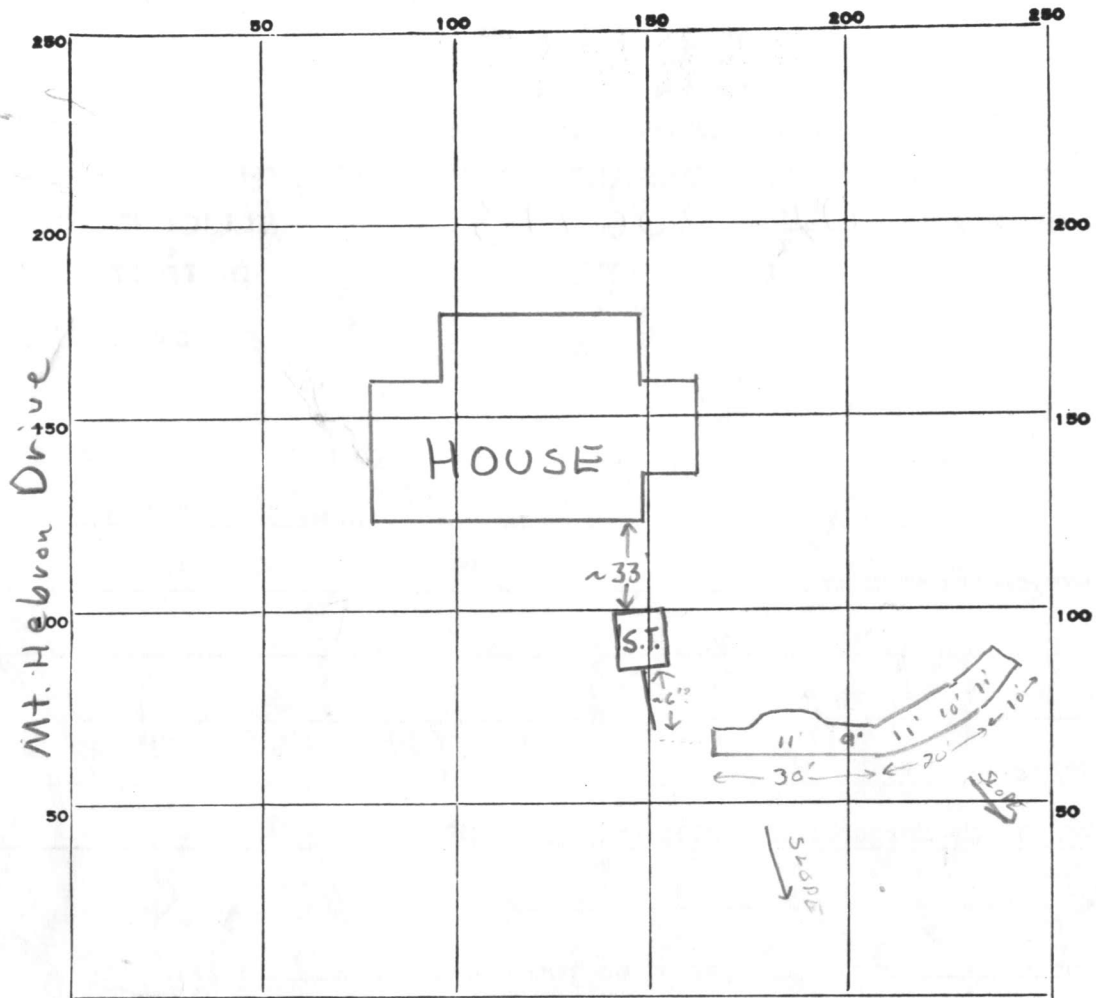

INDICATE NORTH. - NAME ADJOINING ROADWAY AS BASE LINE.

Rte. 99

10
4
78
6
468

PERMIT CARD √ S.W.S.C. F.S. 10/14/76

SEPTIC TANK, LEVEL existing CLEANOUTS existing S.T. | trench
o.k. | n.a.

DISTRIBUTION BOX, LEVEL n.a.

TILE FIELD, DEPTH 9-11 FT. TRENCH WIDTH 2-6 FT.

GRAVEL DEPTH ~ 6 IN. TOTAL LENGTH 78 FT.

NUMBER OF TRENCHES 1 1/2 SIDEWALL TOTAL BOTTOM AREA 468

SEEPAGE PITS, INSIDE DIAMETER - FT. DEPTH BELOW INLET - FT.

ABSORBENT AREA - SQ. FT.

REMARKS 10/14/76 Trench partially dug, but keeps coming in, gave o.k. to
gravel as trench is dug F.S. 10/15/76 - stop work
order - trench requires more stone to
cover new pipe to prevent collapse
10/18/76 - system appears ok

DATE SYSTEM APPROVED 10/18/76 INSPECTOR h.w. Benson

Repair perc
10/14/76
9:30 A.M.
1st

APPLICATION

A _____

P _____

SEWAGE DISPOSAL TESTING

STATE OF MARYLAND - DEPARTMENT OF HEALTH AND MENTAL HYGIENE

HOWARD COUNTY HEALTH DEPARTMENT
ENVIRONMENTAL HEALTH SERVICES
P. O. BOX 476, ELLICOTT CITY, MARYLAND 21043
TELEPHONE: 465-5000, EXT. 356

DISTRICT 2nd

DATE 10/11/76

Final OK
10/15/76
wb

TO: THE COUNTY HEALTH OFFICER
ELLICOTT CITY, MARYLAND

I, HEREBY, APPLY FOR THE NECESSARY TEST IN ORDER TO CONSTRUCT (OR RECONSTRUCT) A SEWAGE DISPOSAL SYSTEM.

PROPERTY OWNER Charles Ekloff

ADDRESS 9194 Old Frederick Road, Ellicott City, Md. PHONE _____

PROPERTY LOCATION:

SUBDIVISION _____ LOT NO. _____

ROAD AND DESCRIPTION 9194 Old Frederick Road - corner of Old Frederick Road and ~~RXXXX~~
Mt. Hebron Drive

SIZE OF LOT ? TYPE BLDG. ?
NUMBER OF BEDROOMS _____

IF NOT SINGLE RESIDENCE DESCRIBE _____

THE SYSTEM INSTALLED UNDER THIS APPLICATION IS ACCEPTABLE ONLY UNTIL PUBLIC FACILITIES BECOME AVAILABLE.

SIGNATURE OF APPLICANT /s/ Jenkins Brothers


APPROVED BY _____ FOR _____ DATE _____
(KIND OF SYSTEM)

REJECTED BY _____ FOR _____ DATE _____
(KIND OF SYSTEM)

HOLD PENDING FURTHER TESTS _____ DATE _____

REASONS FOR REJECTION OR HOLDING _____

THIS IS NOT A PERMIT

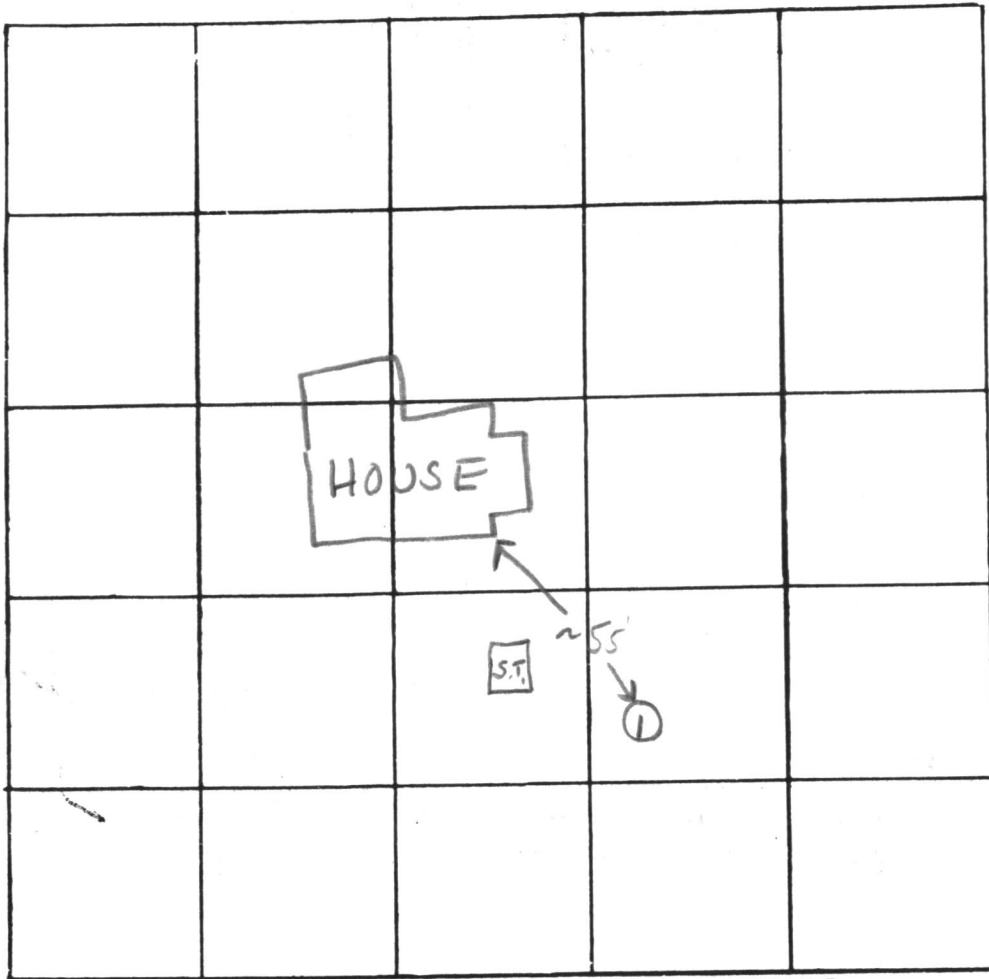

INDICATE NORTH. - NAME ADJOINING ROADWAY AS BASE LINE.

Rte 99

DATE	TEST NO.	DEPTH	PRE-WET		TEST - 1" DROP		TIME
			START	STOP	START	STOP	
10/14/76	1	12'	Topsoil & clay		to 5' 1/2'; sandy loam below		

REMARKS _____

TYPE OF SOIL clayey to ~5'; sandy loam below

TESTED BY F.S. ALSO PRESENT: Jenkins