

C1 6636 SEQUENCE NO. (DENY USE ONLY)

STATE OF MARYLAND WELL COMPLETION REPORT

THIS REPORT MUST BE SUBMITTED WITHIN 45 DAYS AFTER WELL IS COMPLETED.

(THIS NUMBER IS TO BE PUNCHED IN COLS. 3-6 ON ALL CARDS)

COUNTY NUMBER P24296

DATE Received DATE WELL COMPLETED

INDEXED 22 26 Depth of Well (TO NEAREST FOOT)

PERMIT NO. FROM "PERMIT TO DRILL WELL" W0-88-0297

OWNER QUAA, DOROTHY (CONWAY - NEW OWNER) STREET OR RFD 11220 ALBETH ROAD TOWN MARIOTTVILLE SUBDIVISION REPLACEMENT WELL SECTION LOT

WELL LOG table with columns: DESCRIPTION (Use additional sheets if needed), FEET (FROM, TO), Check if water bearing. Includes entries for SANDSTONE and GRAY MICHA. ROCK.

GROUTING RECORD: WELL HAS BEEN GROUTED (Y), TYPE OF GROUTING MATERIAL CEMENT (CM), BENTONITE CLAY (BC), NO. OF BAGS 15, NO. OF POUNDS 1410.

CASING RECORD: MAIN CASING TYPE ST (STEEL), Nominal diameter 6 inch, Total depth 94 feet.

OTHER CASING (if used) table with columns for diameter and depth.

SCREEN RECORD: screen type or open hole insert appropriate code below. Options: ST (STEEL), BR (BRASS), HO (OPEN HOLE), PL (PLASTIC), OT (OTHER).

DEPTH (nearest ft.) table with columns for casing depth and screen depth. Includes slot size and diameter of screen.

PUMPING TEST: HOURS PUMPED 3, PUMPING RATE 7 gal. per min., METHOD USED TO MEASURE PUMPING RATE air, WATER LEVEL 53, WHEN PUMPING 230, TYPE OF PUMP USED air.

PUMP INSTALLED: DRILLER WILL INSTALL PUMP YES, TYPE OF PUMP INSTALLED, CAPACITY, PUMP HORSE POWER, PUMP COLUMN LENGTH, CASING HEIGHT.

CIRCLE APPROPRIATE LETTER: A WELL WAS ABANDONED AND SEALED WHEN THIS WELL WAS COMPLETED.

I HEREBY CERTIFY THAT THIS WELL HAS BEEN CONSTRUCTED IN ACCORDANCE WITH COMAR 10.17.13 "WELL CONSTRUCTION" AND IN CONFORMANCE WITH ALL CONDITIONS STATED IN THE ABOVE CAPTIONED PERMIT...


DRILLERS IDENT. NO. 237

DRILLERS SIGNATURE (MUST MATCH SIGNATURE ON APPLICATION)

SITE SUPERVISOR (sign. of driller or journeyman responsible for sitework if different from permittee)

GRAVEL PACK, IF WELL DRILLED WAS FLOWING WELL INSERT F IN BOX 68

OEP USE ONLY (NOT TO BE FILLED IN BY DRILLER): T (E.R.O.S.), WQ, TELESCOPE CASING, LOG INDICATOR, OTHER DATA.

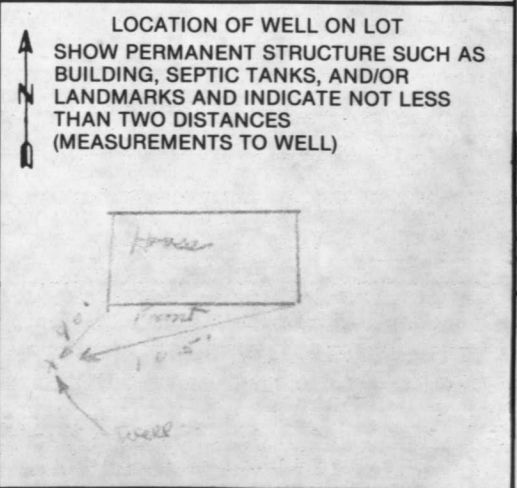

P24296
WELL ABANDONMENT REPORT ~~A23856~~

Date 2/24/89

Permit Number of abandoned well (if any)

		-			-		
--	--	---	--	--	---	--	--

Driller's Name MAYNE L. Joseph
Last First

Owner's Name DUDA DOROTHY
Last First

Well Location:

County HOWARD
Subdivision 11220 Albeth Rd
Section _____ Lot _____
Nearest Town Mariottsville
Maryland Grid Location _____

Box Number E 820
N 530

	0/5	X
	0/0	

Show well location by (x) within box

Type of Well

- Drilled
- Jetted
- Bored or Augered
- Other, specify _____

Depth of Well 75 Feet

Type of Casing

- Steel
- Plastic
- Concrete
- Other, specify _____

Size of Casing 5/8 Inches

Was any case removed Yes No
if yes amount removed _____ (feet)

Was casing ripped or perforated Yes No

Log of Sealing Material

Material	Feet	
	From	To
Cement + GRAVEL	0	75

LIC. 238

Joseph L. Mayne