

~~11/1/76~~
~~Howard 11-10-76~~
11/10/76

06-432-832

PERMIT

P 24441

SEWAGE DISPOSAL SYSTEM

A

MARYLAND STATE DEPARTMENT OF HEALTH

HOWARD COUNTY

ELLICOTT CITY

Approved
INDEXED
11-10-76

DISTRICT 6th

DATE 11/3/76

Jenkins Brothers

IS PERMITTED TO INSTALL ALTER X

ADDRESS Frederick Road, Wallas Park, Ellicott City, Md. PHONE 465-6646

A SEWAGE DISPOSAL SYSTEM LOCATED AT

SUBDIVISION ROAD 8220 Mission Road LOT

PROPERTY OWNER Mr. J. Userery

ADDRESS 8220 Mission Road, Jessup, Md.

SPECIFICATIONS 3 bedrooms

DRAIN FIELD DEPTH FEET, BOTTOM AREA SQ. FT.

SEEPAGE PITS ABSORBENT SIDE-WALL AREA SQ. FT.

SEPTIC TANK CAPACITY 1000 GALLONS

FOR GARBAGE GRINDER, INCREASE DISPOSAL AREA 22% & TANK CAPACITY 50%.


OTHER

PLANS APPROVED BY Palmer F. Wine DATE 11/3/76

FILL SEPTIC TANK AND DISTRIBUTION BOX WITH WATER BEFORE CALLING FOR AN INSPECTION. COVER NO WORK UNTIL INSPECTED AND APPROVED.

NEITHER THE HOWARD COUNTY COMMISSIONERS NOR THE HEALTH DEPARTMENT IS RESPONSIBLE FOR THE SUCCESSFUL OPERATION OF ANY SYSTEM.

24441

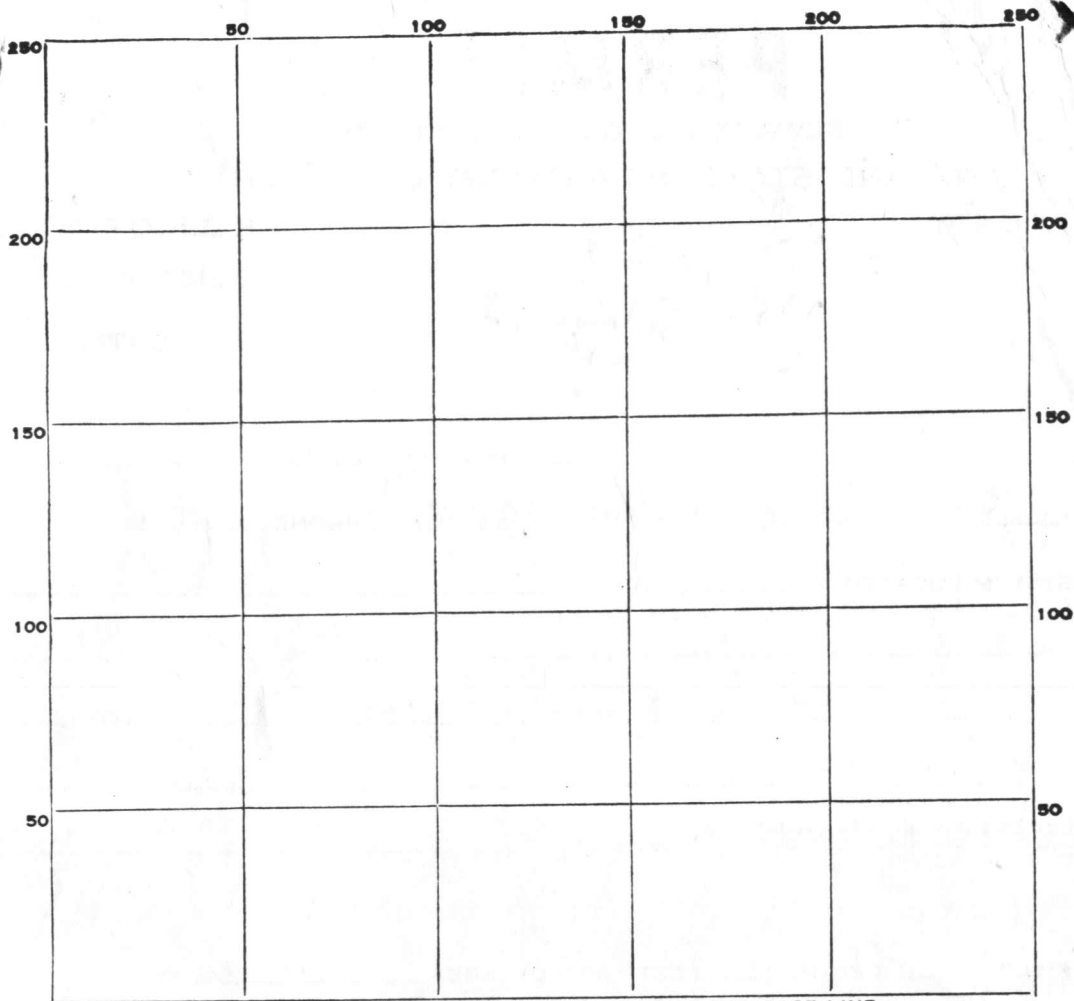

INDICATE NORTH. - NAME ADJOINING ROADWAY AS BASE LINE.

PERMIT CARD _____

SEPTIC TANK, LEVEL 1000 gal ✓

CLEANOUTS 3 ✓

DISTRIBUTION BOX, LEVEL _____

TILE FIELD, DEPTH _____ FT. TRENCH WIDTH _____ FT.

GRAVEL DEPTH _____ IN. TOTAL LENGTH _____ FT.

NUMBER OF TRENCHES _____ TOTAL BOTTOM AREA _____

SEEPAGE PITS, INSIDE DIAMETER _____ FT. DEPTH BELOW INLET _____ FT.

ABSORBENT AREA _____ SQ. FT.

REMARKS New 1000 gal Septic tank installed

DATE SYSTEM APPROVED 11-10-76

INSPECTOR hal benson