

APPLICATION

SEWAGE DISPOSAL TESTING

A 05225

F _____

MARYLAND STATE DEPARTMENT OF HEALTH

HOWARD COUNTY

ELLCOTT CITY

DISTRICT 4

DATE 5/28/62

Septic Tank 750 gal.
Dry Well - 3000 gal absorbent sidewall area to begin below the inlet pipe. The ~~first~~ first four ft of original grade not to be included in sidewall area.

Place Dry Well about 40 to 60 ft. from the front of proposed house off the right corner of house (as you face from Duwall Rd.)

TO: THE COUNTY HEALTH OFFICER
ELLCOTT CITY, MARYLAND

I, HEREBY, APPLY FOR THE NECESSARY TESTS IN ORDER TO CONSTRUCT (OR RECONSTRUCT) A SEWAGE DISPOSAL SYSTEM.

PROPERTY OWNER

Arthur Goode

ADDRESS 179 Main St. E. C. PHONE HO5-1718

PROPERTY LOCATION:

SUBDIVISION _____

LOT NO. _____

ROAD AND DESCRIPTION

Duwall Rd - approx. 1 mile from RT 94 to G. E. Mullineaux Rd. to fork of road - go to right. sign in the yard - "Camp Goode" Buried down on property

PERSON TO CONSTRUCT SYSTEM _____

ADDRESS _____

PHONE _____

SIZE OF LOT

7 acres

TYPE BLDG.

2

NUMBER OF BEDROOMS

IF NOT SINGLE RESIDENCE DESCRIBE _____

SIGNATURE OF APPLICANT

Mrs Arthur L Goode

APPROVED BY

Donald W. Monaghan

FOR

Dry Well

DATE

6-12-62

REJECTED BY _____

FOR _____

(KIND OF SYSTEM)

DATE _____

HOLD PENDING FURTHER TESTS

D. W. Monaghan

DATE


6-5-62

REASONS FOR REJECTION OR HOLDING

little pipe

J. M. MUE

THIS IS NOT A PERMIT

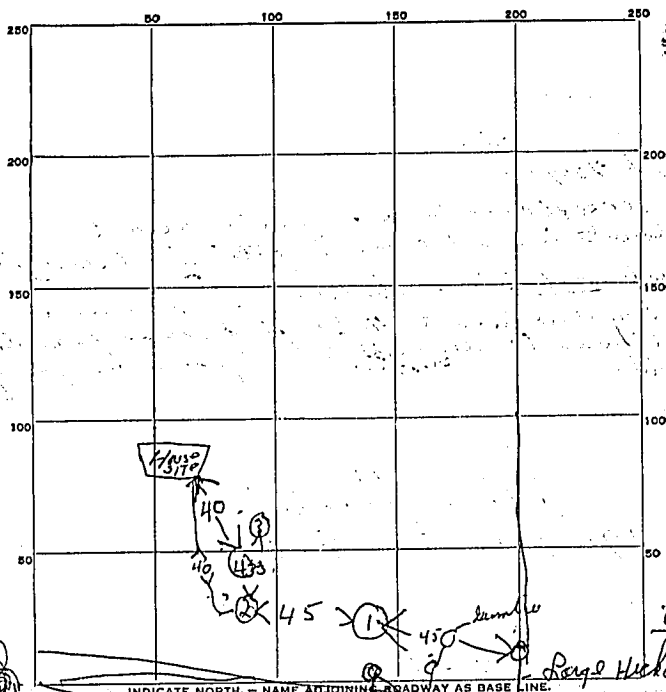

INDICATE NORTH. - NAME ADJOINING ROADWAY AS BASE LINE.

DATE	TEST NO.	DEPTH	PRE-WET		TEST - 1" DROP		TIME
			START	STOP	START	STOP	
6-5-67	1	3	311	322	322	347	25
	2	3	312				
	3	3	313				
6-12-67	4	8	2:58	302	302	310	310

SOIL AUGER FINDING _____
 TESTED BY DWM 6-5-67 DWM 6-12-67
 REMARKS first 4-ft is clay
 ALSO PRESENT Arthur L. Slowe LOT NO. _____