

Approved 12/28/83  
Stayed  
P 33257  
A 30901

12/21/83  
300 Inad

# PERMIT

SEWAGE DISPOSAL SYSTEM

MARYLAND STATE DEPARTMENT OF HEALTH

HOWARD COUNTY  
BUREAU OF ENVIRONMENTAL HEALTH  
992-2330

03-294455

ELLICOTT CITY  
DISTRICT 3rd

DATE Oct 24, 1983

INDEX

Foremost Industries, Inc. IS PERMITTED TO INSTALL  ALTER   
ADDRESS 3222 Rosemary Lane, West Friendship, MD 21794 PHONE (301) 829-0886  
SUBDIVISION Rosemary Estates ROAD <sup>3222</sup> Rosemary Lane LOT 12  
PROPERTY OWNER ~~Thomas & Janet Sweeney~~ Don & Anita Logan  
ADDRESS 3716 Ellerslie Road, Baltimore, MD 21218

IF GARBAGE GRINDER IS USED INCREASE SEPTIC TANK CAPACITY BY 50% AND ABSORPTION AREA BY 22%.

GARBAGE GRINDER? YES  NO   
SEPTIC TANK CAPACITY 1000 GALLONS NUMBER OF BEDROOMS 3

~~BLDG PERMIT SKIPPED AND RETURNED~~  
10/28/83  
detached garage


Trenches to be 2 ft. wide. Inlet to be 4 ft. below original grade, and effective absorbant area from 6 1/2 ft. - 9 1/2 ft. only. Maximum depth of trenches to be 9 1/2 ft. below grade. A minimum of 180 sq. ft. effective absorbant sidewall area per bedroom needed. Trenches can not exceed 100 ft. in length. Distribution box to be used if more than 1 trench used. Two inspections of trenches required - before and after stone installed. If more than 1 trench used - need to have 15 ft. distance between trenches, center to center. Run trenches on contour. LOCATION: Start trenches ~~at~~ at a point 100 ft. down from corner point of lines (505.76 ft. - N10°48'39"W) and line (370.2' - N41°00'41"E) and 16 ft. in form line 505.76 ft. -(N10°48'39"W)

PLANS APPROVED BY Charles B. Streaker DATE 10/8/80

COVER NO WORK UNTIL INSPECTED AND APPROVED.  
NEITHER THE HOWARD COUNTY COUNCIL NOR THE HEALTH DEPARTMENT IS RESPONSIBLE FOR THE SUCCESSFUL OPERATION OF ANY SYSTEM.  
NOTE: IF TRENCH IS USED CALL FOR INSPECTION BEFORE AND AFTER PLACING GRAVEL IN TRENCH.  
NOTE: NO DRY WELL SHALL EXCEED 15 FOOT IN DIAMETER. NO ABSORPTION TRENCH TO EXCEED 100 FEET IN LENGTH.  
NOTE: ALL PIPE FROM HOUSE TO SEPTIC TANK MUST BE CAST IRON OR SCHEDULE 40 PVC OR ABS.  
PERMIT VOID AFTER THREE YEARS.  
NOTE: INSTALL STAND PIPE ON SEPTIC TANK AND DRY WELL. STAND PIPES MUST BE 6 INCHES IN DIAMETER. CAST IRON, CONCRETE OR TERRA COTTA, OR PVC OR ABS ACCEPTED. IF TOP OF SEPTIC TANK IS DEEPER THAN 3 FEET MANHOLE TO GRADE REQUIRED.

~~BLDG PERMIT SKIPPED AND RETURNED~~  
4/21/00  
300123444  
detached garage  
30901

\*INSTALLER IS RESPONSIBLE FOR OBTAINING FINAL APROVAL ON THIS PERMIT

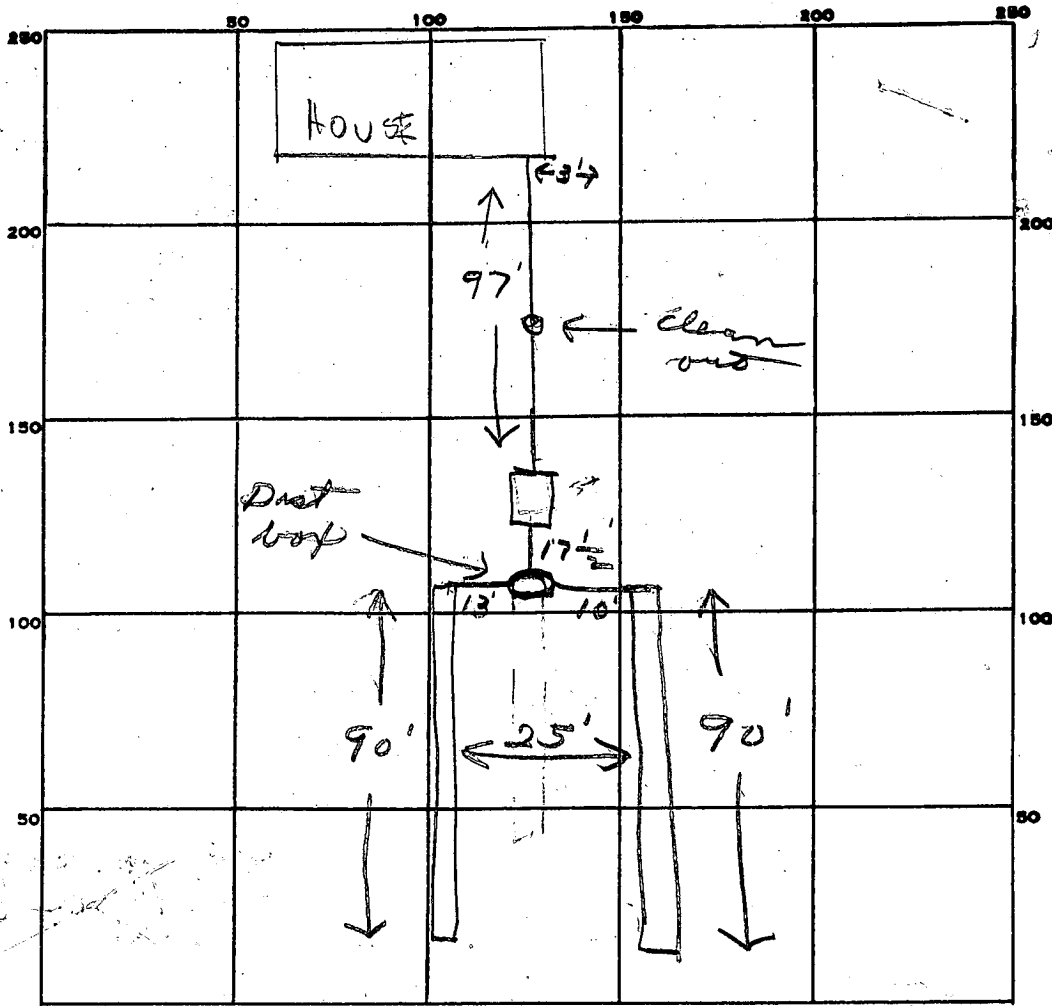

INDICATE NORTH. - NAME ADJOINING ROADWAY AS BASE LINE.

PERMIT CARD

SEPTIC TANK, LEVEL 1000 gal CLEANOUTS ST

DISTRIBUTION BOX, LEVEL

TILE FIELD, DEPTH 9 1/2 FT. TRENCH WIDTH 2 FT.

GRAVEL DEPTH 5 1/2 IN. TOTAL LENGTH 1 FT.

NUMBER OF TRENCHES 2 TOTAL BOTTOM AREA 540

180  
3  
540

SEEPAGE PITS, INSIDE DIAMETER \_\_\_\_\_ FT. DEPTH BELOW INLET \_\_\_\_\_ FT.

ABSORBENT AREA 540 SQ. FT.

REMARKS 1<sup>st</sup> TRENCH OK TO ADD GRAVEL CWP 12-21-83

12/27/83 OK to cover all work JS

DATE SYSTEM APPROVED 12/28/83 INSPECTOR Jim Stayer

# APPLICATION

SEWAGE DISPOSAL TESTING

STATE OF MARYLAND - DEPARTMENT OF HEALTH AND MENTAL HYGIENE

A 30901

P \_\_\_\_\_

HOWARD COUNTY HEALTH DEPARTMENT  
ENVIRONMENTAL HEALTH SERVICES

P.O. BOX 476 ELLICOTT, MARYLAND 21043  
TELEPHONE: 992-2330

DISTRICT 3RD.

DATE SEPT. 10, 1980

TO: THE COUNTY HEALTH OFFICER  
ELLICOTT CITY, MARYLAND

I HEREBY APPLY FOR THE NECESSARY TEST IN ORDER TO CONSTRUCT (OR RECONSTRUCT) A SEWAGE DISPOSAL SYSTEM.

PROPERTY OWNER JOHN MIKOLASKO

ADDRESS 2205 FOXLEY ROAD TIMONIUM MARYLAND PHONE \_\_\_\_\_

PROPERTY LOCATION:

SUBDIVISION ROSE MARY ESTATES LOT NO. 12

ROAD AND DESCRIPTION 250' ± FROM INTERSECTION OF RTE 32 AND ROSE MARY LANE

SIZE OF LOT 6.519 AC. ± TYPE BLDG. SINGLE FAMILY

THE SYSTEM INSTALLED UNDER THIS APPLICATION IS ACCEPTABLE ONLY UNTIL PUBLIC FACILITIES BECOME AVAILABLE.

I FULLY UNDERSTAND THE FEE CONNECTED WITH THE FILING OF THIS PERC TEST APPLICATION IS NON-REFUNDABLE UNDER

ANY CIRCUMSTANCES:

SIGNATURE OF APPLICANT Charles J. Green

APPROVED BY \_\_\_\_\_ FOR \_\_\_\_\_ DATE \_\_\_\_\_

REJECTED BY \_\_\_\_\_ FOR \_\_\_\_\_ DATE \_\_\_\_\_

HOLD/PENDING FURTHER TESTS \_\_\_\_\_ DATE \_\_\_\_\_

REASONS FOR REJECTION OR HOLDING 7/16/80 (1) CERTIFIED HOLES, (2) HOUSE SITE, WELL SITE

(4) CONTOURS OF LOT.

C.B.S. & S.K.

# THIS IS NOT A PERMIT


# 12

SOIL PROFILE

SEE EACH HOLE BELOW



FIELD SHEET

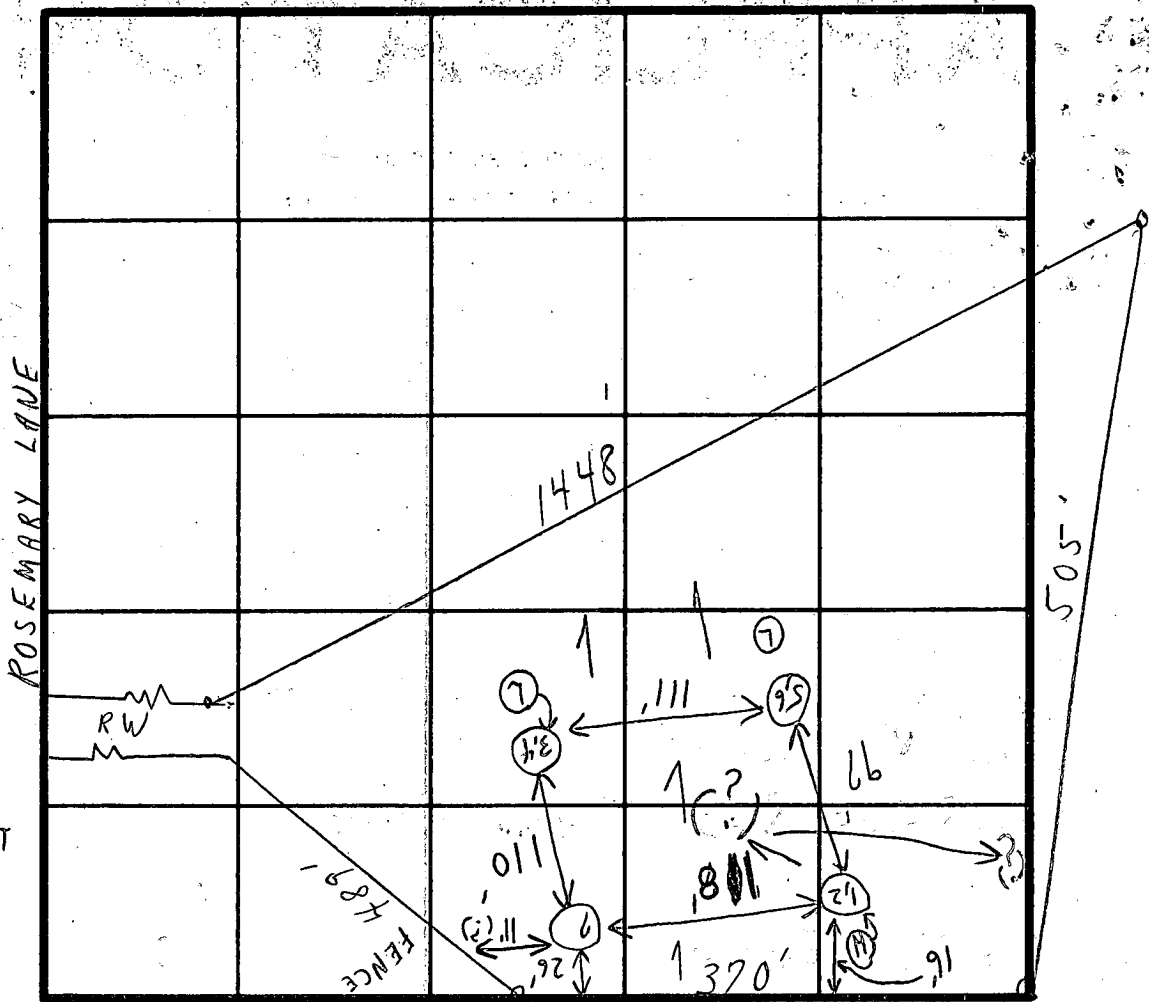

INDICATE NORTH - NAME ADJOINING ROADWAY AS BASE LINE.

SOIL PROFILE

	DATE	TEST NO.	DEPTH	PRE-WET		RT 30 TEST - 1" DROP		TIME
				START	STOP	START	STOP	
1'- 8 1/2' CLAY	9/16/80	1A	4'	11:20	11:44	11:44	11:52	PULL ED @ SLOW PERC
6 1/2' 12'-2" SANDY LOAM		(H) 2	12'-8"	11:23	11:27	11:27	11:37	10 min dry to 15'
1'- 4' CLAY		3	4' x	11:10	11:20	11:20	11:34	14 min
4'- 13' MICA SANDY LOAM		(L) 4	13' x	11:11	11:20	11:20	11:45	25 min
1'- 3 1/2' CLAY		5	3 1/2'	11:32	11:43	11:43	12:10	27 min
3 1/2'- 12' LOAM.		(L) 6	12'	11:32	11:35	11:35	11:50	15 min
1'- 4' CLAY		TEST @ 7 4 1/2	4 1/2'-12'	12:08	12:15	12:15	12:33	18 min
4 1/2'- 12' LOAM		1B	5'-5"	12:05	12:21	12:21	12:38	12:38 8 1/4" moist
TESTS @ 9'		1C	6 1/2'-7'	12:45	12:47	12:47	12:51	4 min

REMARKS: (?) ON LOCATION COPY GIVEN MR CROVO TESTS IN WOODS OF HOLES (HOLD FOR CERTIFIED HOLES) + HEAVY BRUSH HOUSE SITE, WELL SITE SHOW CONTOURS DENNIS RUSD

TYPE OF SOIL: \_\_\_\_\_

TESTED BY: C.B.S. + S.K. ALSO PRESENT: CROVO, K. HATFIELD + ASST.

0756

SEQUENCE NO. (OEP USE ONLY)

STATE OF MARYLAND WELL COMPLETION REPORT

THIS REPORT MUST BE SUBMITTED WITHIN 45 DAYS AFTER WELL IS COMPLETED.

COUNTY NUMBER A 30901

(THIS NUMBER IS TO BE PUNCHED IN COLS. 3-6 ON ALL CARDS)

DATE RECEIVED DATE WELL COMPLETED 09/15/83 DEPTH OF WELL 160 FROM PERMIT TO DRILL WELL HO-81-0168

OWNER Sweeney Tom STREET OR RFD Rosemary Lane TOWN West Friendship SUBDIVISION Rosemary Estates SECTION LOT 12

WELL LOG table with columns: DESCRIPTION, FEET FROM, FEET TO. Includes entries for Topsoil, Brown Mica, Tan Mica, Gray Mica, Mica schist, etc.

GROUTING RECORD YES (Y) NO (N) TYPE OF GROUTING MATERIAL CEMENT (CM) BENTONITE CLAY (BC) NO. OF BAGS 9 NO. OF POUNDS 900

CASING RECORD STEEL (ST) CONCRETE (CO) PLASTIC (PL) OTHER (OT) MAIN CASING TYPE (ST) NOMINAL DIAMETER 6 INCH TOTAL DEPTH 33 FEET

OTHER CASING (if used) diameter inch depth (feet) from to

SCREEN RECORD STEEL (ST) BRASS (BR) OPEN HOLE (HO) BRONZE (PL) OTHER (OT) PLASTIC (PL) OTHER (OT)

DEPTH (nearest ft.) 40 33 160


SLOT SIZE 1 2 3 DIAMETER OF SCREEN (NEAREST INCH)

GRAVEL PACK IF WELL DRILLED WAS FLOWING WELL INSERT F IN BOX 68

OEP USE ONLY (NOT TO BE FILLED IN BY DRILLER) T (E.R.O.S.) WQ (74 75 76)

PUMPING TEST C 3 HOURS PUMPED 3 PUMPING RATE 60 to nearest gal. METHOD USED TO MEASURE PUMPING RATE BUCKET WATER LEVEL 25 BEFORE PUMPING 64 WHEN PUMPING TYPE OF PUMP USED (for test) C centrifugal S submersible

PUMP INSTALLED DRILLER WILL INSTALL PUMP YES (NO) IF DRILLER INSTALLS PUMP, THIS SECTION MUST BE COMPLETED FOR ALL WELLS EXCEPT HOME USE. TYPE OF PUMP INSTALLED PLACE (A,C,J,P,R,S,T,O) IN BOX - SEE ABOVE: CAPACITY: GALLONS PER MINUTE (to nearest gallon) PUMP HORSE POWER PUMP COLUMN LENGTH (nearest ft.) CASING HEIGHT (circle appropriate box and enter casing height) + above } LAND SURFACE (nearest foot) - below }

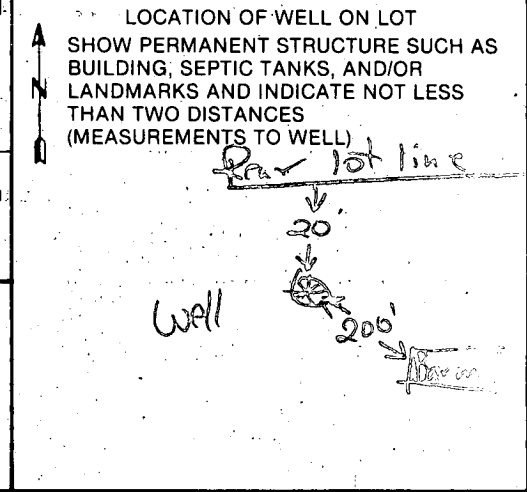

CIRCLE APPROPRIATE LETTER A A WELL WAS ABANDONED AND SEALED WHEN THIS WELL WAS COMPLETED E ELECTRIC LOG OBTAINED P TEST WELL CONVERTED TO PRODUCTION WELL


I HEREBY CERTIFY THAT THIS WELL HAS BEEN CONSTRUCTED IN ACCORDANCE WITH COMAR 10.17.13 "WELL CONSTRUCTION" AND IN CONFORMANCE WITH ALL CONDITIONS STATED IN THE ABOVE CAPTIONED PERMIT, AND THAT THE INFORMATION PRESENTED HEREIN IS ACCURATE AND COMPLETE TO THE BEST OF MY KNOWLEDGE.

DRILLERS IDENT. NO. DRILLERS SIGNATURE (MUST MATCH SIGNATURE ON APPLICATION) SITE SUPERVISOR (sign. of driller or journeyman responsible for sitework if different from permittee)

To Rosemary Lane

# ROSEMARY ESTATES LOT #12

6.45 Acres

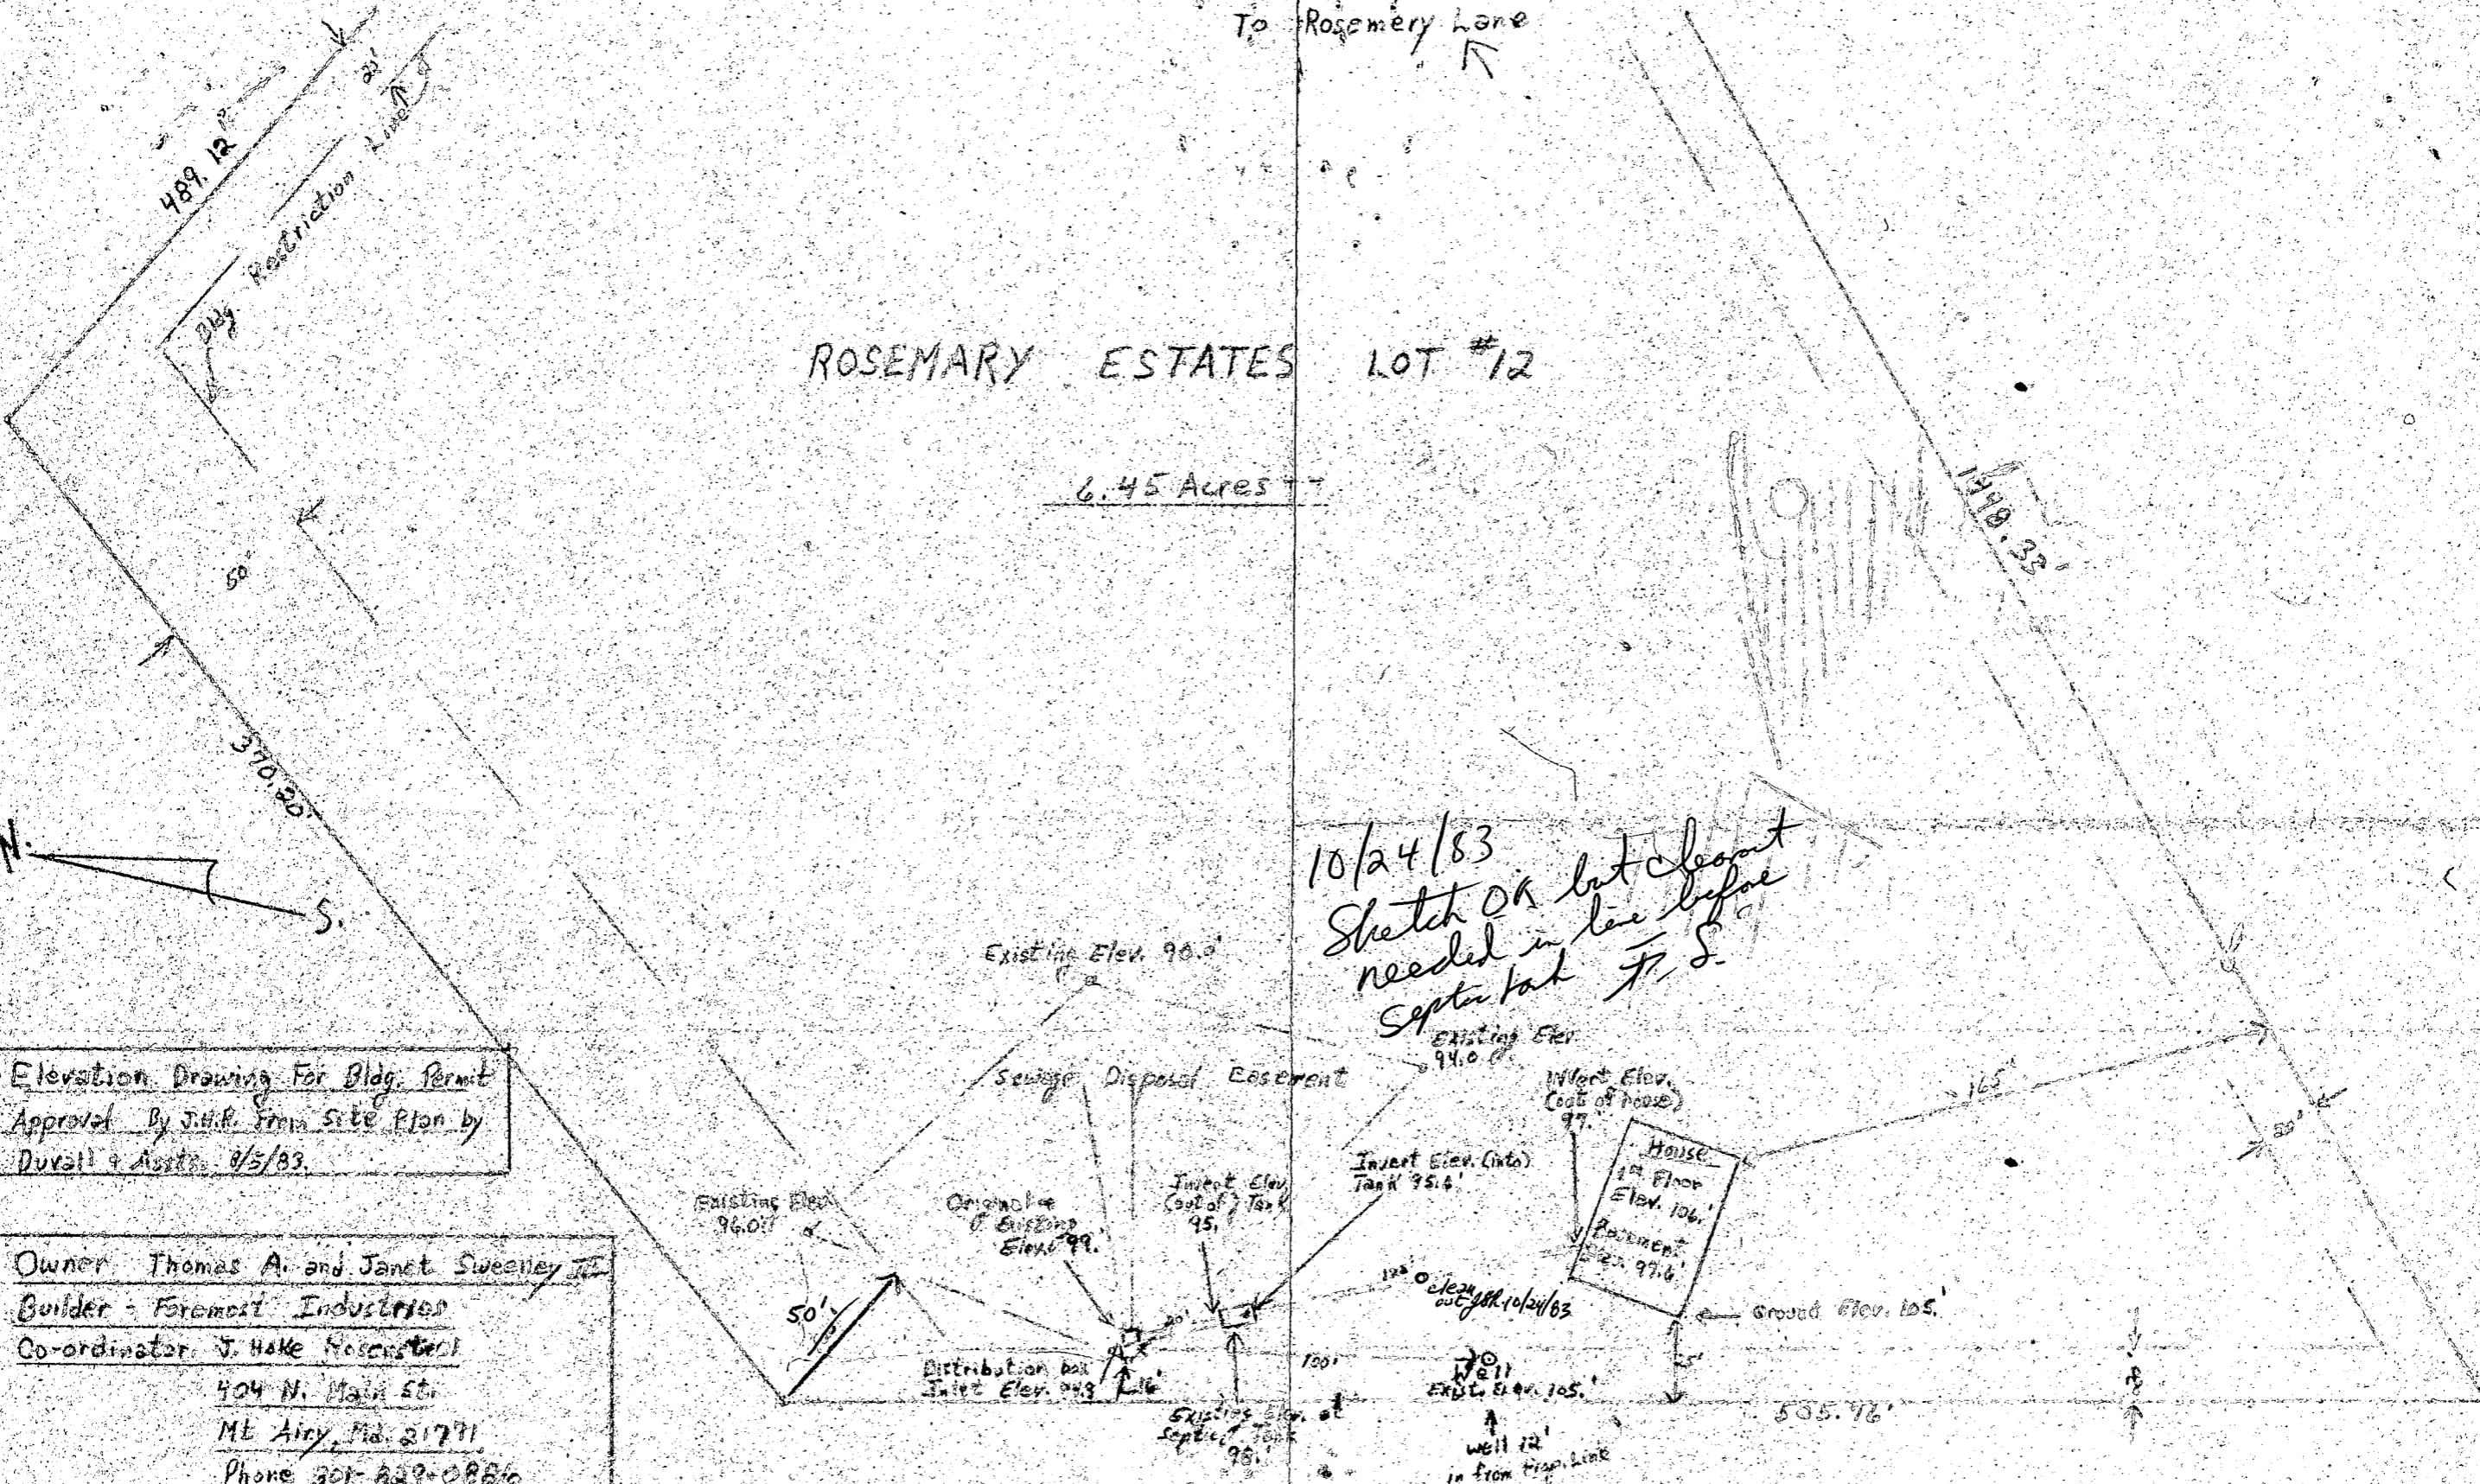


Elevation Drawing For Bldg. Permit  
 Approved By J.H.K. from Site Plan by  
 Duvall & Austin 8/5/83.

Owner: Thomas A. and Janet Sweeney  
 Builder: Foremost Industries  
 Co-ordinator: J. Hake Rosenbush  
 404 N. Main St.  
 Mt Airy, Md. 21771  
 Phone 301-829-0866

Date Oct. 20, 1983.

Scale ~~1/2" = 10'~~  
 1" = 50'

ROSEMARY LANE (Co)  
SHA PLAT 20493

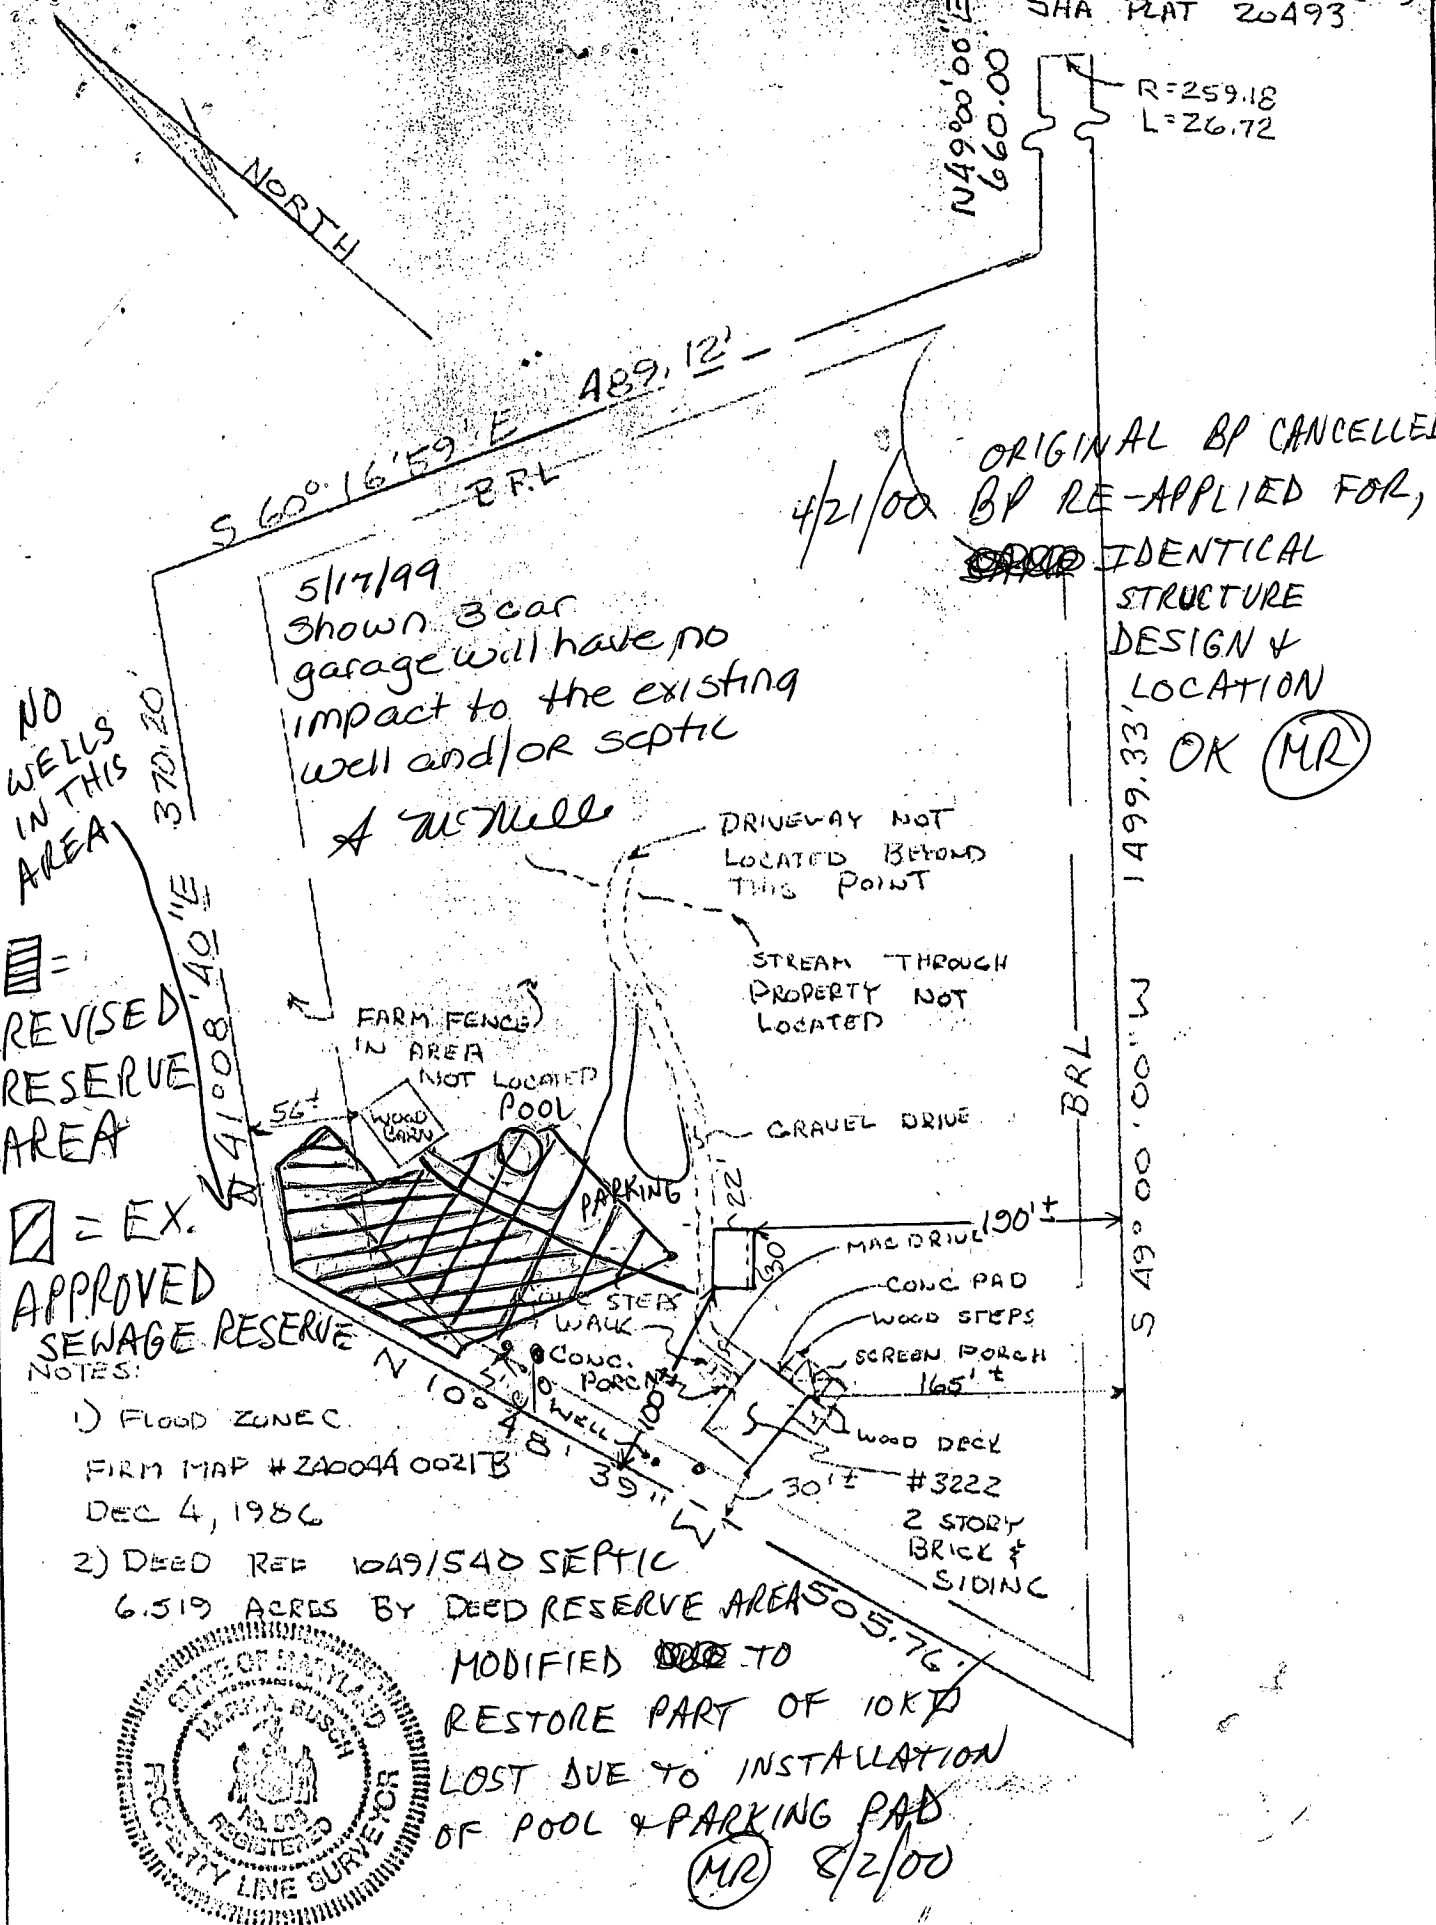

ORIGINAL BP CANCELLED;  
4/21/00 BP RE-APPLIED FOR,  
~~GOOD~~ IDENTICAL  
STRUCTURE  
DESIGN &  
LOCATION  
OK (MR)

NO  
WELLS  
IN THIS  
AREA

5/17/99  
Shown 3 car  
garage will have no  
impact to the existing  
well and/or septic

REVISÉD  
RESERVE  
AREA  
= EX.  
APPROVED  
SEWAGE RESERVE  
NOTES:

- 1) FLOOD ZONE C.
- FIRM MAP # 2A004A 0021B
- DEC 4, 1986
- 2) DEED REF 1049/540 SEPTIC
- 6.519 ACRES BY DEED RESERVE AREAS 505.76



MODIFIED ~~TO~~ TO  
RESTORE PART OF 10K  
LOST DUE TO INSTALLATION  
OF POOL & PARKING PAD  
(MR) 8/2/00

TITLE				LOCATION SURVEY				THIS IS TO CERTIFY THAT WE HAVE CONDUCTED A LOCATION SURVEY OF THE IMPROVEMENTS AND AND THAT THEY ARE LOCATED AS SHOWN HEREON.			
PROJECT				3222 ROSEMARY LANE				SIGNATURE <i>Mark A. Busch</i>			
LOCATION				3 <sup>RD</sup> ELECTION DISTRICT HOWARD CO., MD.				REG. NO. 508 DATE 12/09/93			
FIELD BOOK	PAGE NO.	DRAWN BY:	CHECKED BY:	DATE:							
		MAB		12/09/93							
SCALE				JOB NO.				<b>Boender Associates</b> <small>ENGINEERS PLANNERS SURVEYORS</small> 3230 BETHANY LANE ELLICOTT CITY, MD. 21042 (410) 465-7777 FAX: (410) 465-7968			
1" = 100'				93260							
THE INFORMATION ON THIS PLAT SHOWS ONLY THAT THE IMPROVEMENTS INDICATED HEREON ARE CONTAINED WITHIN THE CONFINES OF THE LOT UPON WHICH THEY ARE ERECTED. THIS PLAT IS NOT TO BE CONSTRUED AS, OR USED FOR THE ESTABLISHMENT OF PROPERTY LINES.											