

11/17/65

Approved  
11/17/65  
R.F.

# PERMIT

SEWAGE DISPOSAL SYSTEM

P 11177  
A 05225

MARYLAND STATE DEPARTMENT OF HEALTH

HOWARD COUNTY

ELLICOTT CITY

DISTRICT 4

INDEXED

DATE 11/8/65

Howard Pickett IS PERMITTED TO INSTALL X ALTER  
ADDRESS Watersville Rd., Mt. Airy, Md. PHONE 829-0543

A SEWAGE DISPOSAL SYSTEM LOCATED AT \_\_\_\_\_

SUBDIVISION \_\_\_\_\_ ROAD Duvall Rd. LOT \_\_\_\_\_

PROPERTY OWNER Arthur Goode

ADDRESS \_\_\_\_\_

SPECIFICATIONS - 2 bedrooms

DRAIN FIELD \_\_\_\_\_ DEPTH \_\_\_\_\_ FEET, BOTTOM AREA \_\_\_\_\_ SQ. FT.

SEEPAGE PITS \_\_\_\_\_ ABSORBENT SIDE-WALL AREA \_\_\_\_\_ SQ. FT.

SEPTIC TANK CAPACITY 750 GALLONS

FOR GARBAGE GRINDER, INCREASE DISPOSAL AREA 22% & TANK CAPACITY 50%.

OTHER Dry well - 300 sq. ft. absorbent sidewall area to begin below the inlet pipe. The first four ft. of original grade not to be included in sidewall area.


Place dry well about 40 to 60 ft. from the front of proposed house (off the right corner of house on you face from Duvall Rd.)

PLANS APPROVED BY Donald W. Monaghan DATE 6/12/62

FILL SEPTIC TANK AND DISTRIBUTION BOX WITH WATER BEFORE CALLING FOR AN INSPECTION. COVER NO WORK UNTIL INSPECTED AND APPROVED.

NEITHER THE HOWARD COUNTY COMMISSIONERS NOR THE HEALTH DEPARTMENT IS RESPONSIBLE FOR THE SUCCESSFUL OPERATION OF ANY SYSTEM.

A 05225

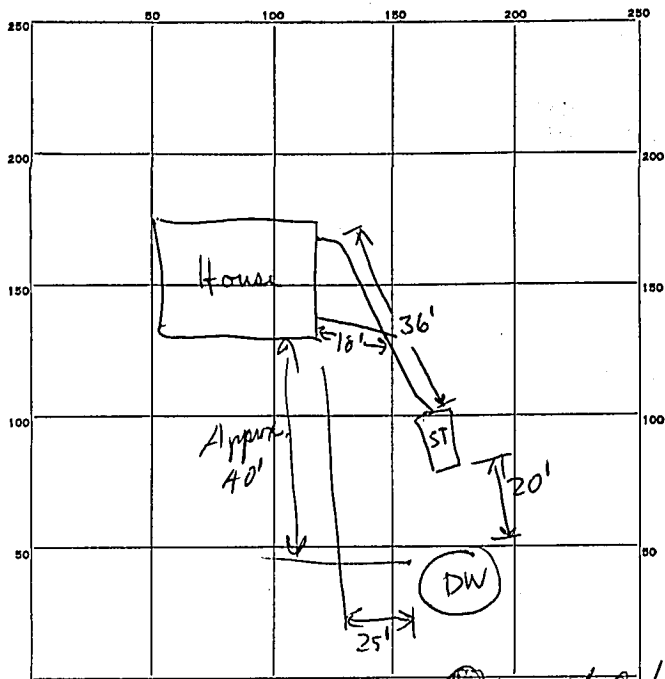

INDICATE NORTH - NAME ADJOINING ROADWAY AS BASE LINE

Drivall Rd  White Oak

PERMIT CARD OK

SEPTIC TANK, LEVEL OK

CLEANOUTS \_\_\_\_\_

DISTRIBUTION BOX, LEVEL \_\_\_\_\_

TILE FIELD, DEPTH \_\_\_\_\_ FT. TRENCH WIDTH \_\_\_\_\_ FT.

GRAVEL DEPTH \_\_\_\_\_ IN. TOTAL LENGTH \_\_\_\_\_ FT.

NUMBER OF TRENCHES \_\_\_\_\_ TOTAL BOTTOM AREA \_\_\_\_\_

SEEPAGE PITS, INSIDE DIAMETER 12 1/2 FT. DEPTH BELOW INLET 8 FT.

ABSORBENT AREA 320 SQ. FT.

REMARKS 11/17/65 (pipe from tank to deepwell in, cleanout  
on/in.) R.F. (Location OK)

10:15 A.M.

11/17/65 - (Pipe in) OK - R.F  
(Cleanout on)

11/17/65

R.F. Fletcher