

1/26/72
after 2 PM

15
16
31

62
55

app. 1-27-72
Durr

PERMIT

SEWAGE DISPOSAL SYSTEM

P 16650

A 16325

MARYLAND STATE DEPARTMENT OF HEALTH

HOWARD COUNTY

ELLICOTT CITY

INDEXED

DISTRICT 4

DATE 1/7/72

Riviera Isles Plumbing & Heating IS PERMITTED TO INSTALL X ALTER

ADDRESS Box 301, Ft. Smallwood Rd., Pasadena, Md. 21122 PHONE 255-4145

A SEWAGE DISPOSAL SYSTEM LOCATED AT _____

SUBDIVISION _____ ROAD Duvall Rd. LOT 2

PROPERTY OWNER Lon Titus (see original application for better directions)

ADDRESS _____

SPECIFICATIONS - 4 bedrooms

DRAIN FIELD _____ DEPTH _____ FEET, BOTTOM AREA _____ SQ. FT.

SEEPAGE PITS _____ ABSORBENT SIDE-WALL AREA _____ SQ. FT.

SEPTIC TANK CAPACITY 1,200 GALLONS

FOR GARBAGE GRINDER, INCREASE DISPOSAL AREA 22% & TANK CAPACITY 50%.

OTHER Dry well - 552 sq. ft. absorbent sidewall area to begin below the first 4 ft. of non-absorbent ground. Max. depth permitted for dry well is 13 ft. below

original grade. Place dry well about 345 ft. from rear lot line and 102 ft. from left side line as seen when facing lot from Duvall Road.

NOTE: ALL PIPE FROM HOUSE TO SEPTIC TANK MUST BE CAST IRON.
PERMIT VOID AFTER THREE YEARS.


NOTE: INSTALL SRAND PIPE ON DRY WELL AND SEPTIC TANK.

PLANS APPROVED BY D. W. Monaghan DATE 9/30/71

FILL SEPTIC TANK AND DISTRIBUTION BOX WITH WATER BEFORE CALLING FOR AN INSPECTION. COVER NO WORK UNTIL INSPECTED AND APPROVED.

NEITHER THE HOWARD COUNTY COMMISSIONERS NOR THE HEALTH DEPARTMENT IS RESPONSIBLE FOR THE SUCCESSFUL OPERATION OF ANY SYSTEM.

A 16325

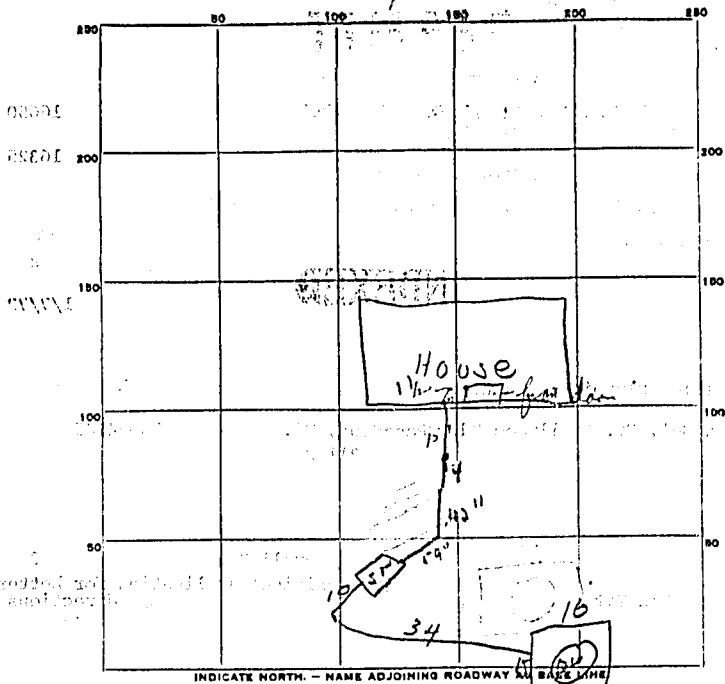

PERMIT CARD OK

SEPTIC TANK, LEVEL OK CLEANOUTS OK

DISTRIBUTION BOX, LEVEL _____

TILE FIELD, DEPTH _____ FT. TRENCH WIDTH _____ FT.

GRAVEL DEPTH _____ IN. TOTAL LENGTH _____ FT.

NUMBER OF TRENCHES _____ TOTAL BOTTOM AREA _____

SEEPAGE PITS INSIDE PERIMETER 62 FT. DEPTH BELOW INLET _____ FT.

ABSORBENT AREA _____ SQ. FT.

REMARKS 1-26-72 - pit unclogged - line from tank to Dig Well not in

DATE SYSTEM APPROVED 1-27-72 INSPECTOR DW Monaghan

